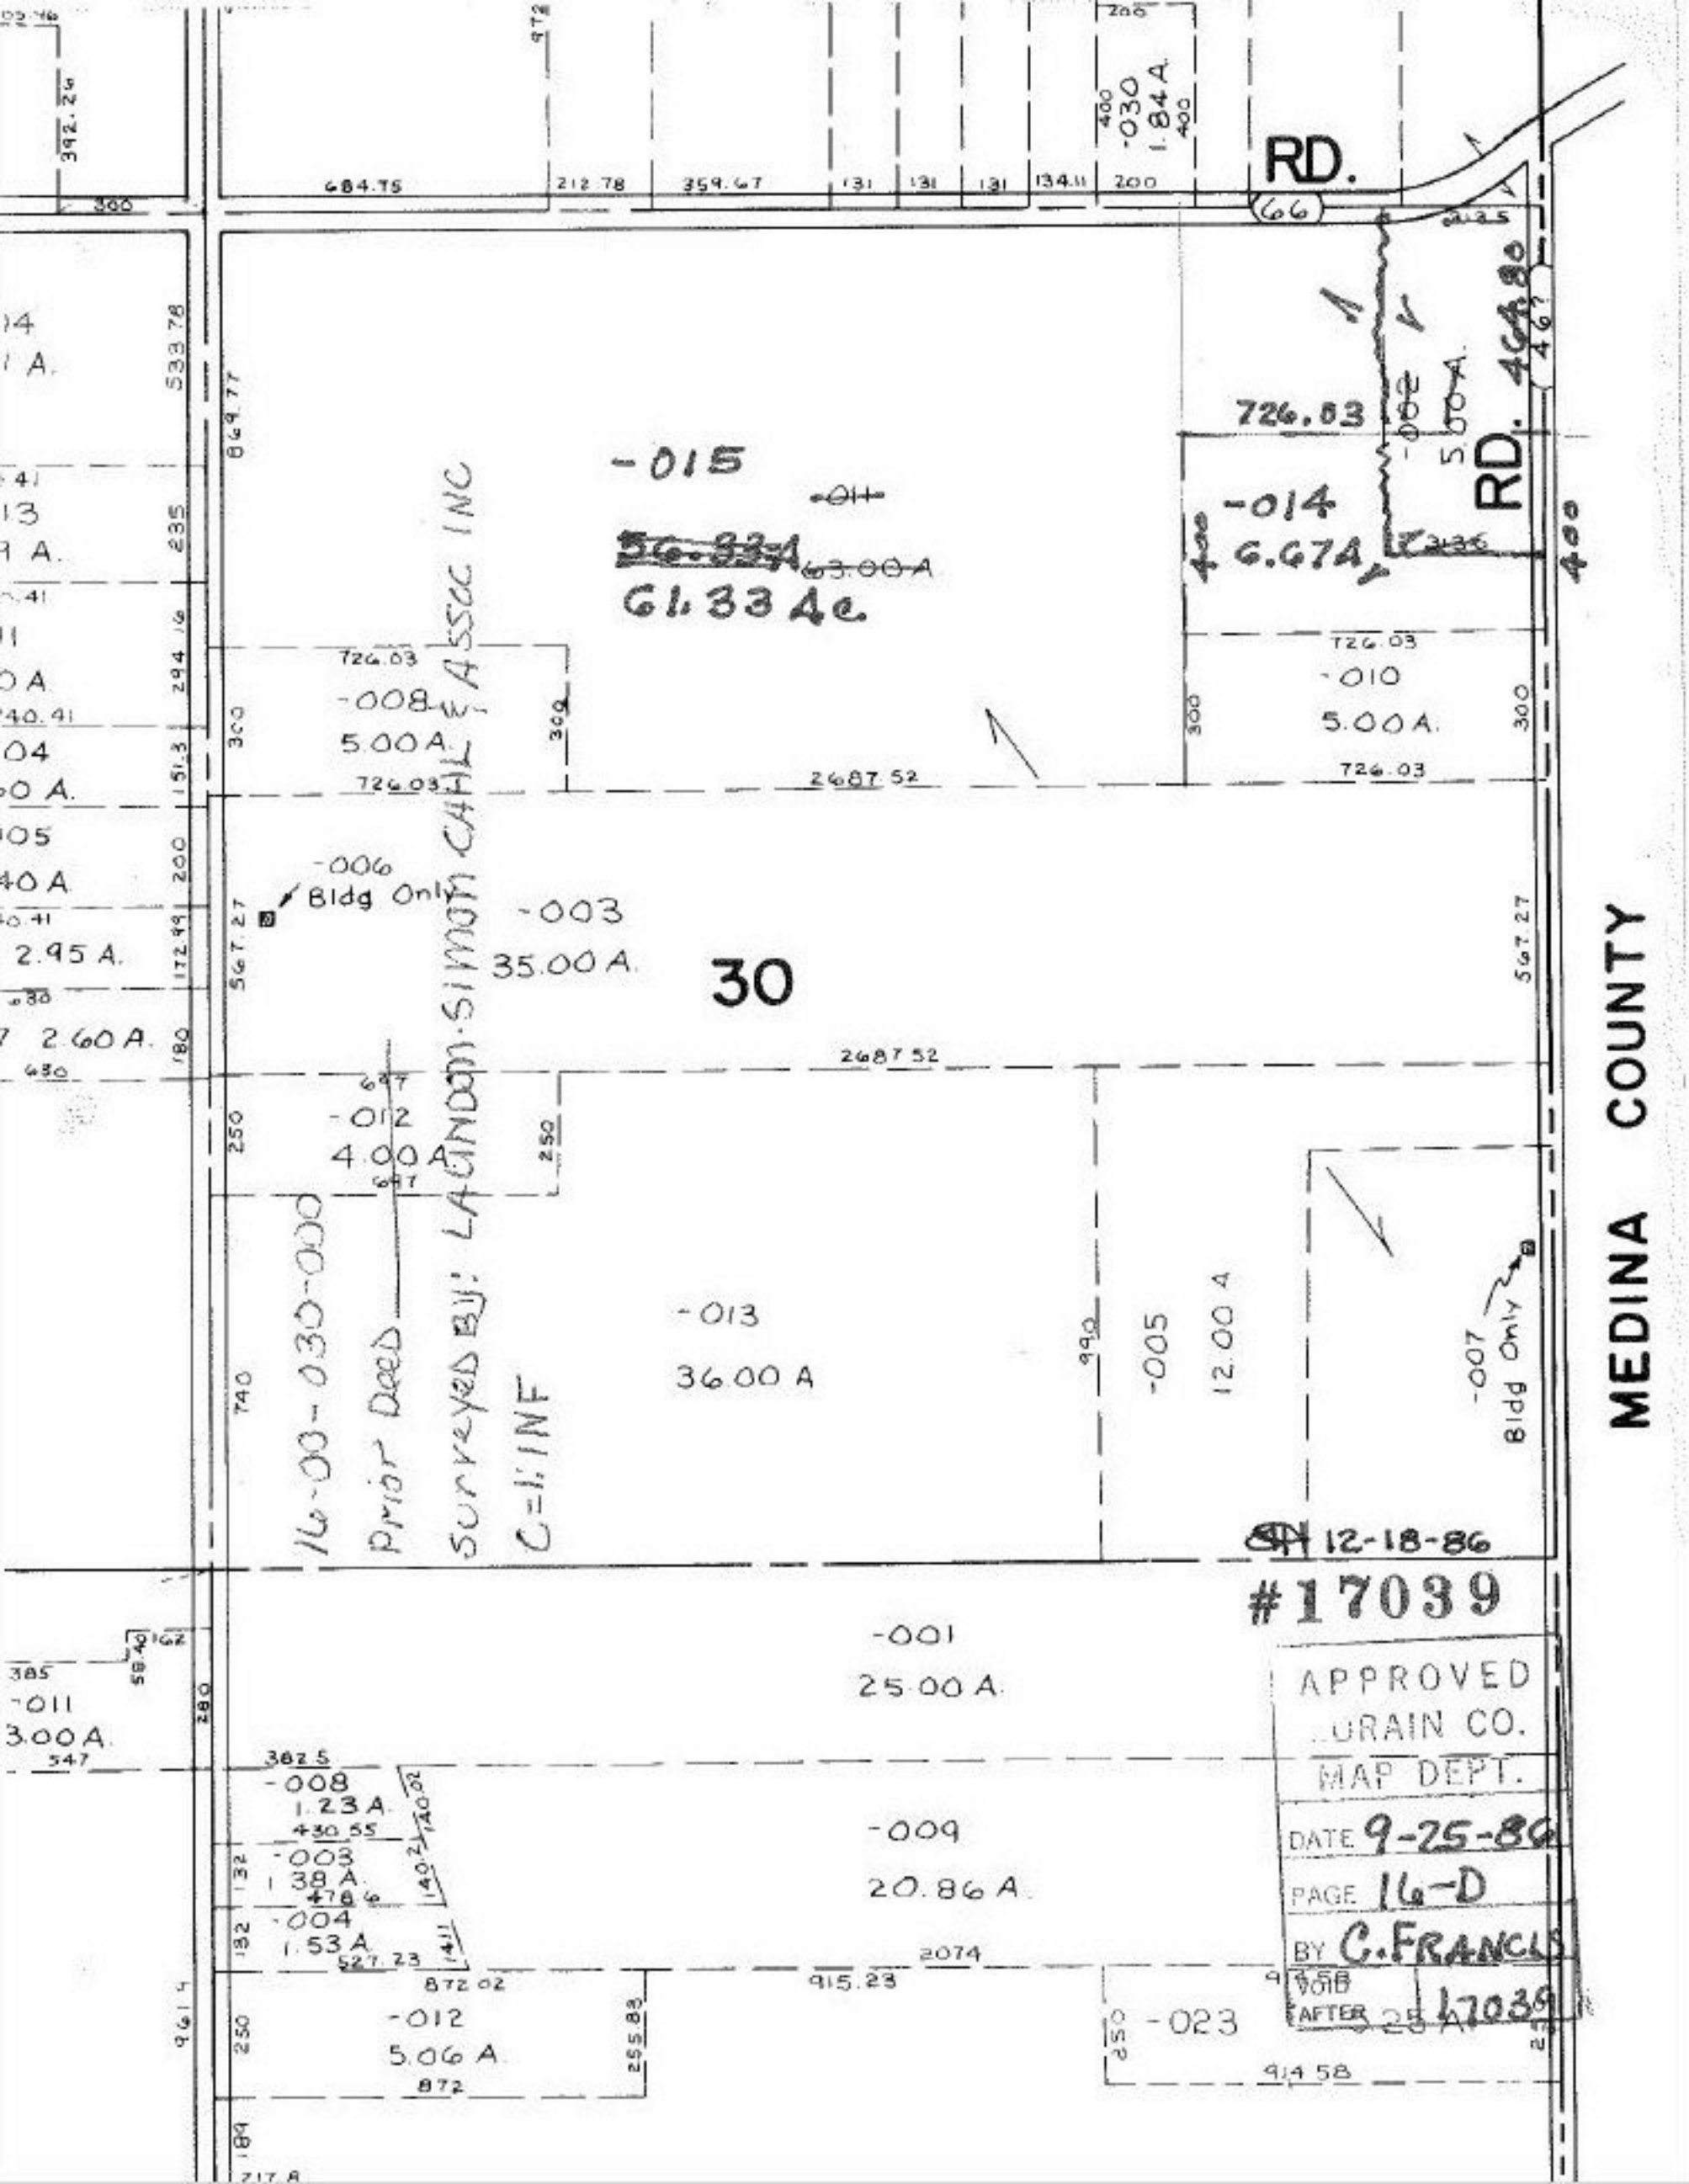

RD.
(66)
RD.
464.80
-030
1.84 A.
684.75
212.78
359.67
131
134.11
200
-015
~~-011~~
~~56.33A~~ ~~63.00A~~
61.33 Ac.
726.03
-014
6.67A
-002
5.00A.
-010
5.00A.
-008
5.00A.
2687.52
-006
Bldg Only
-003
35.00A.
30
-012
4.00A.
16-00-030-000
Prior Deed
Surveyed By: LAUNDON-SIMON CAHL & ASSOC INC
C=1:INF
-013
36.00 A
-005
12.00 A
-007
Bldg Only
MEDINA COUNTY
12-18-86
#17039
-001
25.00 A.
-011
3.00A.
-008
1.23 A.
-003
1.38 A.
-004
1.53 A.
-009
20.86 A.
-012
5.06 A.
-023
APPROVED
LORAIN CO.
MAP DEPT.
DATE 9-25-86
PAGE 16-D
BY C. FRANCIS
VOID AFTER 17039