


-026
1.49 Ac.

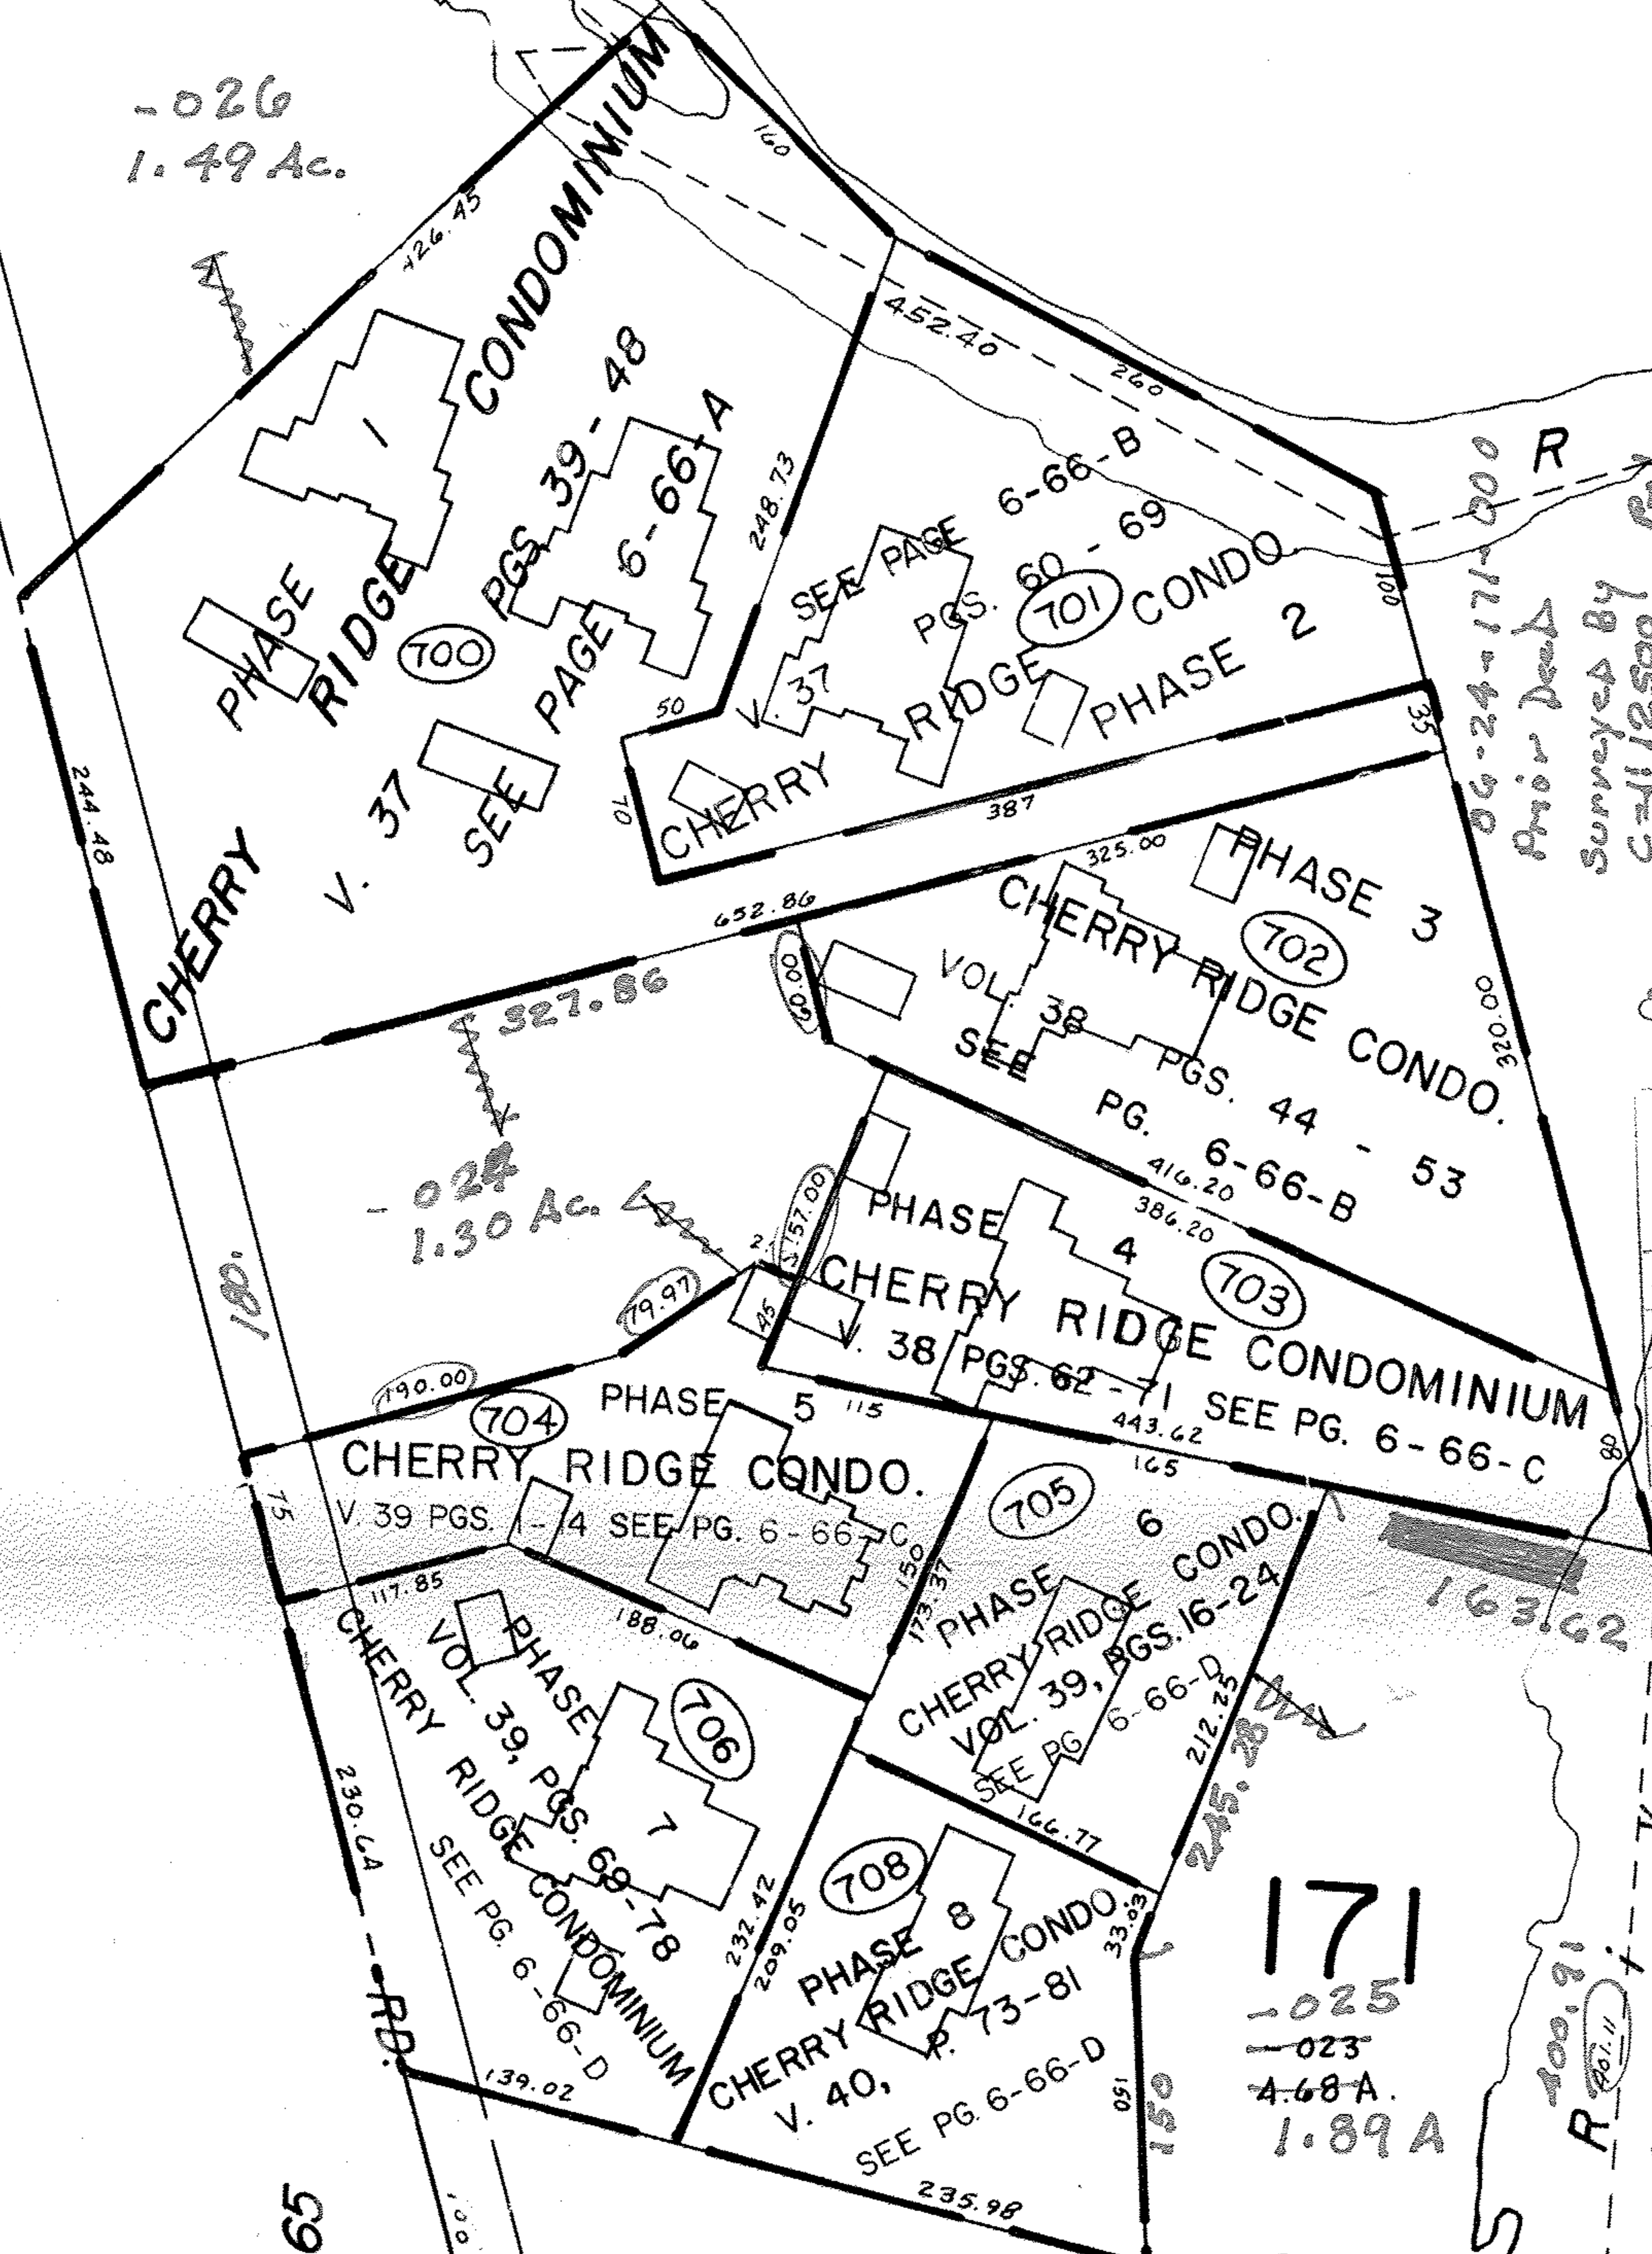

06-24-171-000 R
 Prior Deeds
 Surveyed By
 C-112500 P-1
 C-110000 P-1

10-7-86
 #17040
 APPROVED
 LORAIN CO.
 MAP DEPT.
 DATE 9-30-86
 PAGE 6-66
 BY C. FRANCIS
 VOID AFTER 17040

SEE 6-65

#17040
 APPROVED
 LORAIN CO.
 MAP DEPT.
 DATE 9-30-86
 PAGE 6-66
 BY C. FRANCIS
 VOID AFTER 17040

86.65
 68.81
 34.19

331.6
 365.79

244.48

180.

175

230.64

100

100

100

100

100

79.48

57.71

100

180.21

100

100

