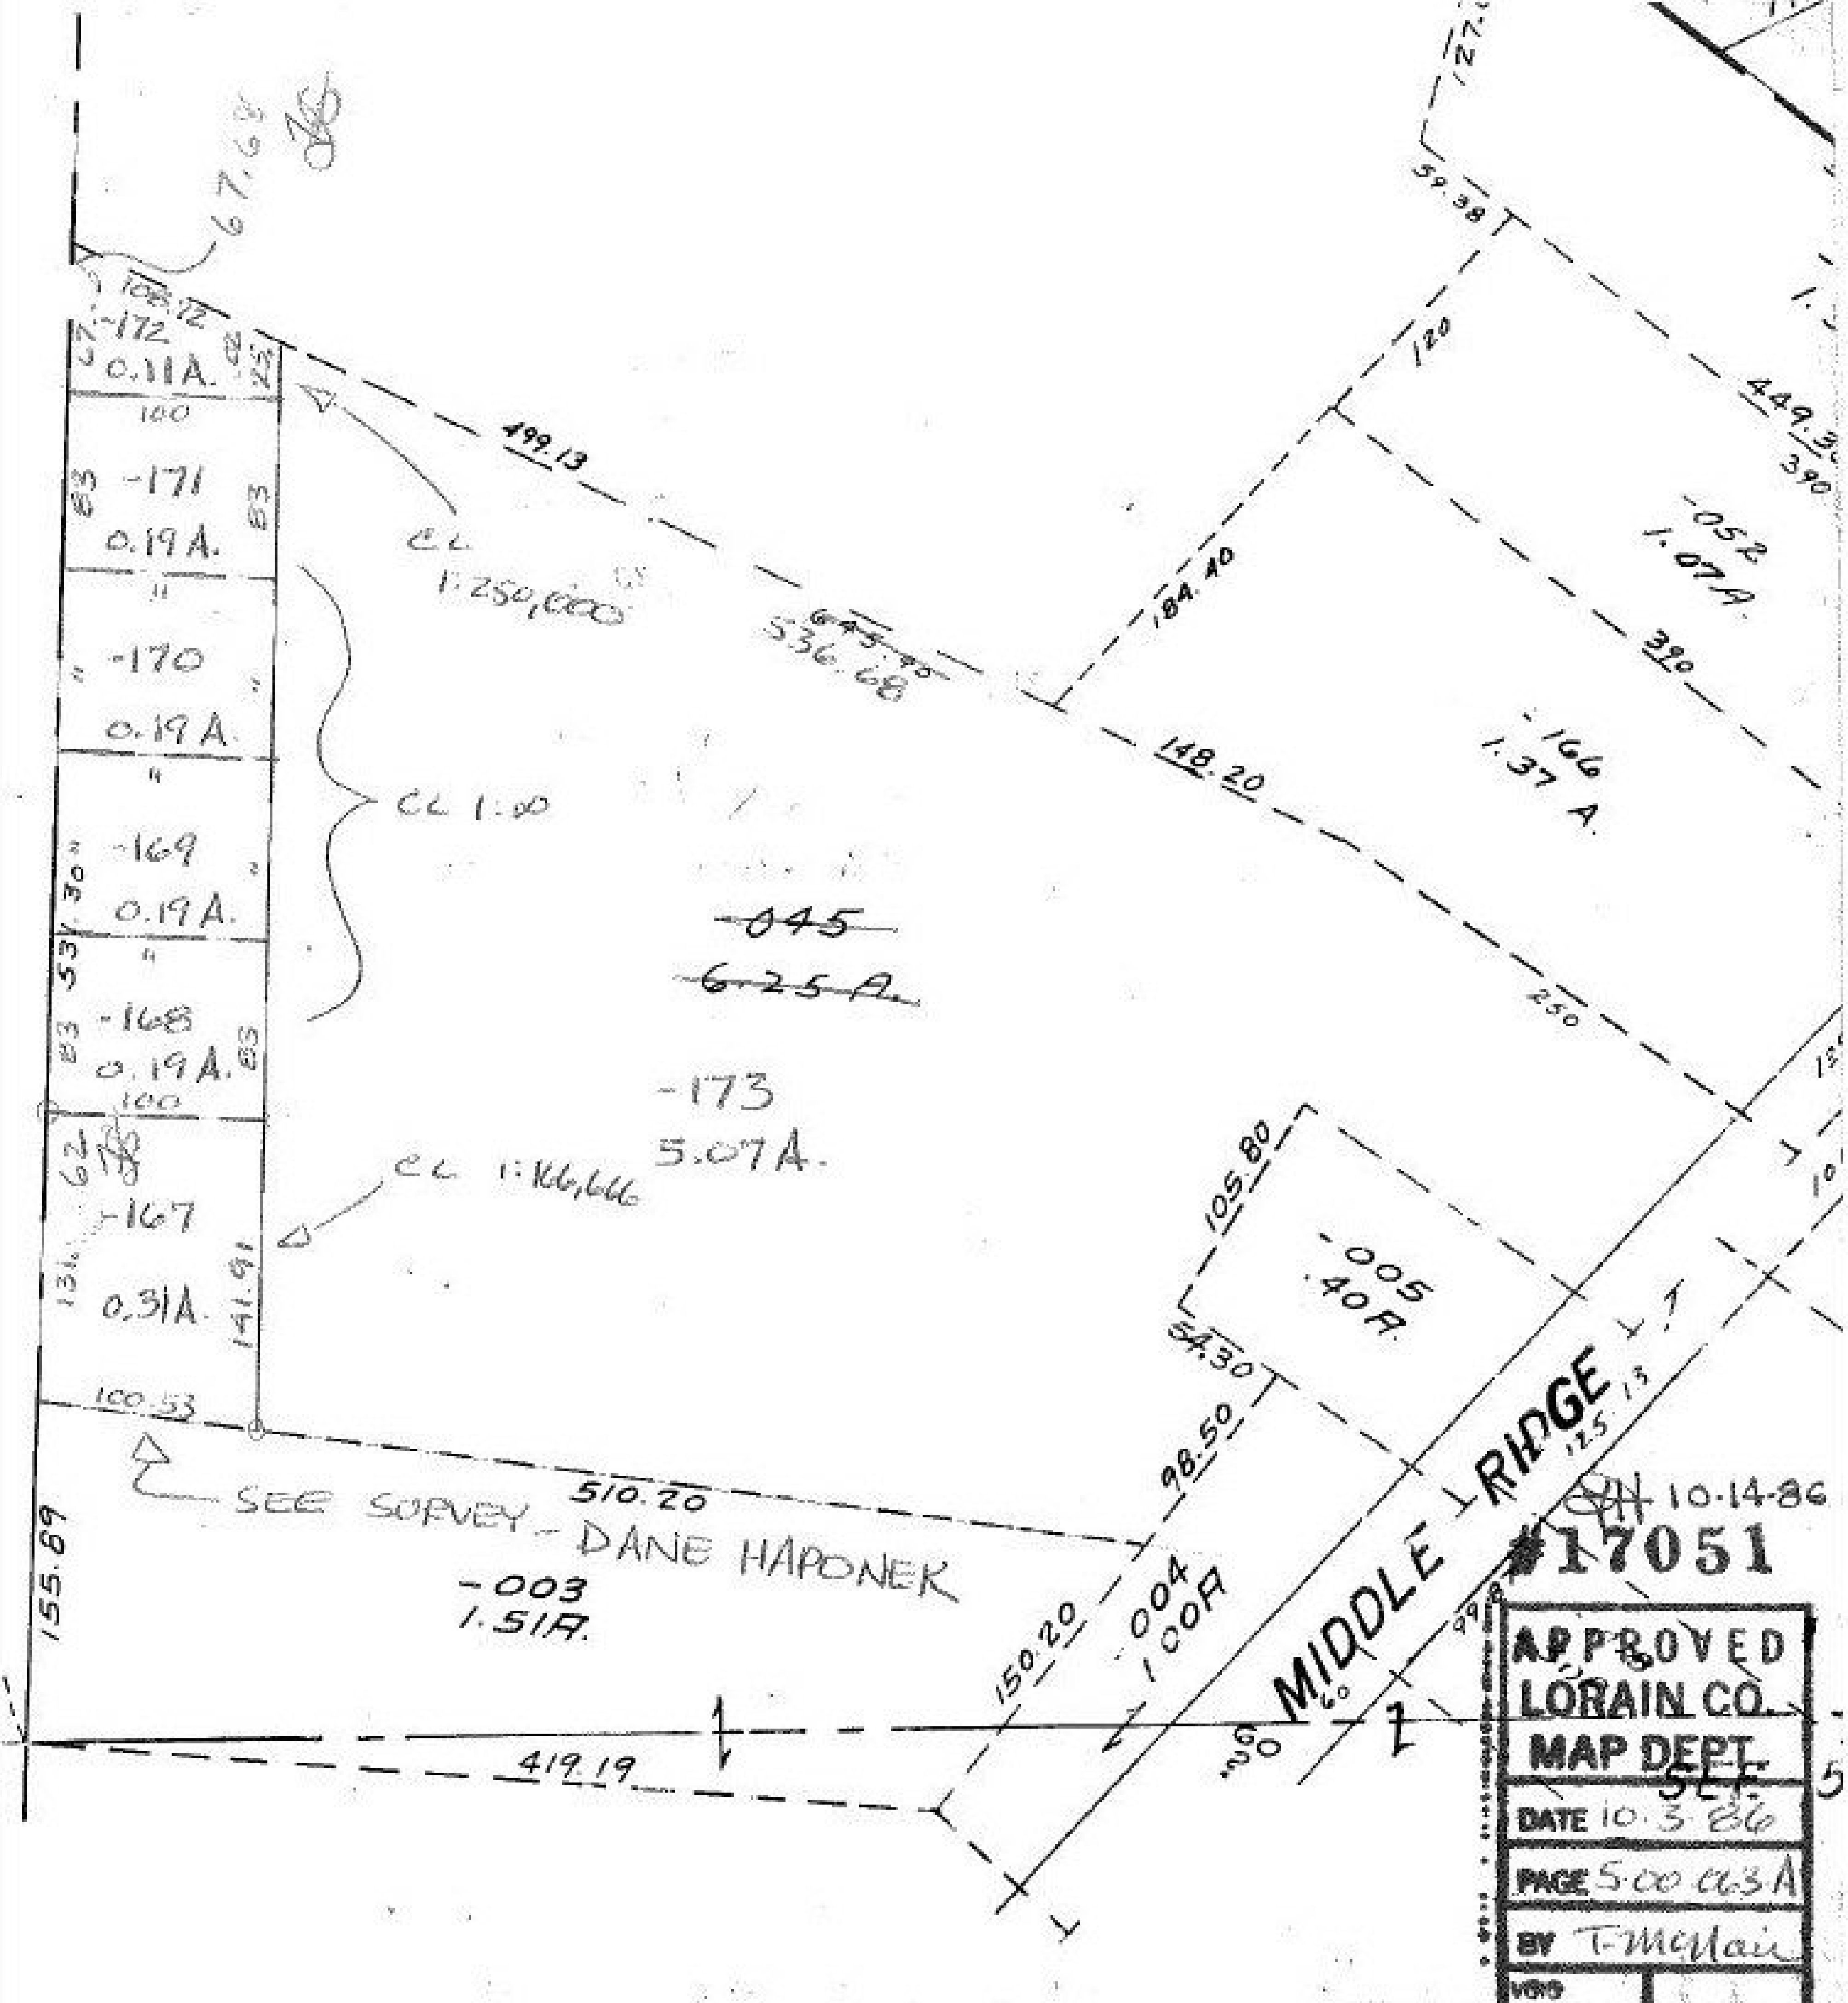

AMHER

W.LY PT. LOT 63

SCALE 1" = 100'