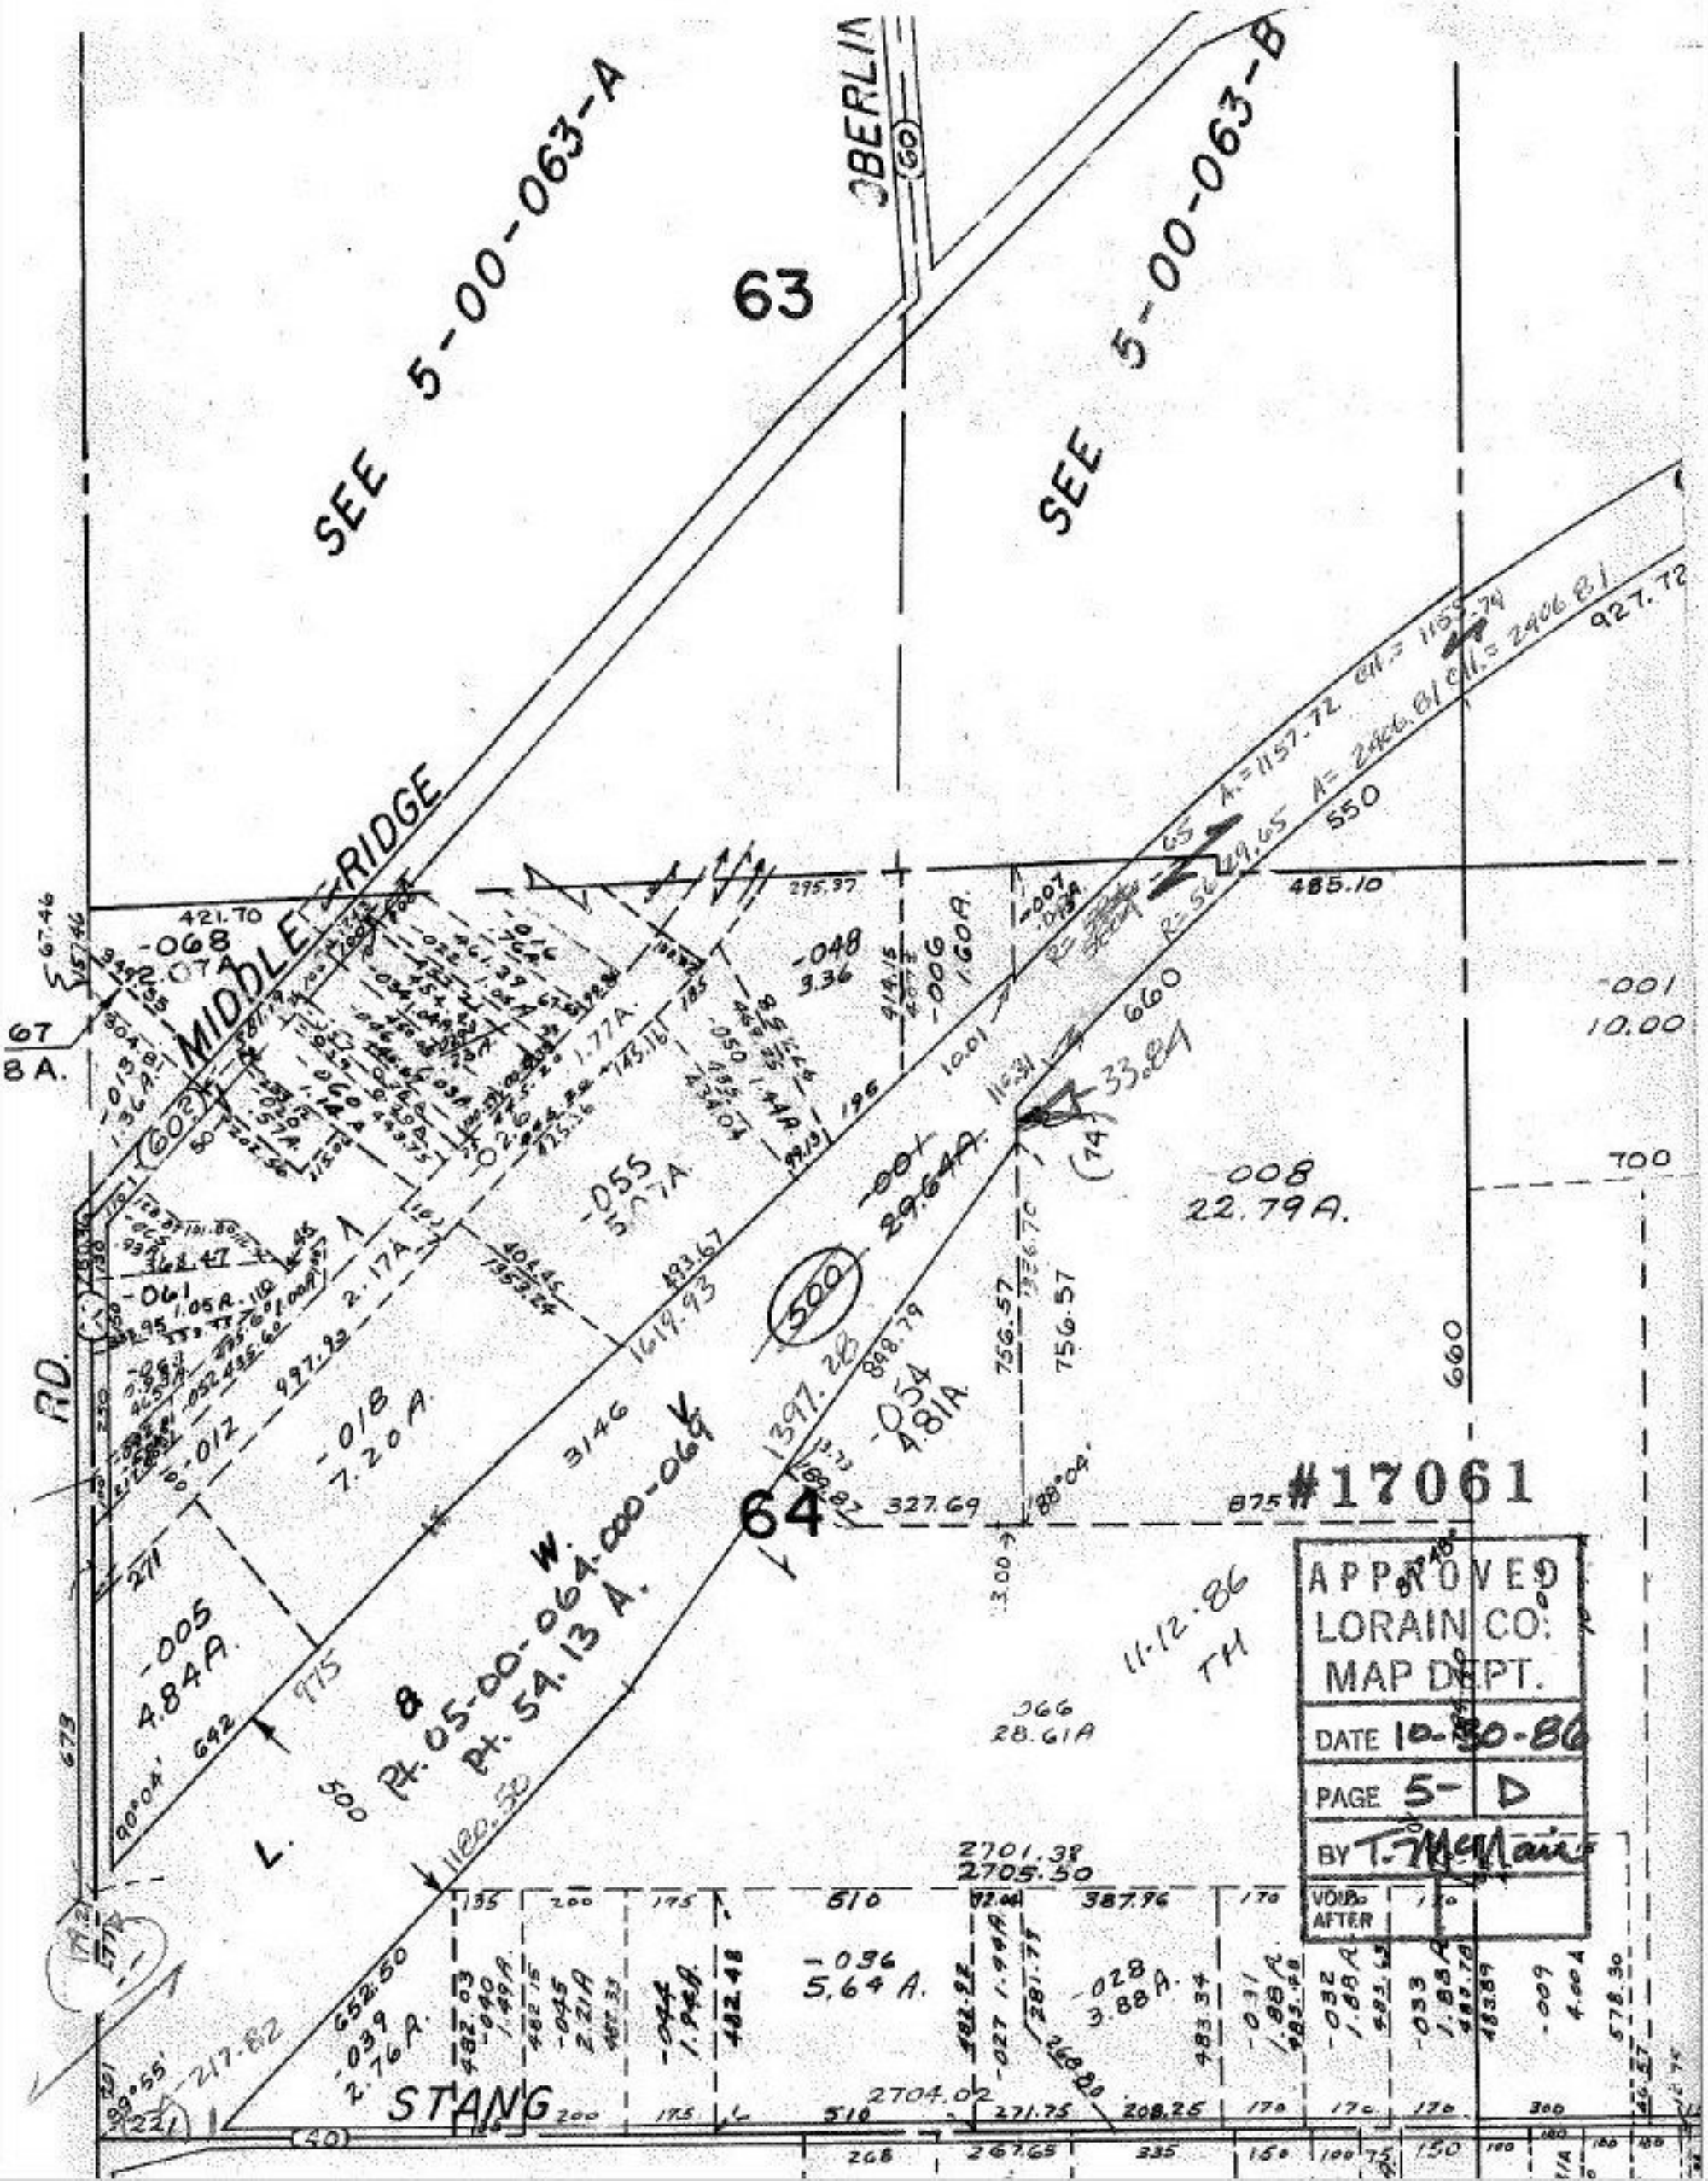

SEE 5-00-063-A
SEE 5-00-063-B
63
64
MIDDLE RIDGE
STANG
RD.
#17061
APPROVED
LORAIN CO.
MAP DEPT.
DATE 10-30-86
PAGE 5- D
BY T. McMain
VOID AFTER
11-12-86
TH
Pt. 05-00-064-000-064
Pt. 54.13 A.
-008
22.79A.
-055
5.07A.
-018
7.20A.
-005
4.84A.
-054
4.81A.
-036
5.64 A.
-028
3.88A.
-039
2.76A.
-048
3.36
-006
1.60A.
-001
29.64A.
-001
10.00
-066
28.61A