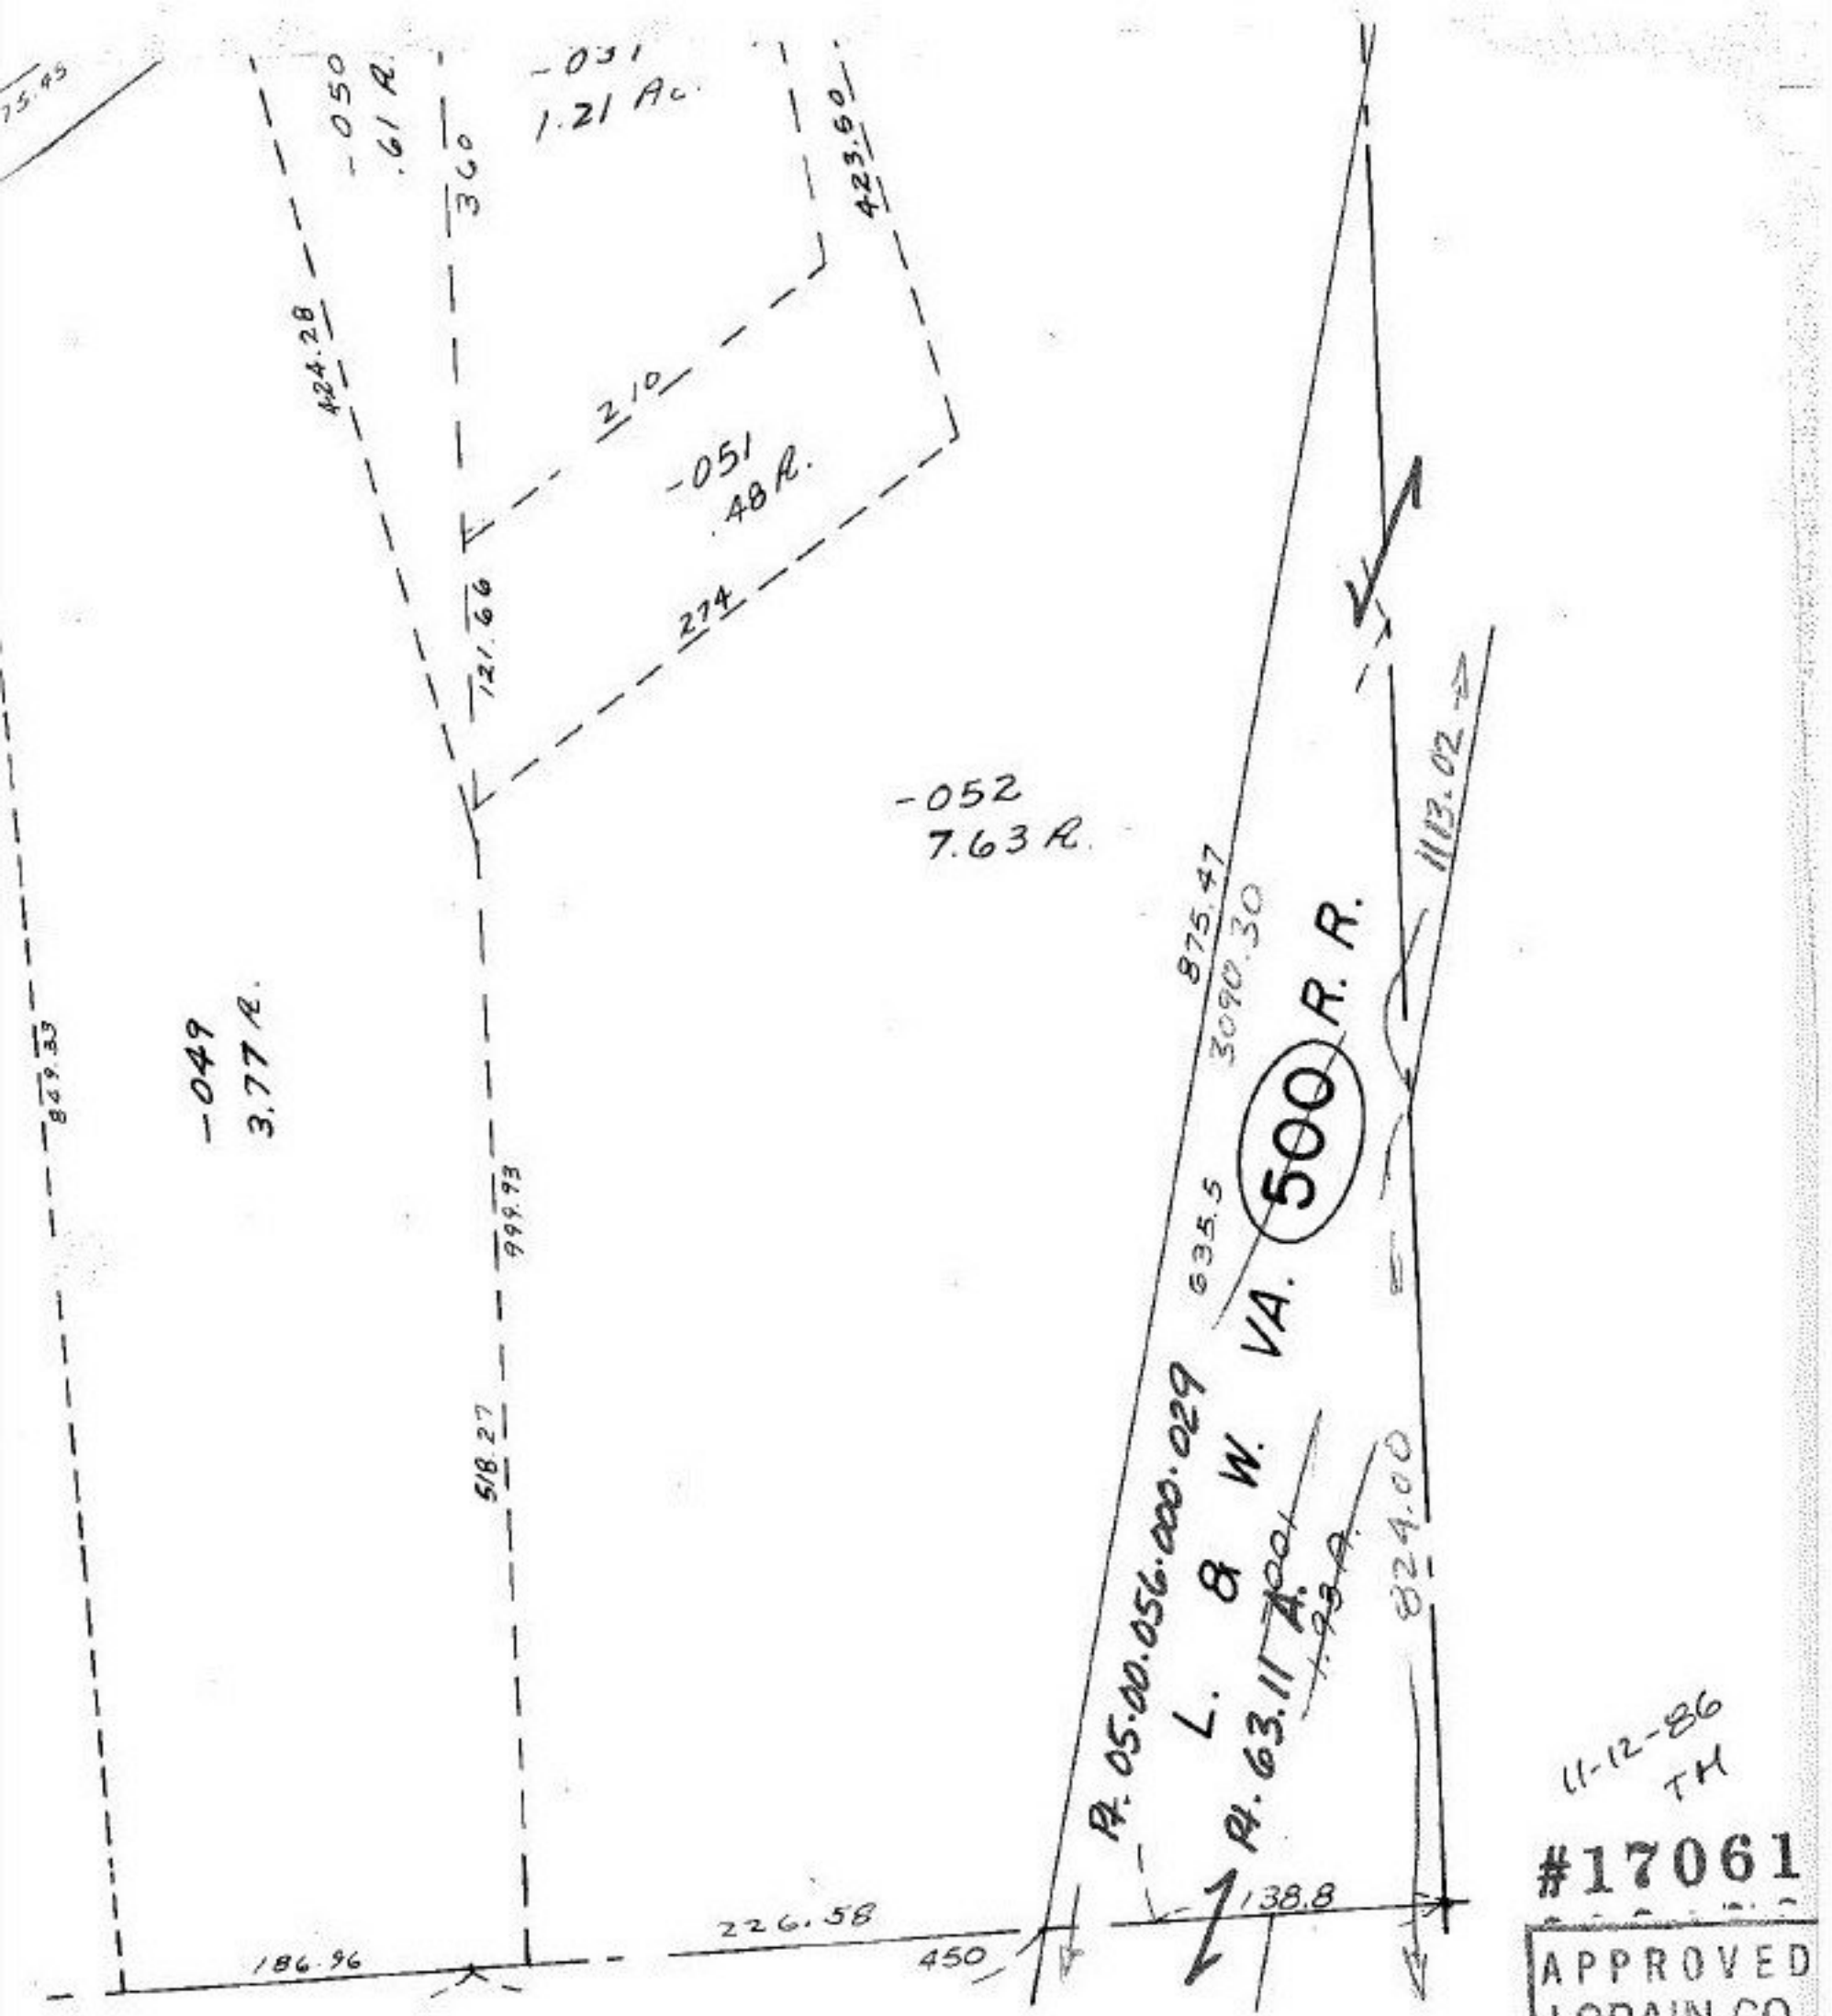

11-12-86
TH

#17061

APPROVED
LORAIN CO.
MAP DEPT.

DATE 10-31-86

PAGE 5-00-029-

BY T. McMain

VOID AFTER