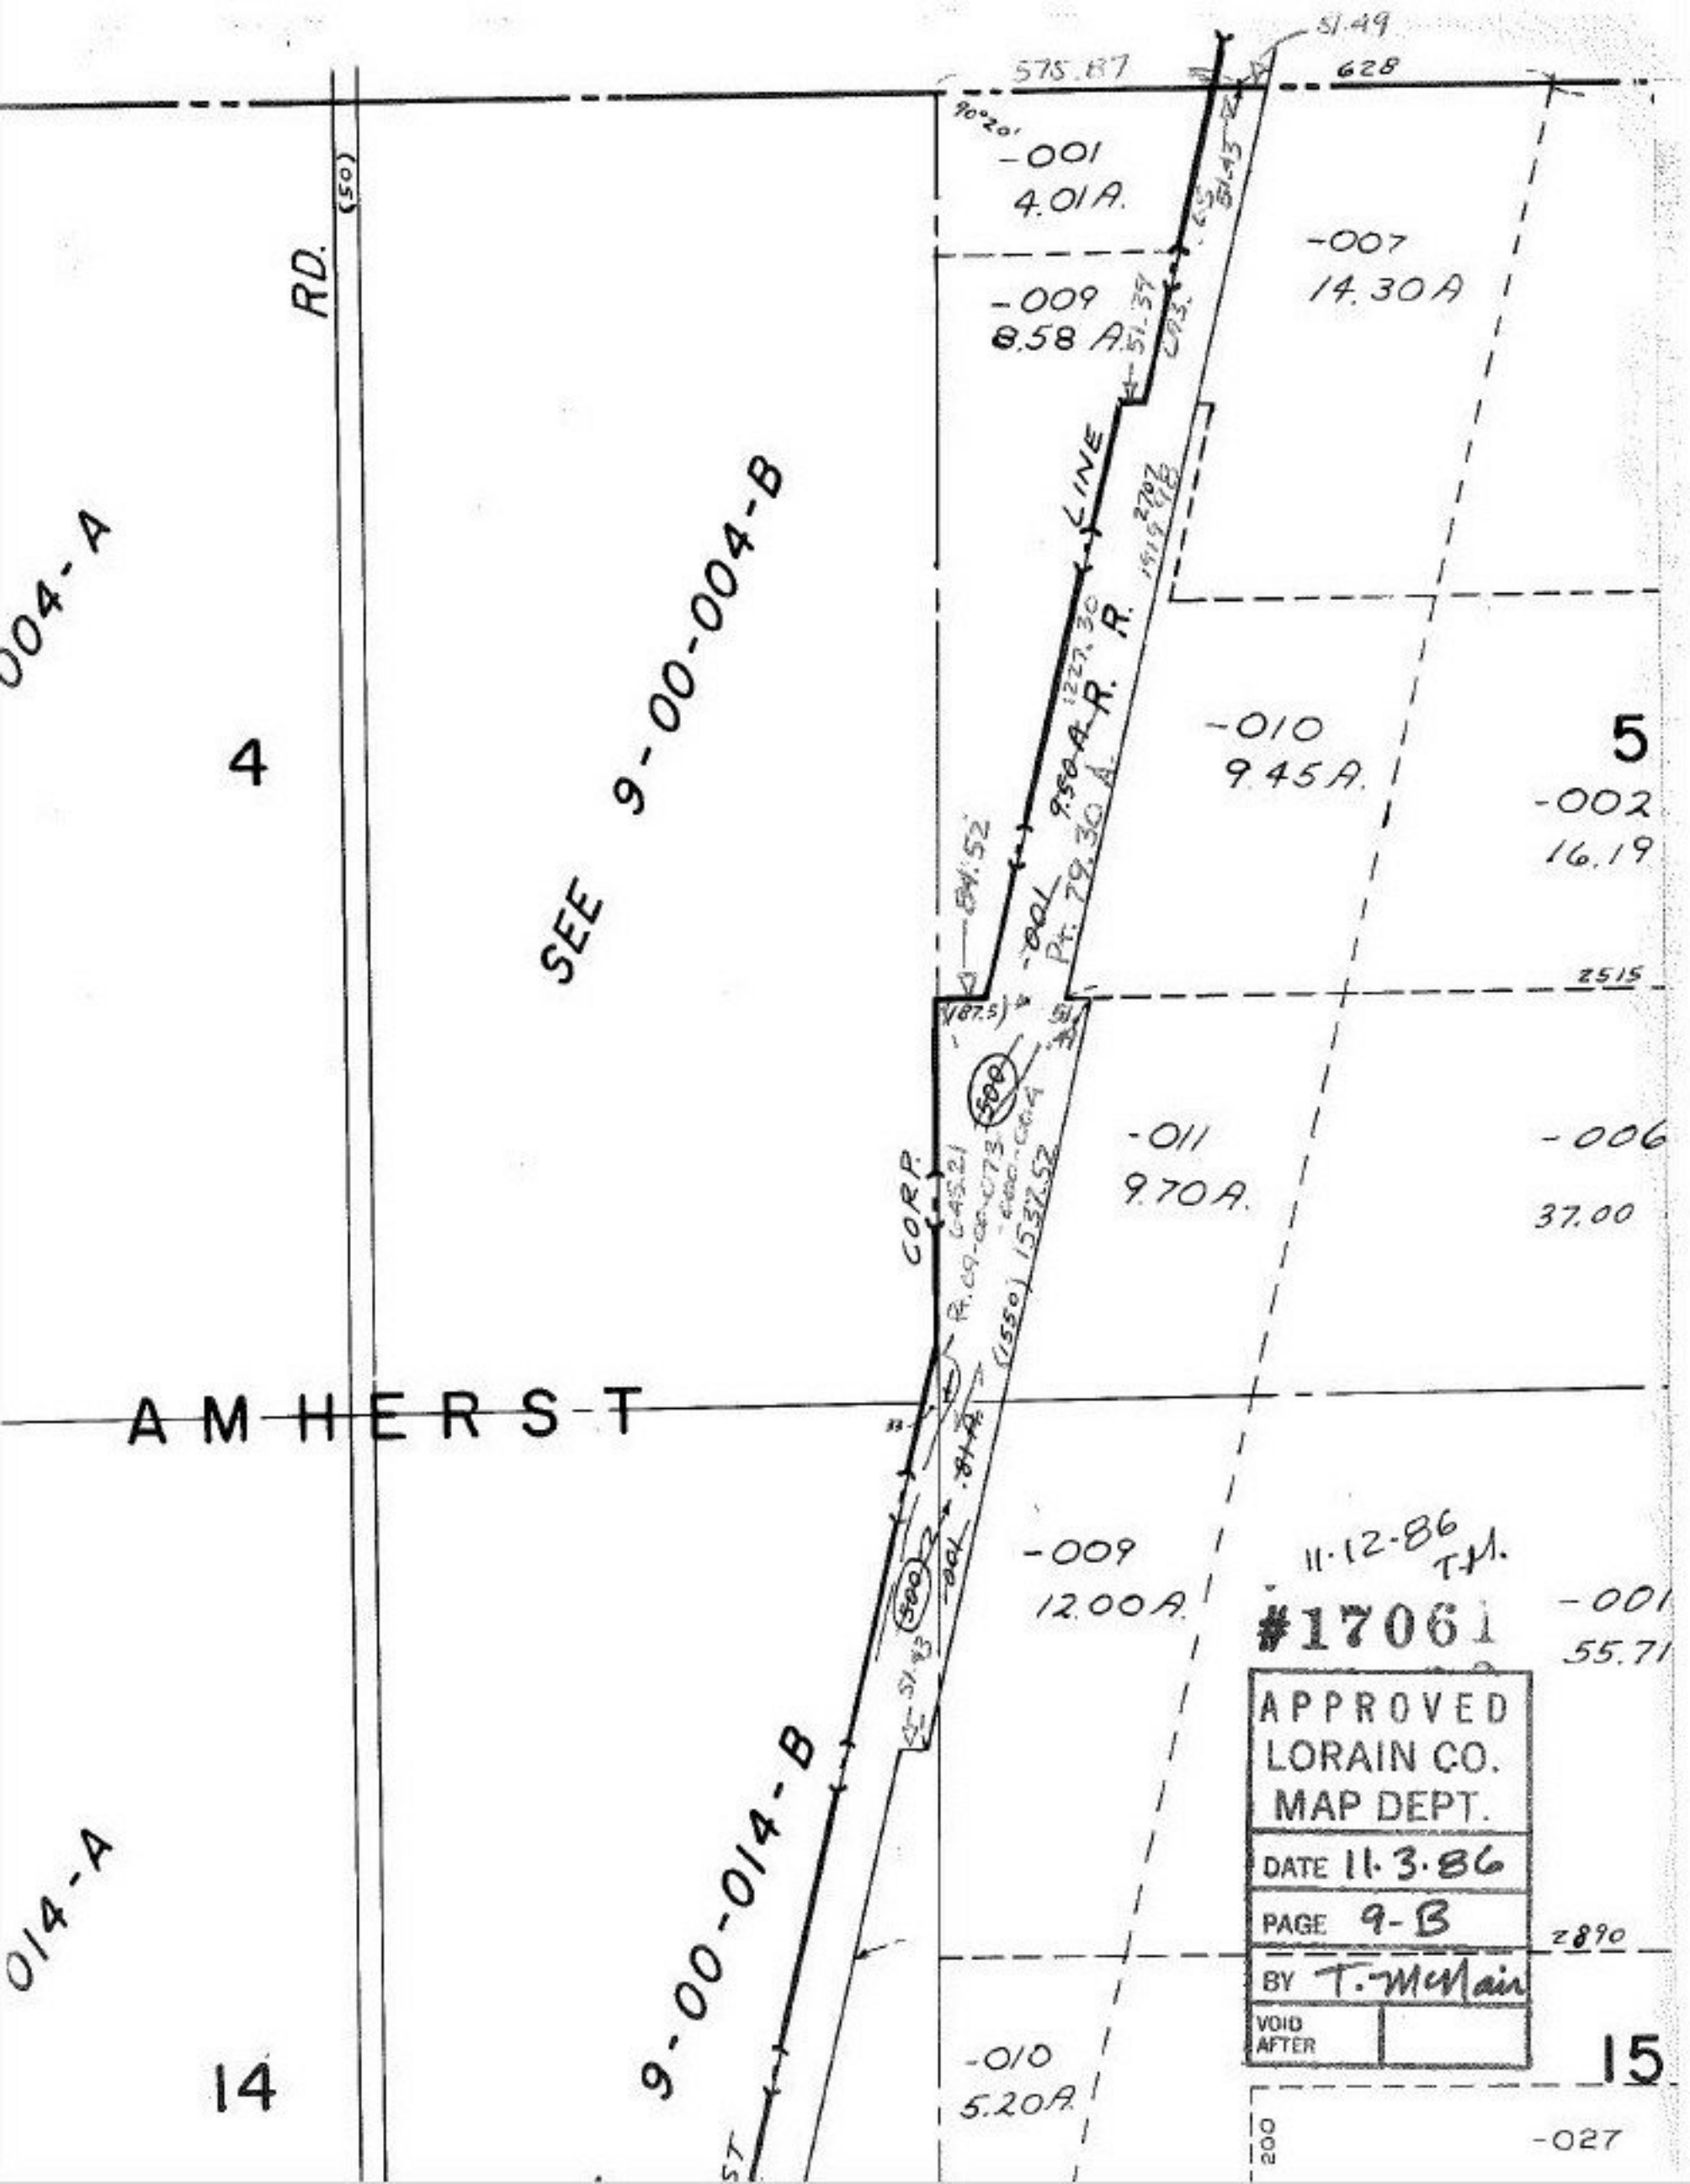

575.87
628
51.49
90°20'
-001
4.01A.
-007
14.30A
-009
8.58 A.
RD.
(50)
004-A
SEE 9-00-004-B
LINE
R. R.
1227.30
9.50 A.
Pt. 79.30 A.
-010
9.45A.
5
-002
16.19
4
2515
(187.5)
500
-011
9.70A.
-006
37.00
CORP.
(1550) 1537.52
AMHERST
-009
12.00A.
11-12-86 T.M.
#17061
-001
55.71
APPROVED
LORAIN CO.
MAP DEPT.
DATE 11-3-86
PAGE 9-B
BY T. McNair
VOID AFTER
014-A
9-00-014-B
2890
-010
5.20A.
15
14
200
-027