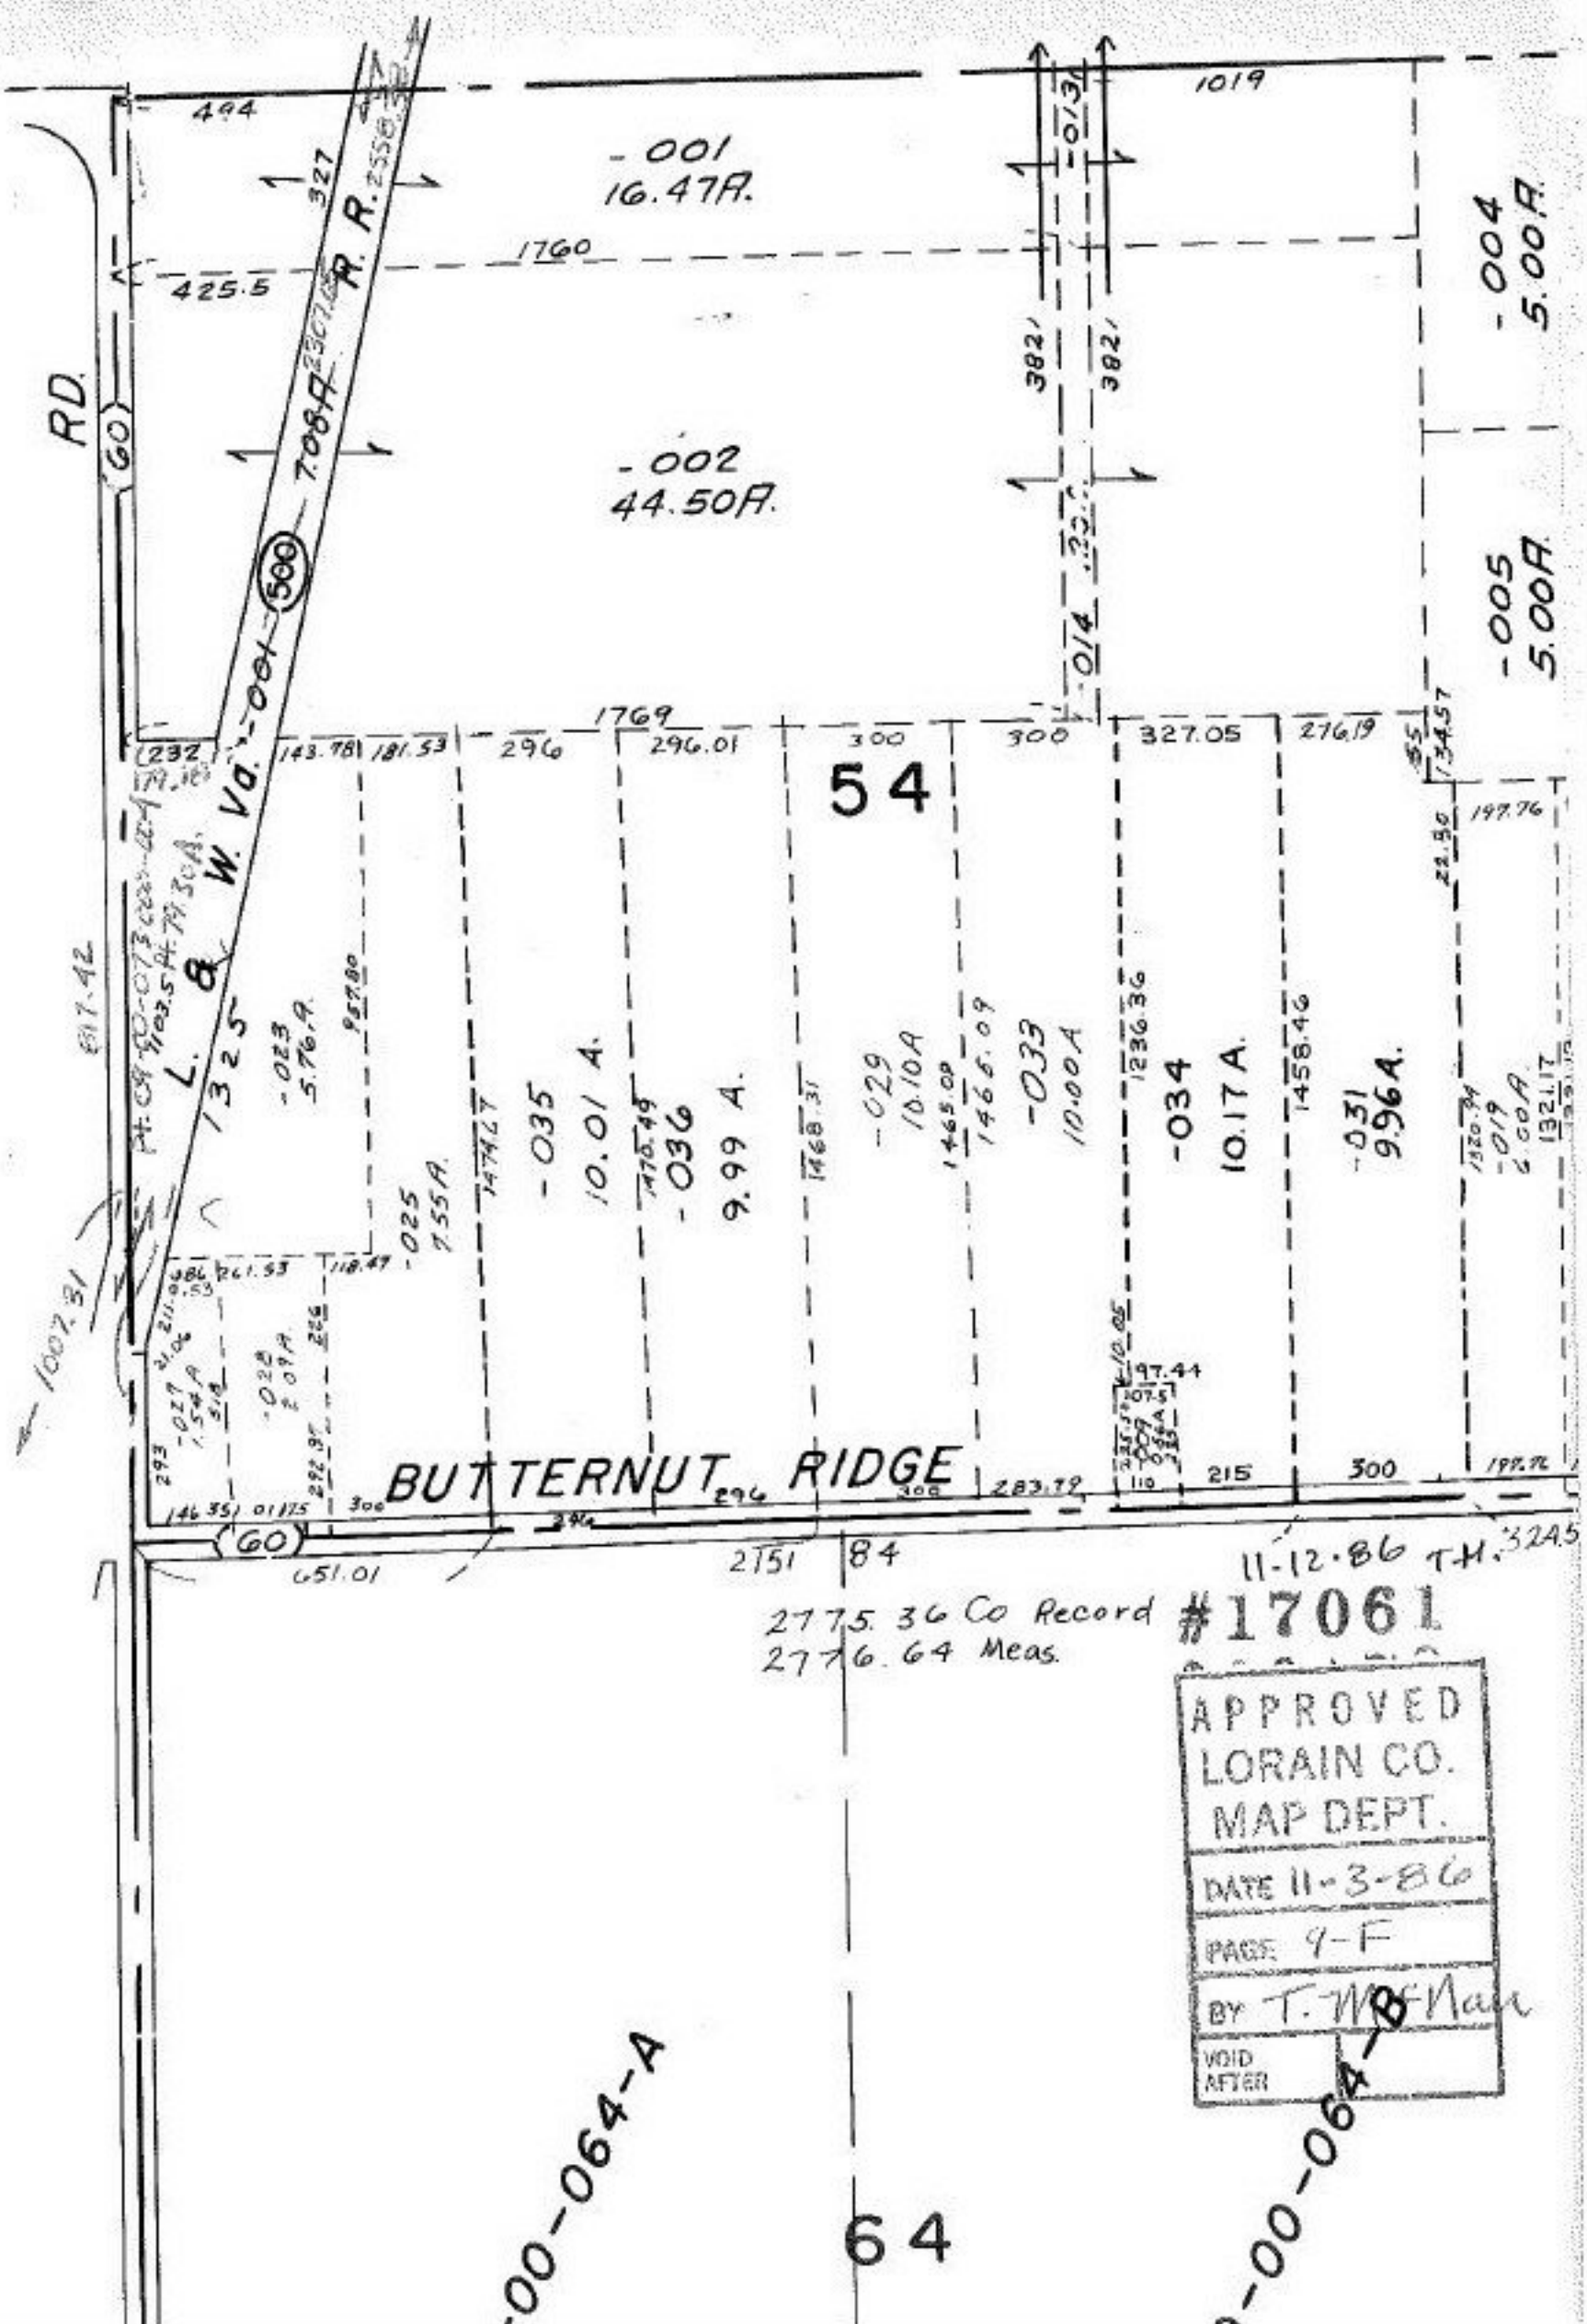
494
327
1760
425.5
RD.
60
R. R. 2558.42
7.08A
500
-001
16.47A.
-002
44.50A.
1019
-007.31
382'
382'
-004
5.00A.
-005
5.00A.
-014
1769
(232)
143.78
181.53
296
296.01
300
300
327.05
276.19
54
617.42
1007.31
L. & W. Va. -004-
1325'
Pt. of 50-073 (see 424)
103.5 A. M. 30A.
-023
5.76A.
-025
7.55A.
-035
10.01 A.
-036
9.99 A.
-029
10.10A
-033
10.00A
-034
10.17 A.
-031
9.96A.
1468.31
1465.09
1236.36
1458.46
1320.74
-019
4.00A.
1321.17
BUTTERNUT RIDGE
GO
651.01
2751
84
2775.36 Co Record
2776.64 Meas.
11-12-86 T.H. 3245
#17061
APPROVED
LORAIN CO.
MAP DEPT.
DATE 11-3-86
PAGE 9-F
BY T. McNair
VOID AFTER
64
-00-064-A
-00-064-B