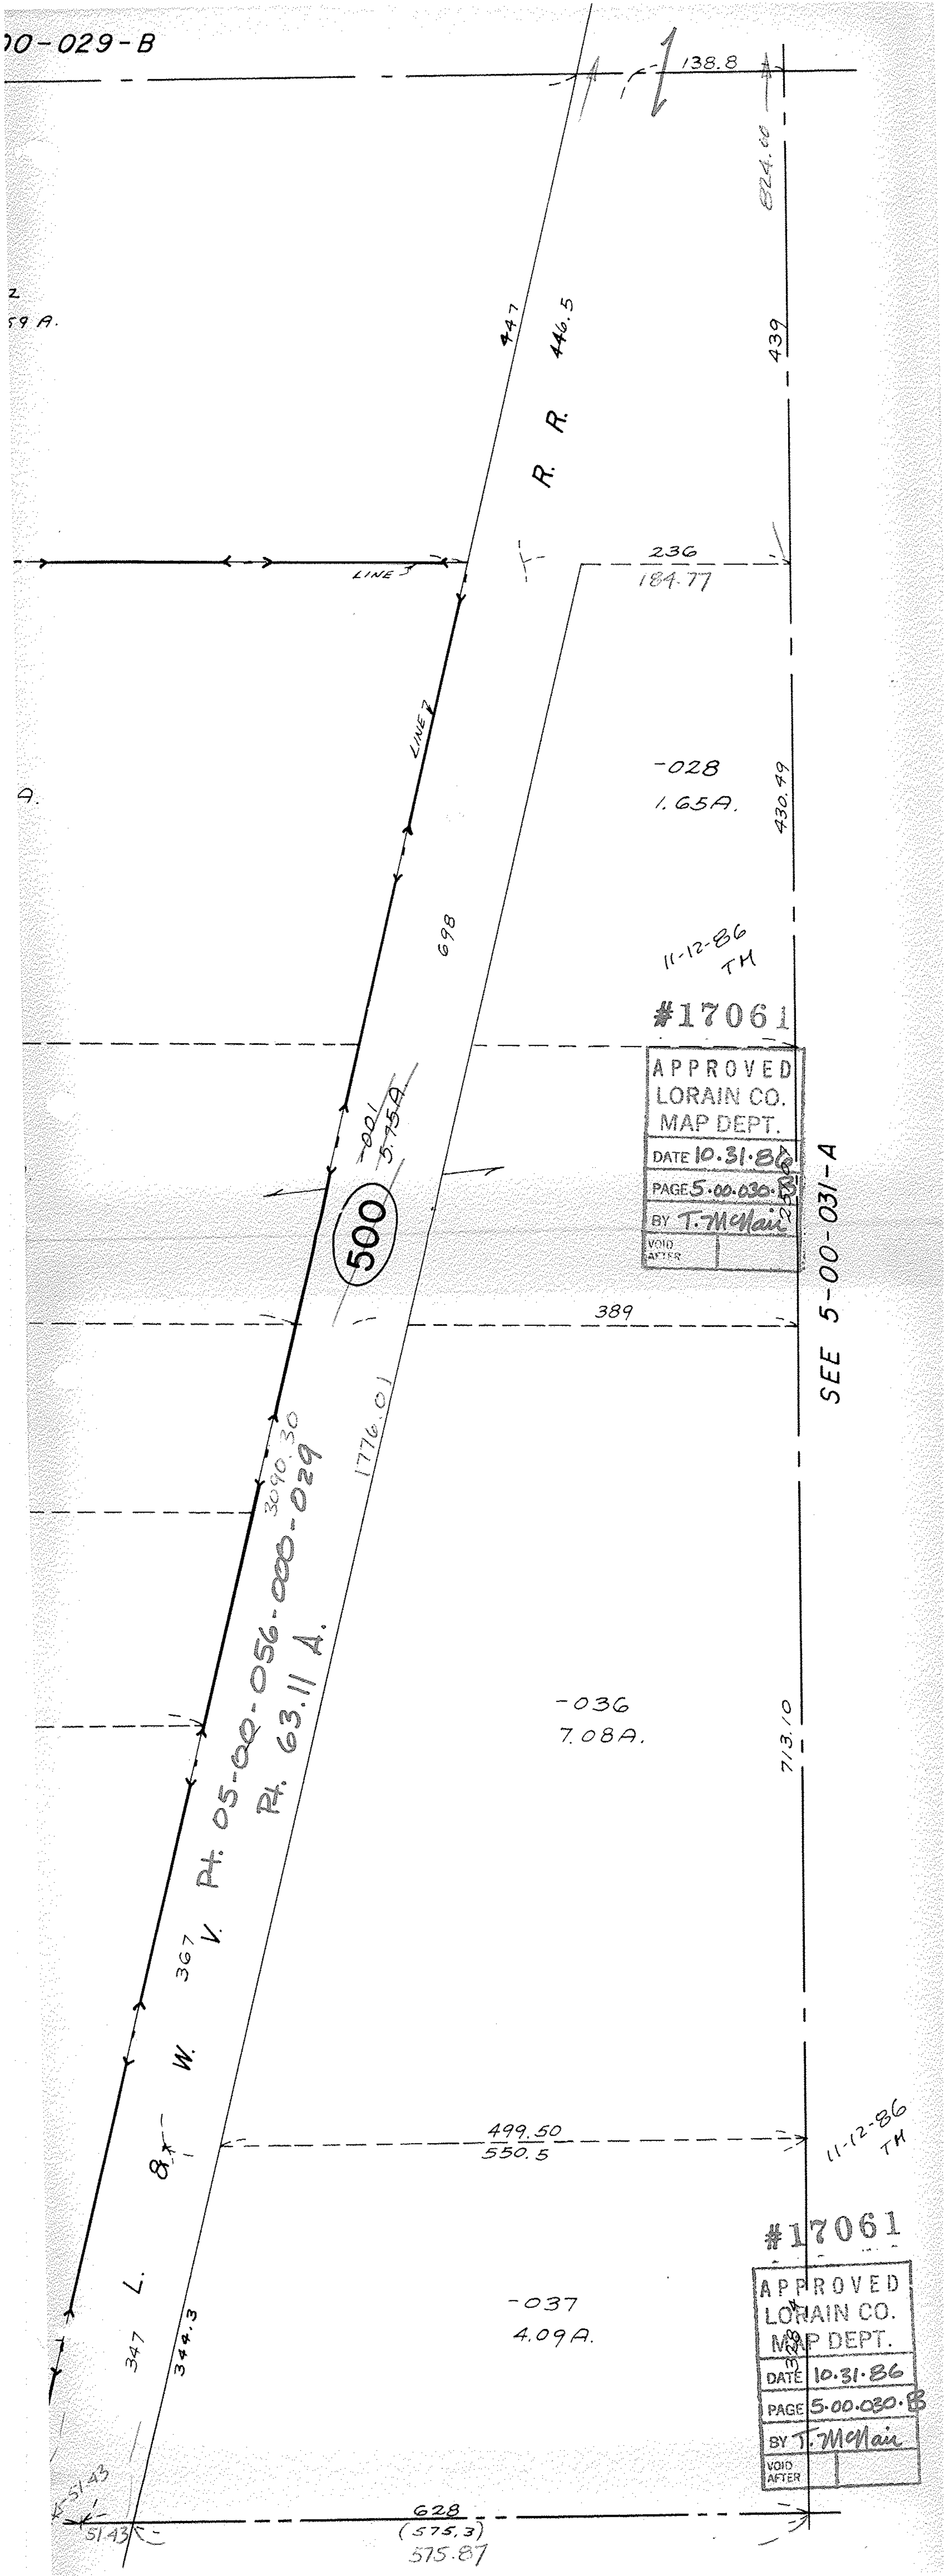
00-029-B
138.8
824.66
59 A.
447
R. R.
446.5
439
LINE 3
236
184.77
LINE 2
-028
1.65A.
430.49
A.
698
11-12-86
TH
#17061
APPROVED
LORAIN CO.
MAP DEPT.
DATE 10.31.86
PAGE 5.00.030.88
BY T. McNair
VOID AFTER
-021
5.75A.
500
389
SEE 5-00-031-A
1776.01
3090.30
Pt. 05-00-056-000-029
Rt. 63.11 A.
-036
7.08A.
713.10
367
L. & W. Co.
347
344.3
499.50
550.5
11-12-86
TH
#17061
APPROVED
LORAIN CO.
MAP DEPT.
DATE 10.31.86
PAGE 5.00.030.88
BY T. McNair
VOID AFTER
-037
4.09A.
51.43
51.43
628
(575.3)
575.87