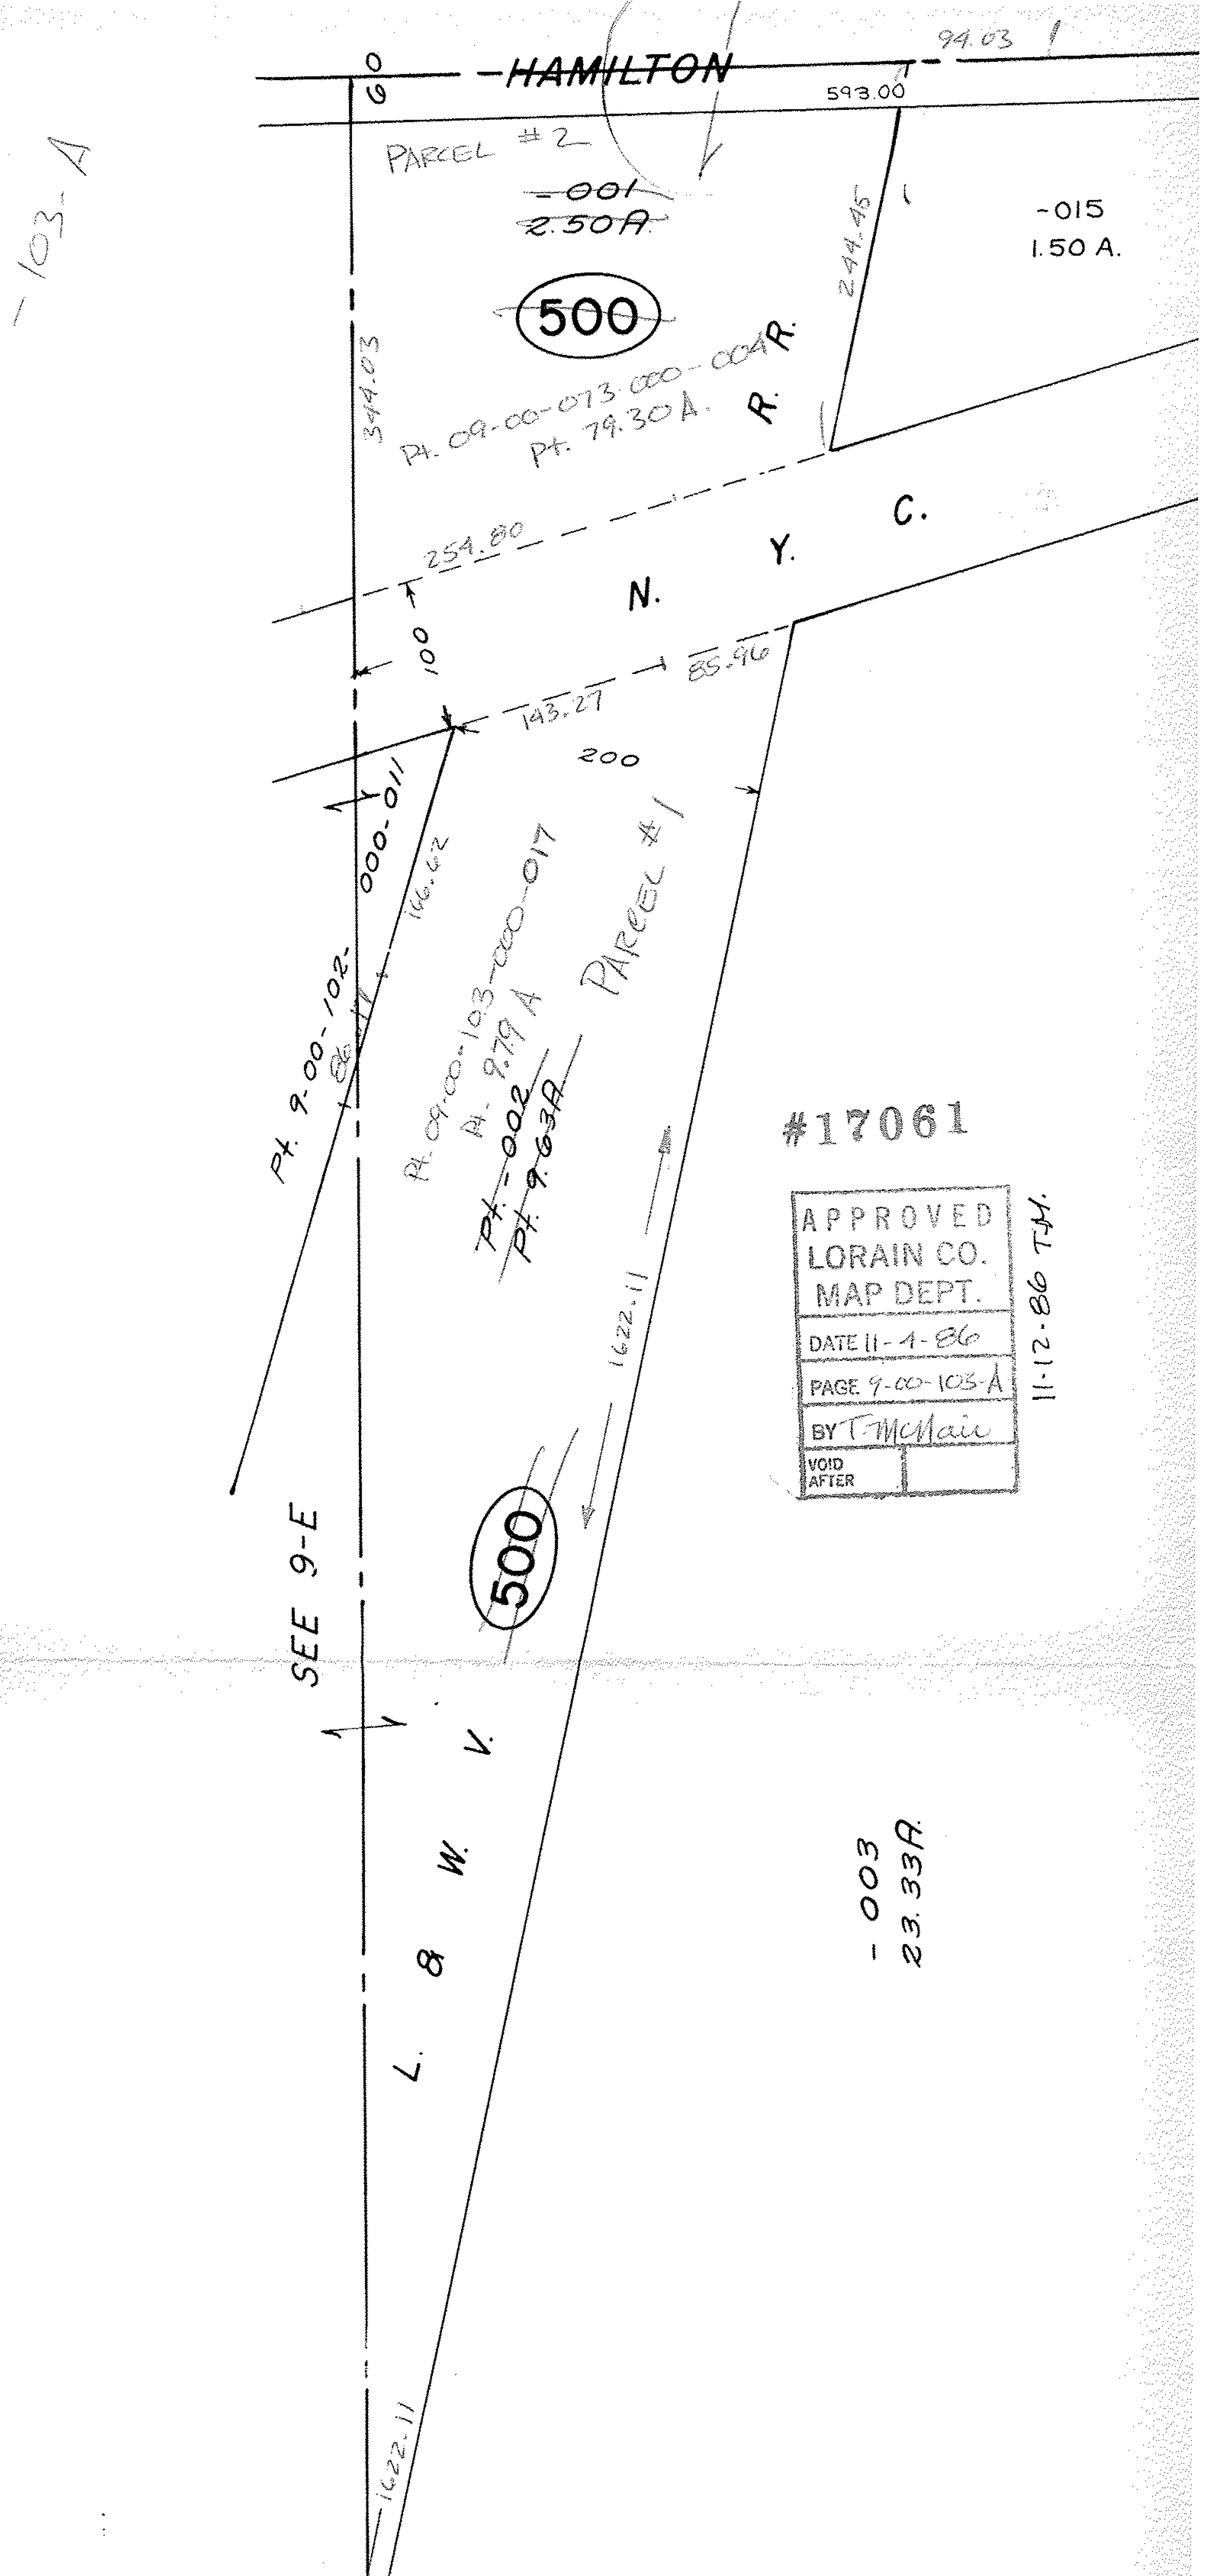
HAMILTON
94.03
593.00
PARCEL #2
-001
2.50A.
500
344.03
244.45
-015
1.50 A.
Pt. 09-00-073.000-004
Pt. 79.30 A.
R. R.
254.80
N. Y. C.
100
85.96
143.27
200
000-011
166.62
Pt. 9.00-102-
Pt. 09-00-103.000-017
Pt. 9.79 A
Pt. -002
Pt. 9.63A
PARCEL #1
#17061
APPROVED
LORAIN CO.
MAP DEPT.
DATE 11-1-86
PAGE 9-00-103-A
BY T McMain
VOID AFTER
11-12-86 T.M.
1622.11
500
SEE 9-E
L. 8 W. V.
-003
23.33A.
1622.11
-103-A