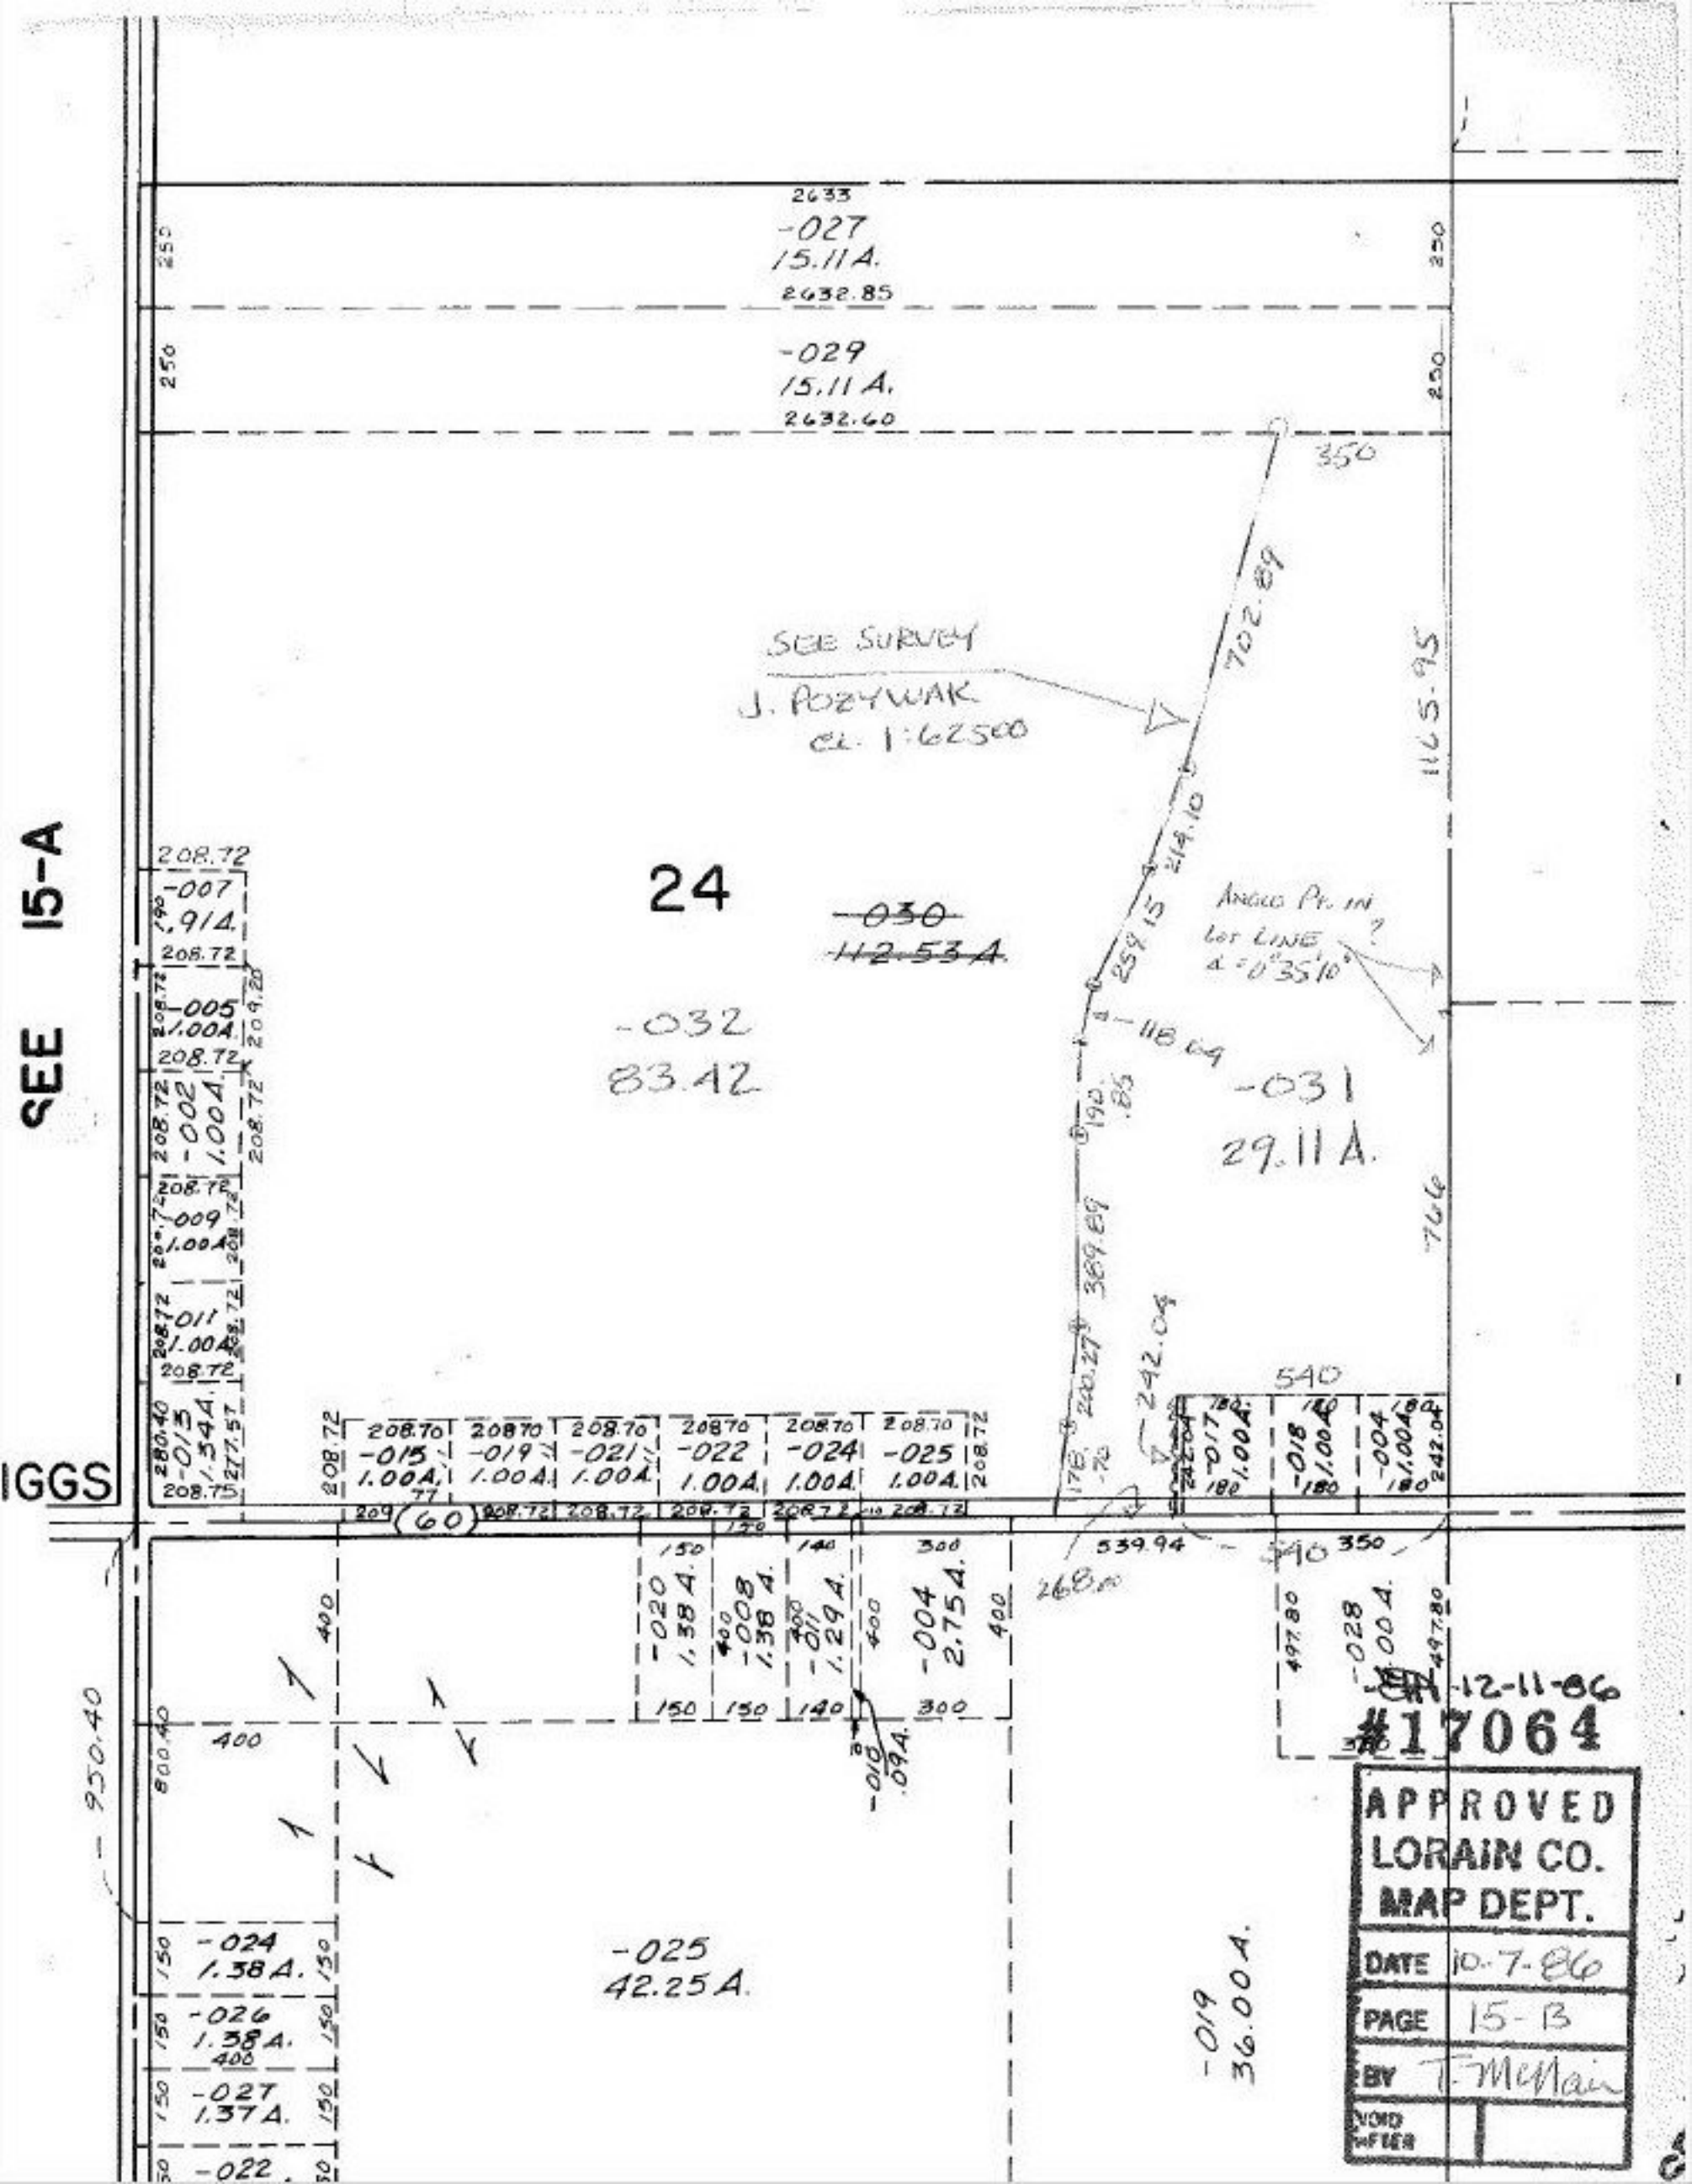
SEE 15-A
IGGS
2633
-027
15.11 A.
2632.85
-029
15.11 A.
2632.60
350
702.89
SEE SURVEY
J. POZYWAK
CL. 1:62500
1165.95
24
~~-030~~
~~112.53 A.~~
-032
83.42
ANGLE PT. IN LOT LINE ?
Δ = 0°35'10"
-031
29.11 A.
-007
.91 A.
-005
1.00 A.
-002
1.00 A.
-009
1.00 A.
-011
1.00 A.
-013
1.34 A.
-015
1.00 A.
-019
1.00 A.
-021
1.00 A.
-022
1.00 A.
-024
1.00 A.
-025
1.00 A.
-017
1.00 A.
-018
1.00 A.
-004
1.00 A.
540
539.94
-020
1.38 A.
-008
1.38 A.
-011
1.29 A.
-004
2.75 A.
-028
1.00 A.
-010
.09 A.
-025
42.25 A.
-019
36.00 A.
-024
1.38 A.
-026
1.38 A.
-027
1.37 A.
-022
950.40
12-11-86
#17064
APPROVED
LORAIN CO.
MAP DEPT.
DATE 10-7-86
PAGE 15-B
BY T. McNair
VOID AFTER