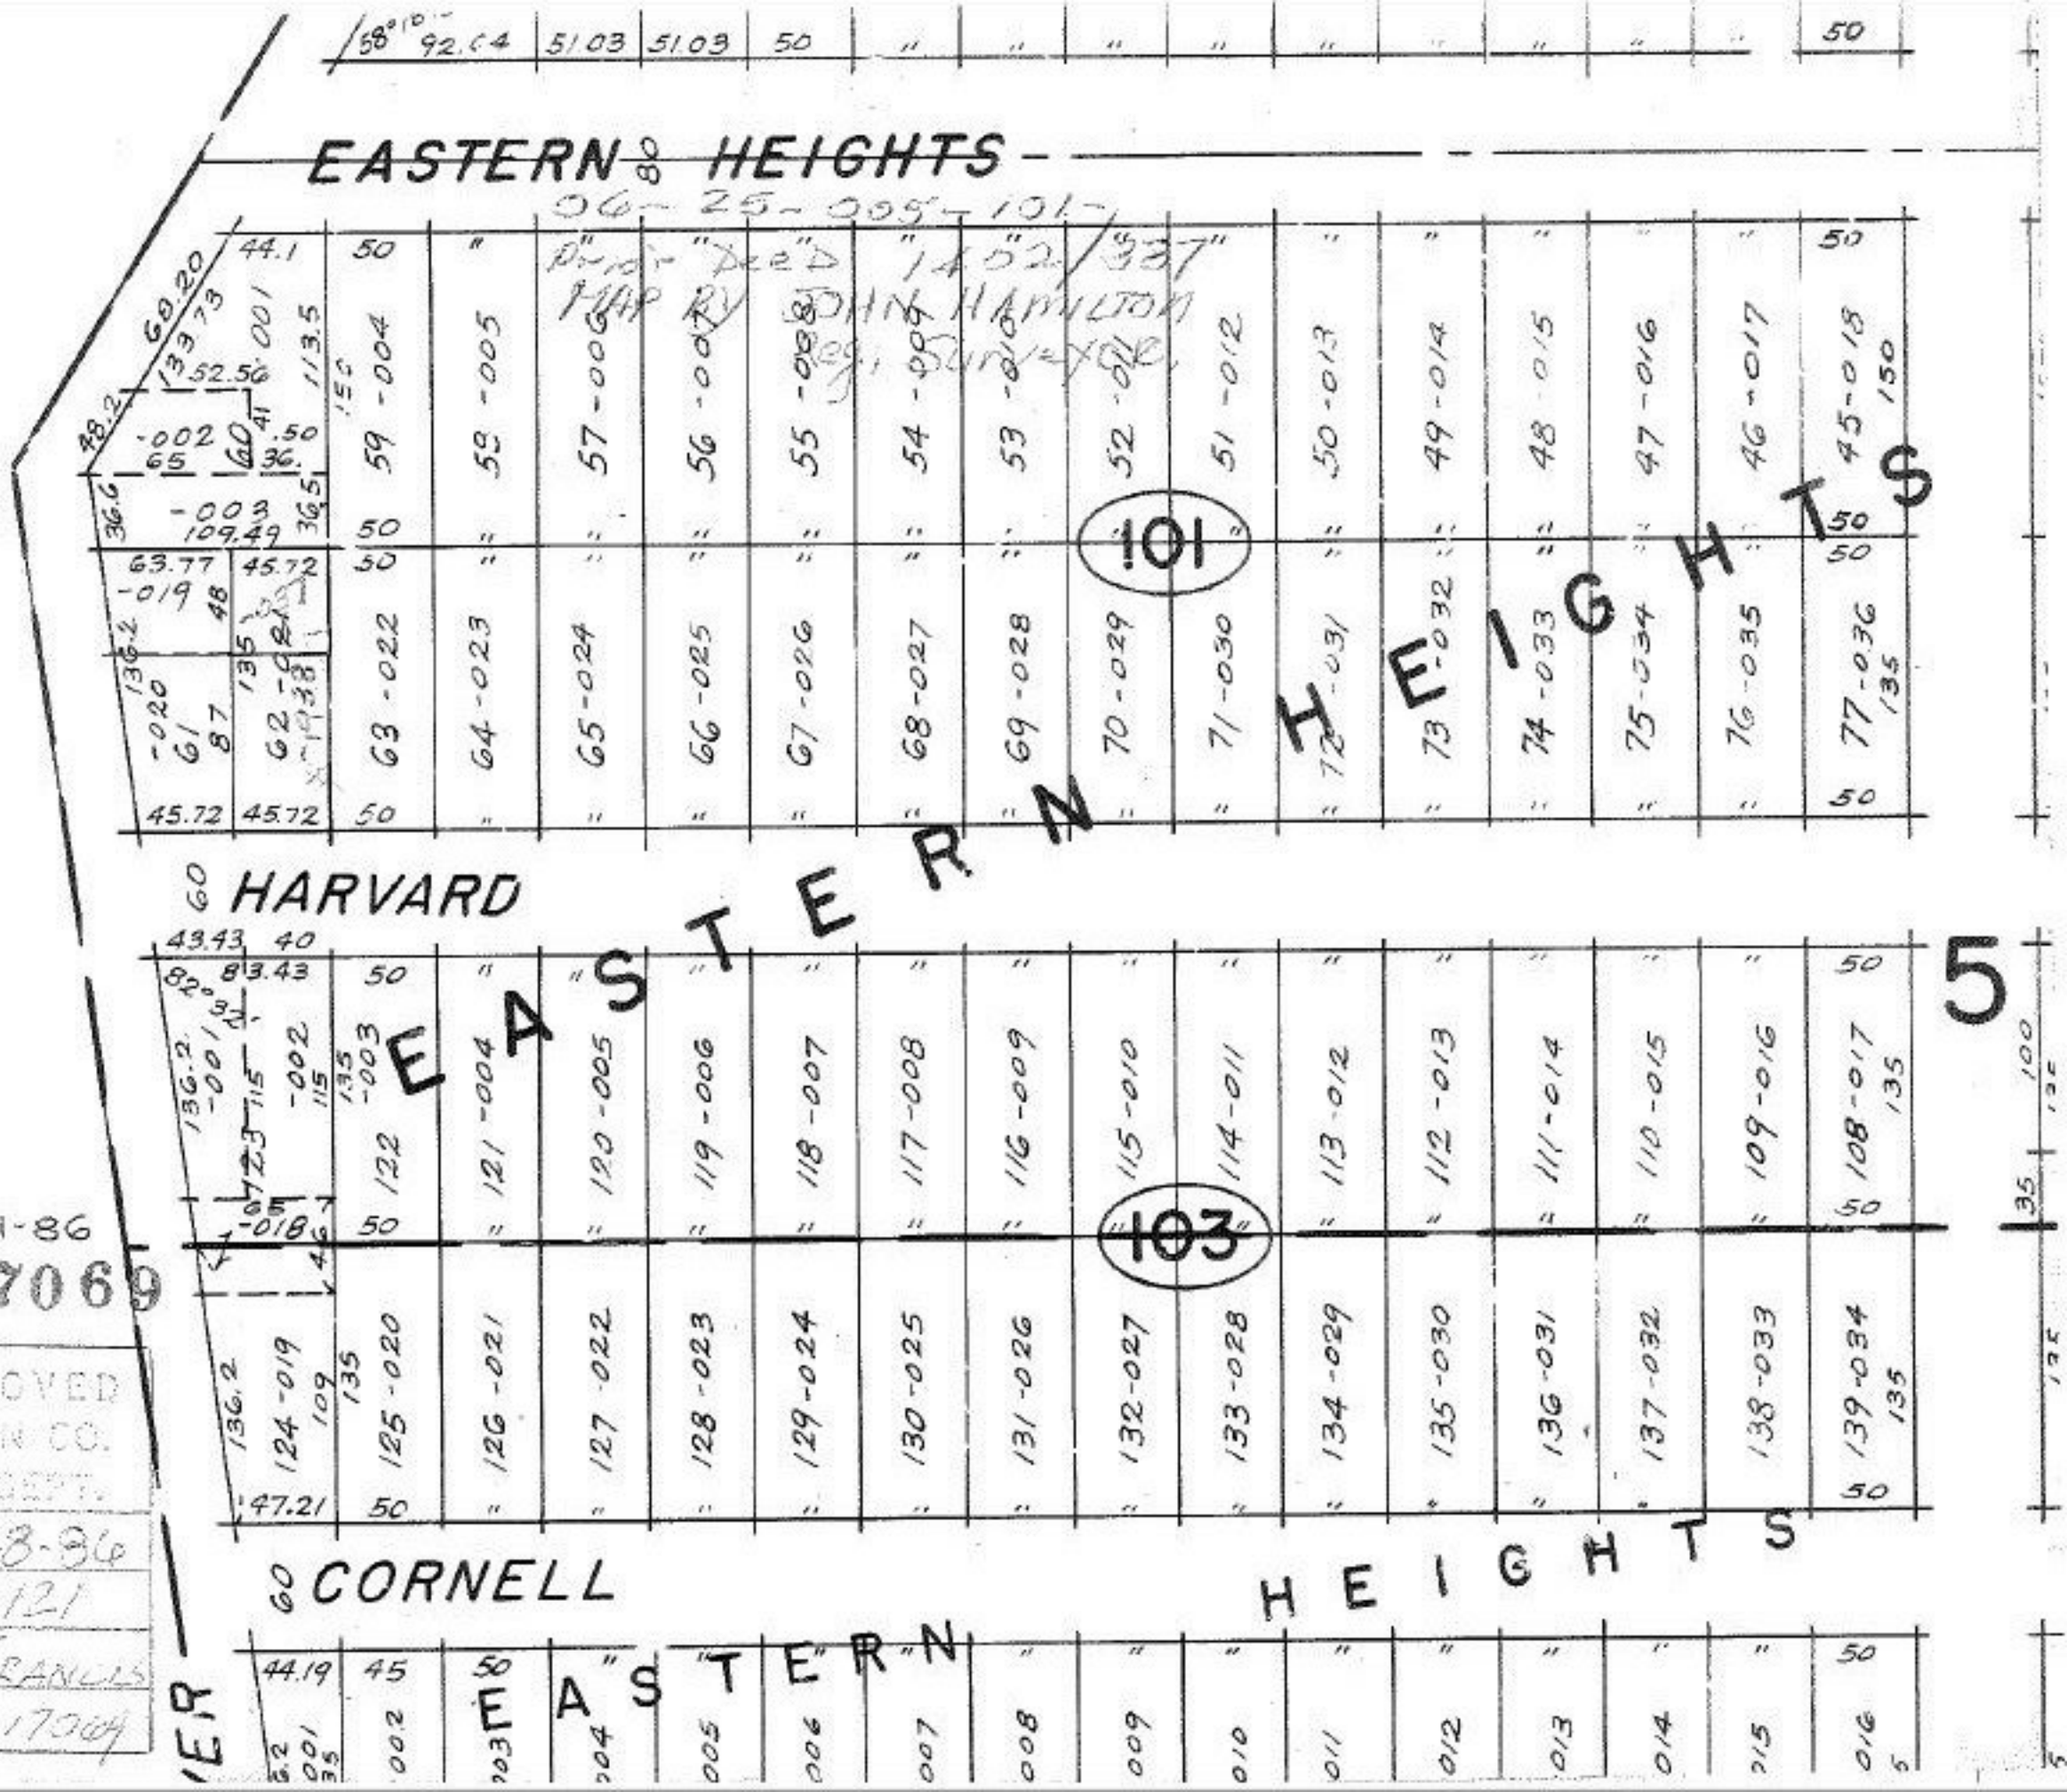

10-21-86

#17069

APPROVED
DRAIN CO.
MAP DEPT.
DATE 10-8-86
PAGE 6-121
BY C. FRANCIS
VOID AFTER 17069