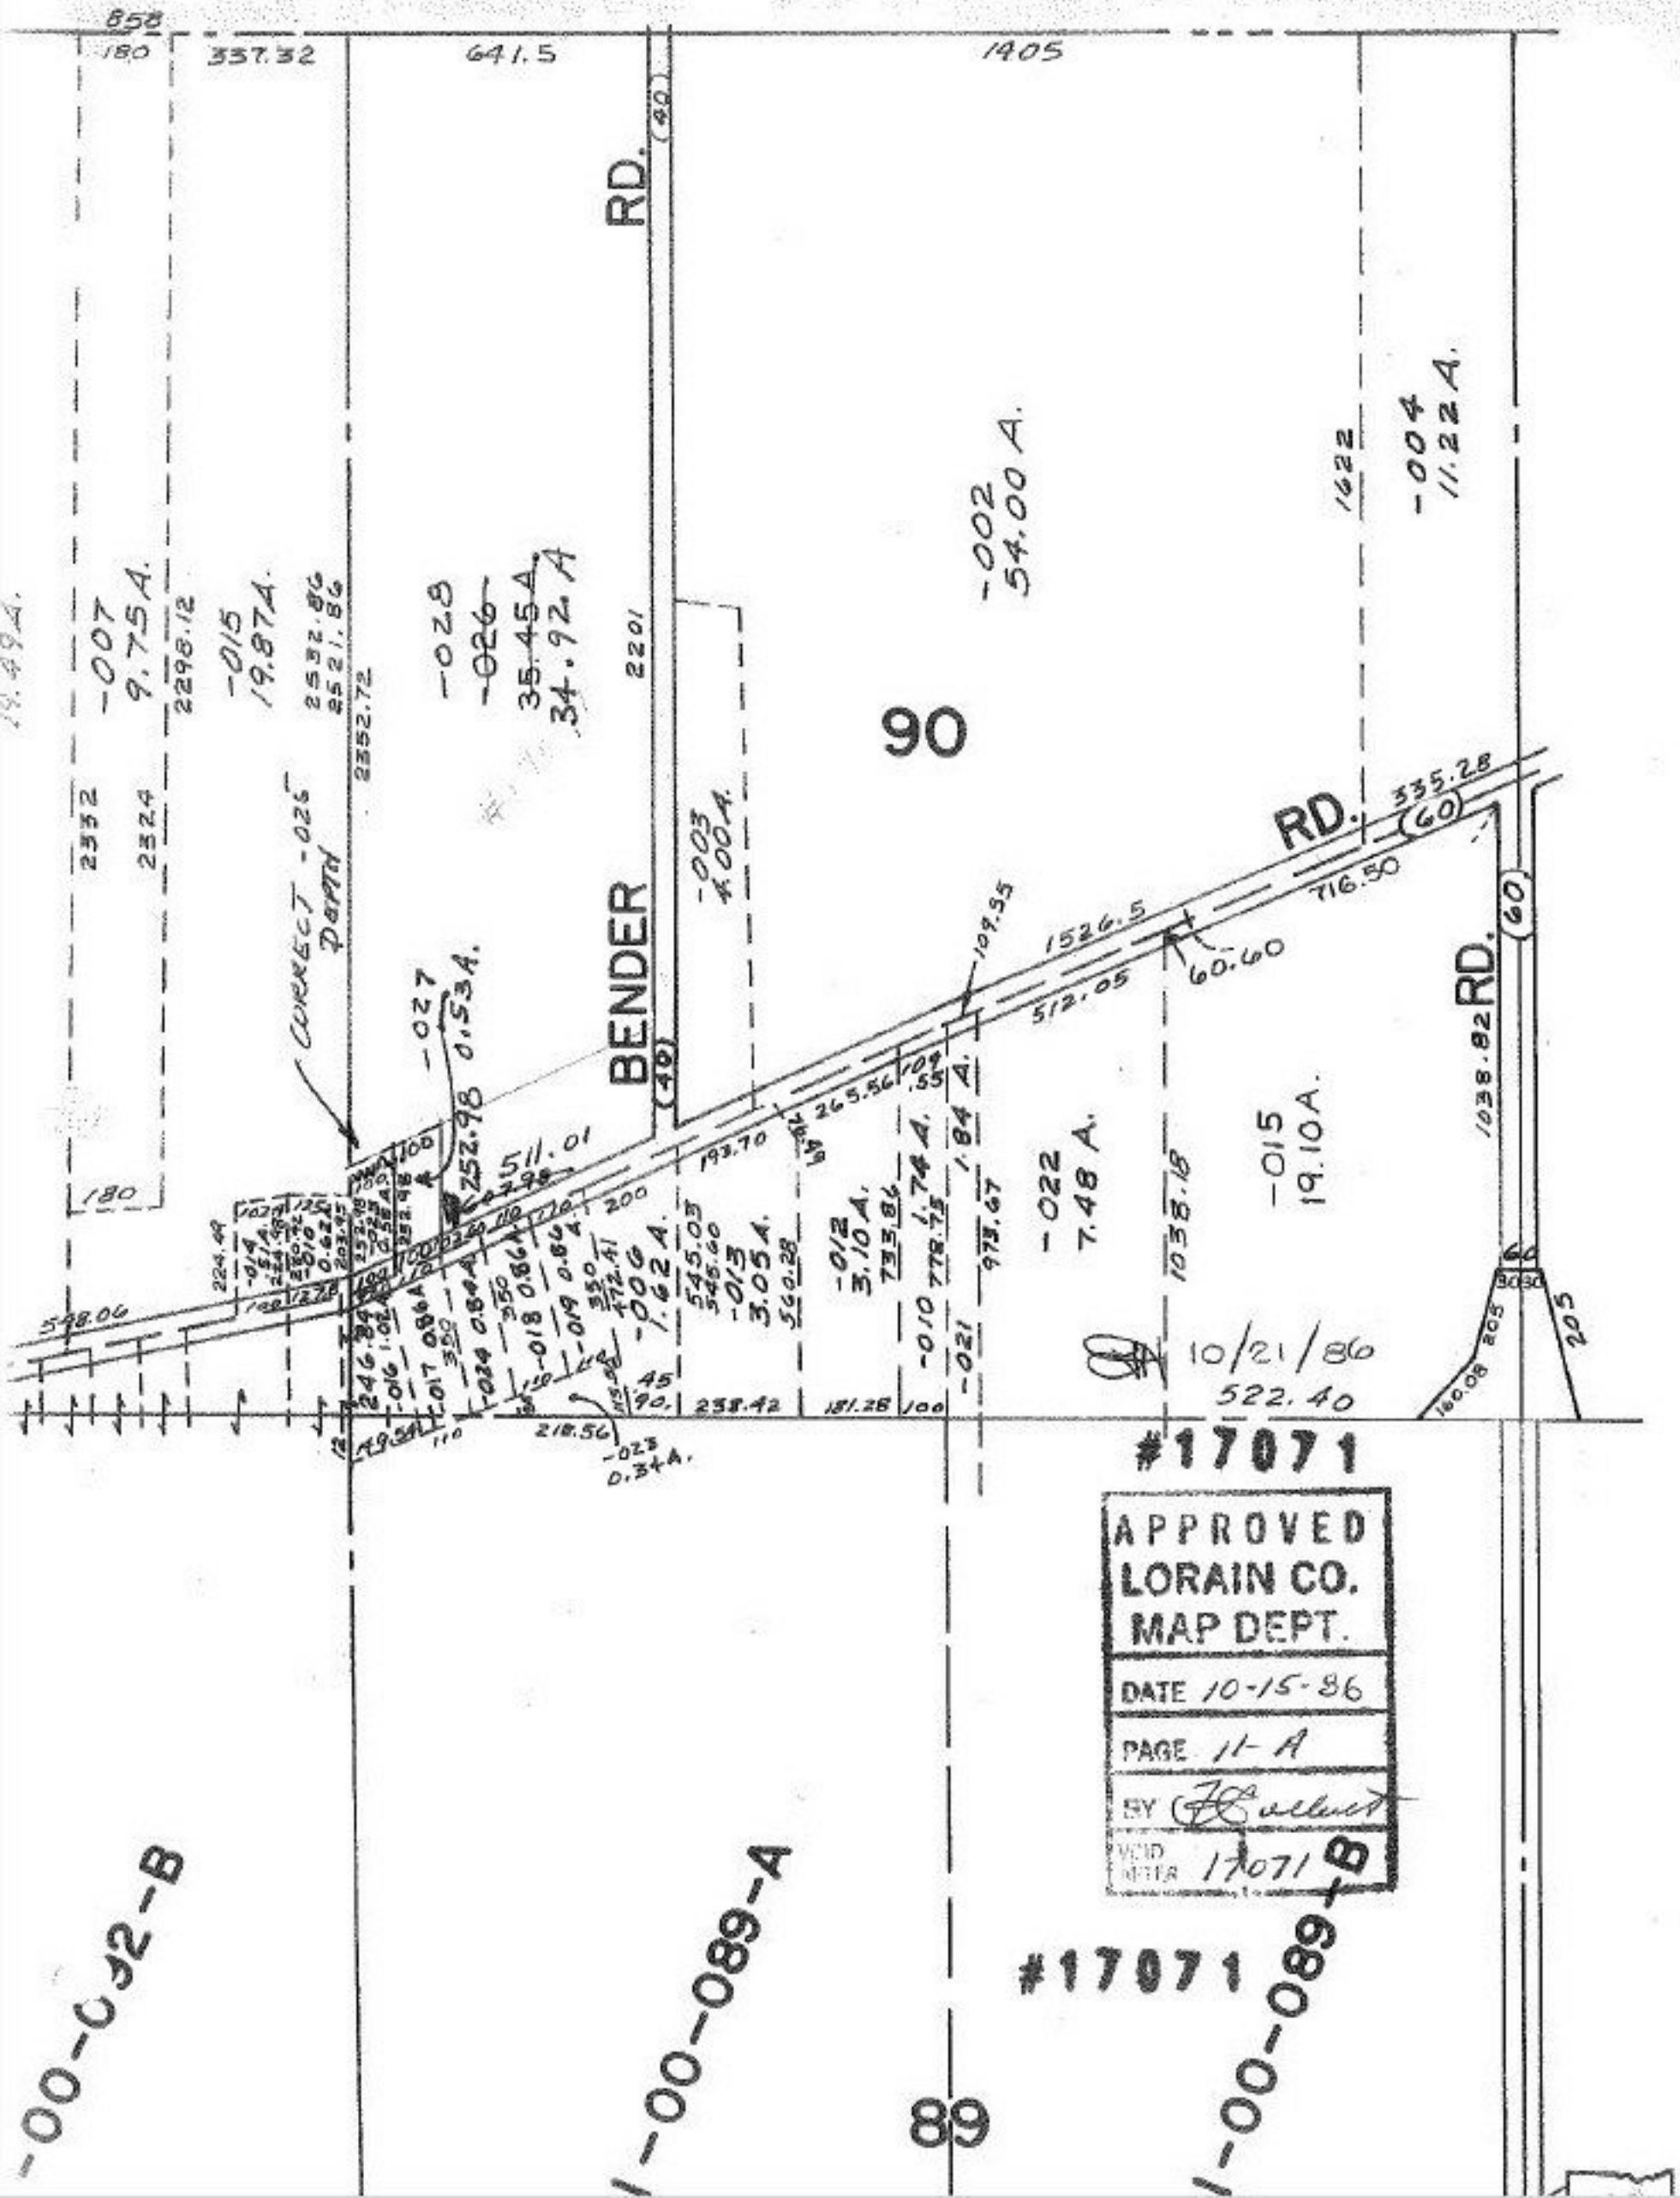

858
180
337.32
641.5
1405
RD.
(40)
-007
9.75 A.
2298.12
-015
19.87 A.
2532.86
2521.86
2352.72
-028
-026
35.45 A.
34.92 A
2201
-002
54.00 A.
1622
-004
11.22 A.
90
2332
2324
CORRECT -026
DEPTH
-003
4.00 A.
BENDER
(40)
-027
0.53 A.
252.98
511.01
180
-006
1.62 A.
545.03
545.60
-013
3.05 A.
560.28
-012
3.10 A.
733.86
-010
778.75
1.74 A.
1.84 A.
973.67
-021
-022
7.48 A.
1038.18
-015
19.10 A.
1038.82
RD.
(60)
335.28
716.50
1526.5
512.05
60.60
109.55
265.56
193.70
200
548.06
224.49
-023
0.34 A.
218.56
238.42
181.28
100
10/21/86
522.40
160.08
205
#17071
APPROVED
LORAIN CO.
MAP DEPT.
DATE 10-15-86
PAGE 11-A
BY
VOID NOTE 17071
-00-092-B
-00-089-A
#17071
-00-089-B
89