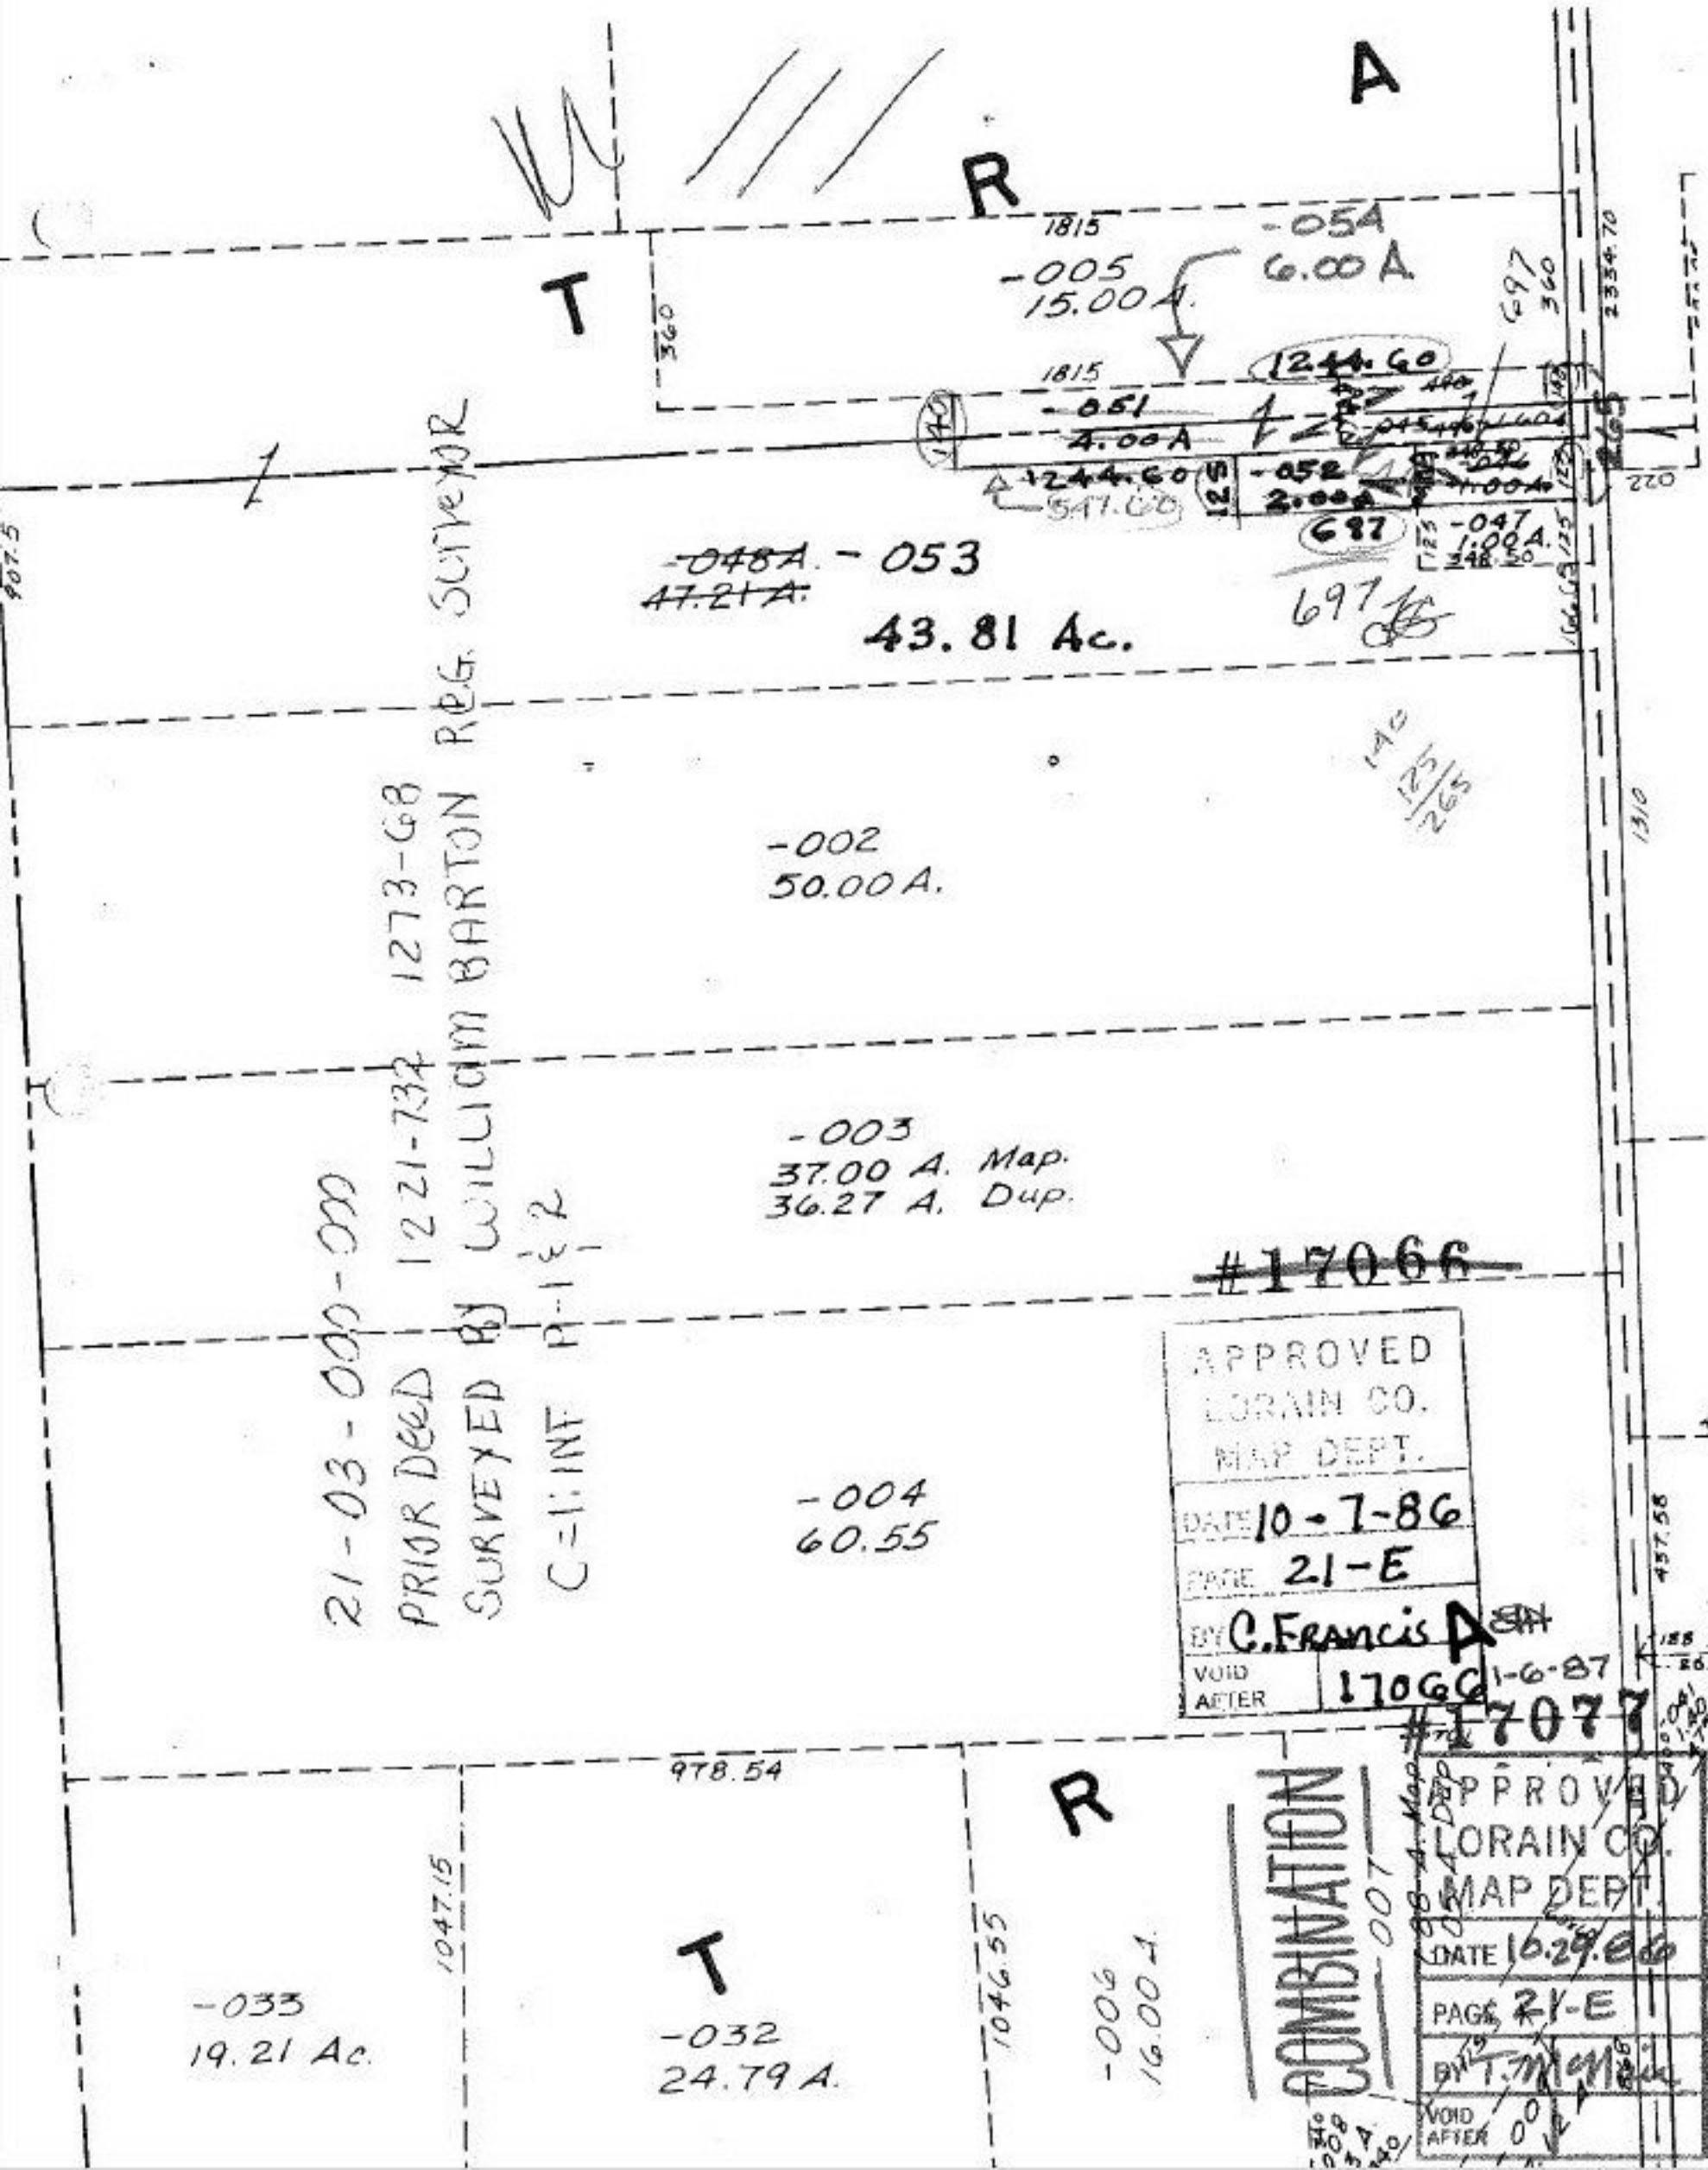

T R A
1815
-005
15.00 A.
-054
6.00 A
1815
-051
4.00 A
1244.60
-052
2.00 A
697
-047
1.00 A.
-048A. - 053
47.21 A.
43.81 Ac.
697
-002
50.00 A.
-003
37.00 A. Map.
36.27 A. Dup.
21-03-000-000
PRIOR DEED 1221-732 1273-68
SURVEYED BY WILLIAM BARTON REG. SURVEYOR
C=1: INF P-1 & 2
#17066
APPROVED
LORAIN CO.
MAP DEPT.
DATE 10-7-86
PAGE 21-E
BY C. Francis
VOID AFTER 17066
-004
60.55
1-6-87
#17077
APPROVED
LORAIN CO.
MAP DEPT.
DATE 10.29.86
PAGE 21-E
BY T. McNeil
VOID AFTER
978.54
R
T
-033
19.21 Ac.
-032
24.79 A.
-006
16.00 A.
COMBINATION