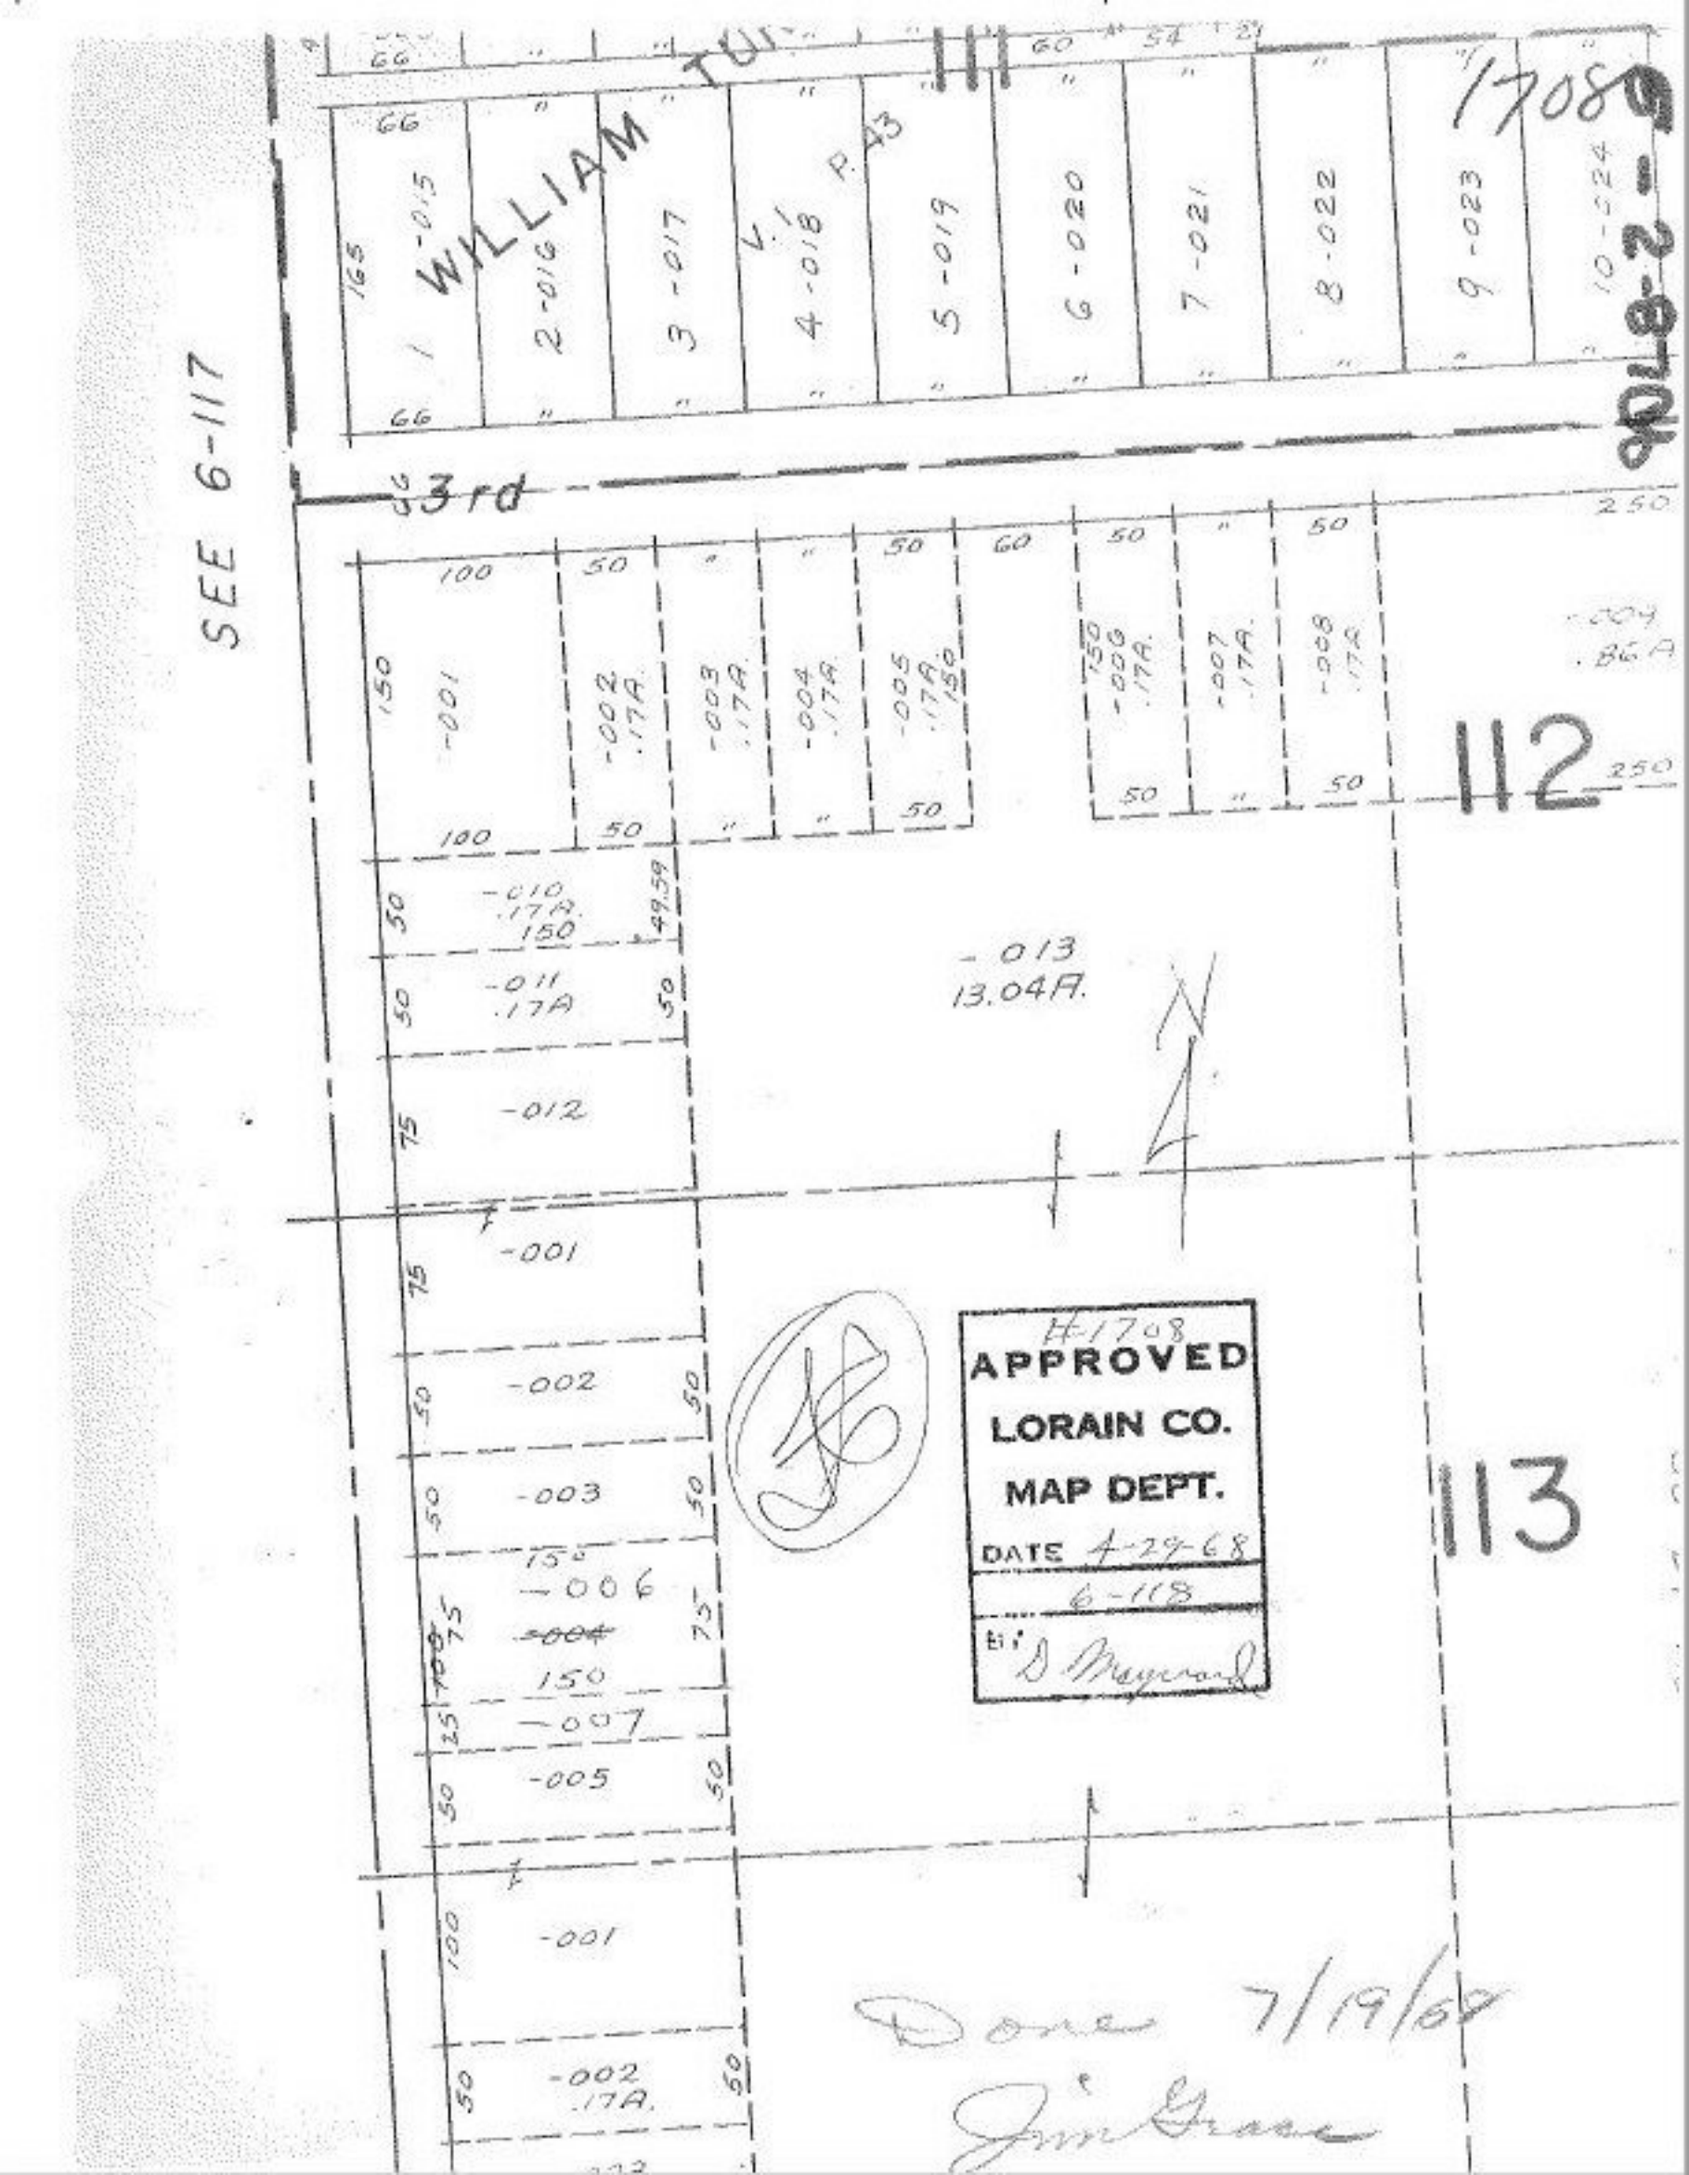
SEE 6-117
WILLIAM
43rd
1708
-015
-016
-017
-018
-019
-020
-021
-022
-023
-024
-001
-002 .17A.
-003 .17A.
-004 .17A.
-005 .17A.
-006 .17A.
-007 .17A.
-008 .17A.
-009 .86A
-010 .17A.
-011 .17A
-012
-013 13.04A.
112
113
APPROVED
LORAIN CO.
MAP DEPT.
DATE 4-29-68
6-118
Done 7/19/68