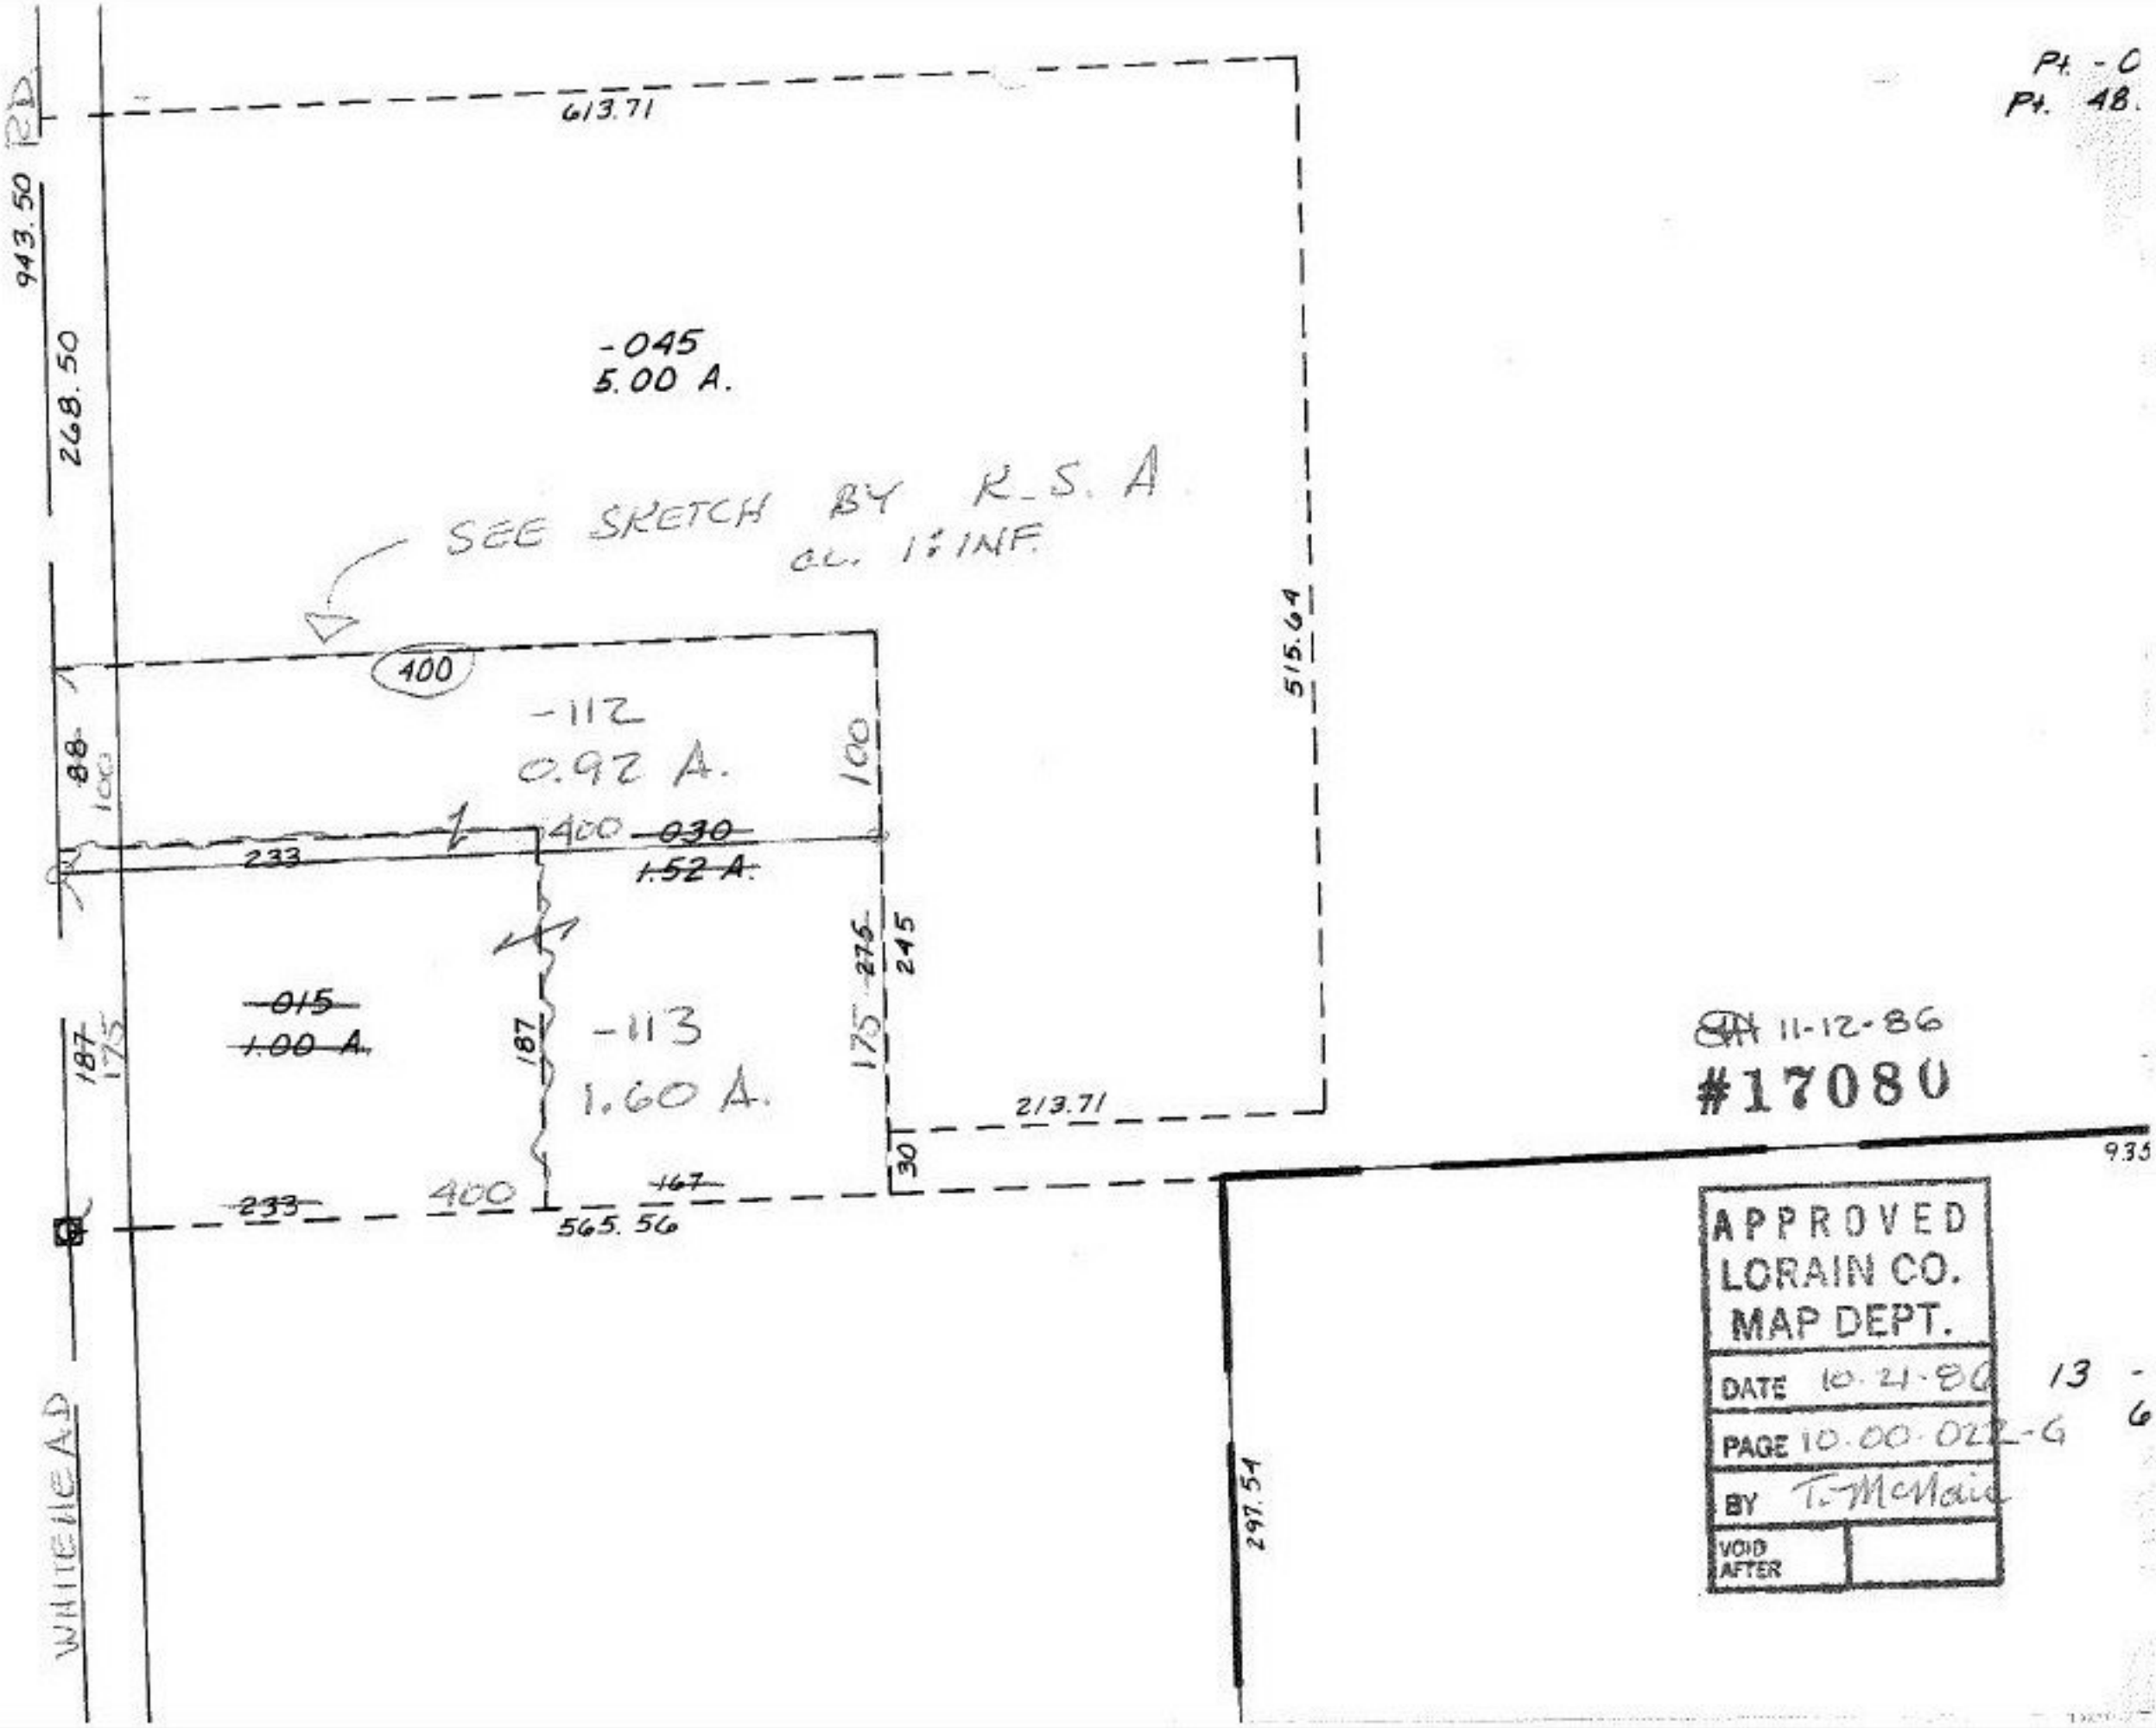

Pt. -0
Pt. 48.
RD
943.50
268.50
613.71
-045
5.00 A.
SEE SKETCH BY R.S.A
cc. 1:INF.
400
-112
0.92 A.
100
515.64
88
100
400
~~030~~
~~1.52 A.~~
233
~~015~~
~~1.00 A.~~
187
175
187
-113
1.60 A.
175
~~275~~
245
213.71
30
~~233~~
400
~~167~~
565.56
WHITEHEAD
297.54
935
11-12-86
#17080
APPROVED
LORAIN CO.
MAP DEPT.
DATE 10-21-86
PAGE 10.00.022-G
BY T. McNair
VOID AFTER
13 -
6