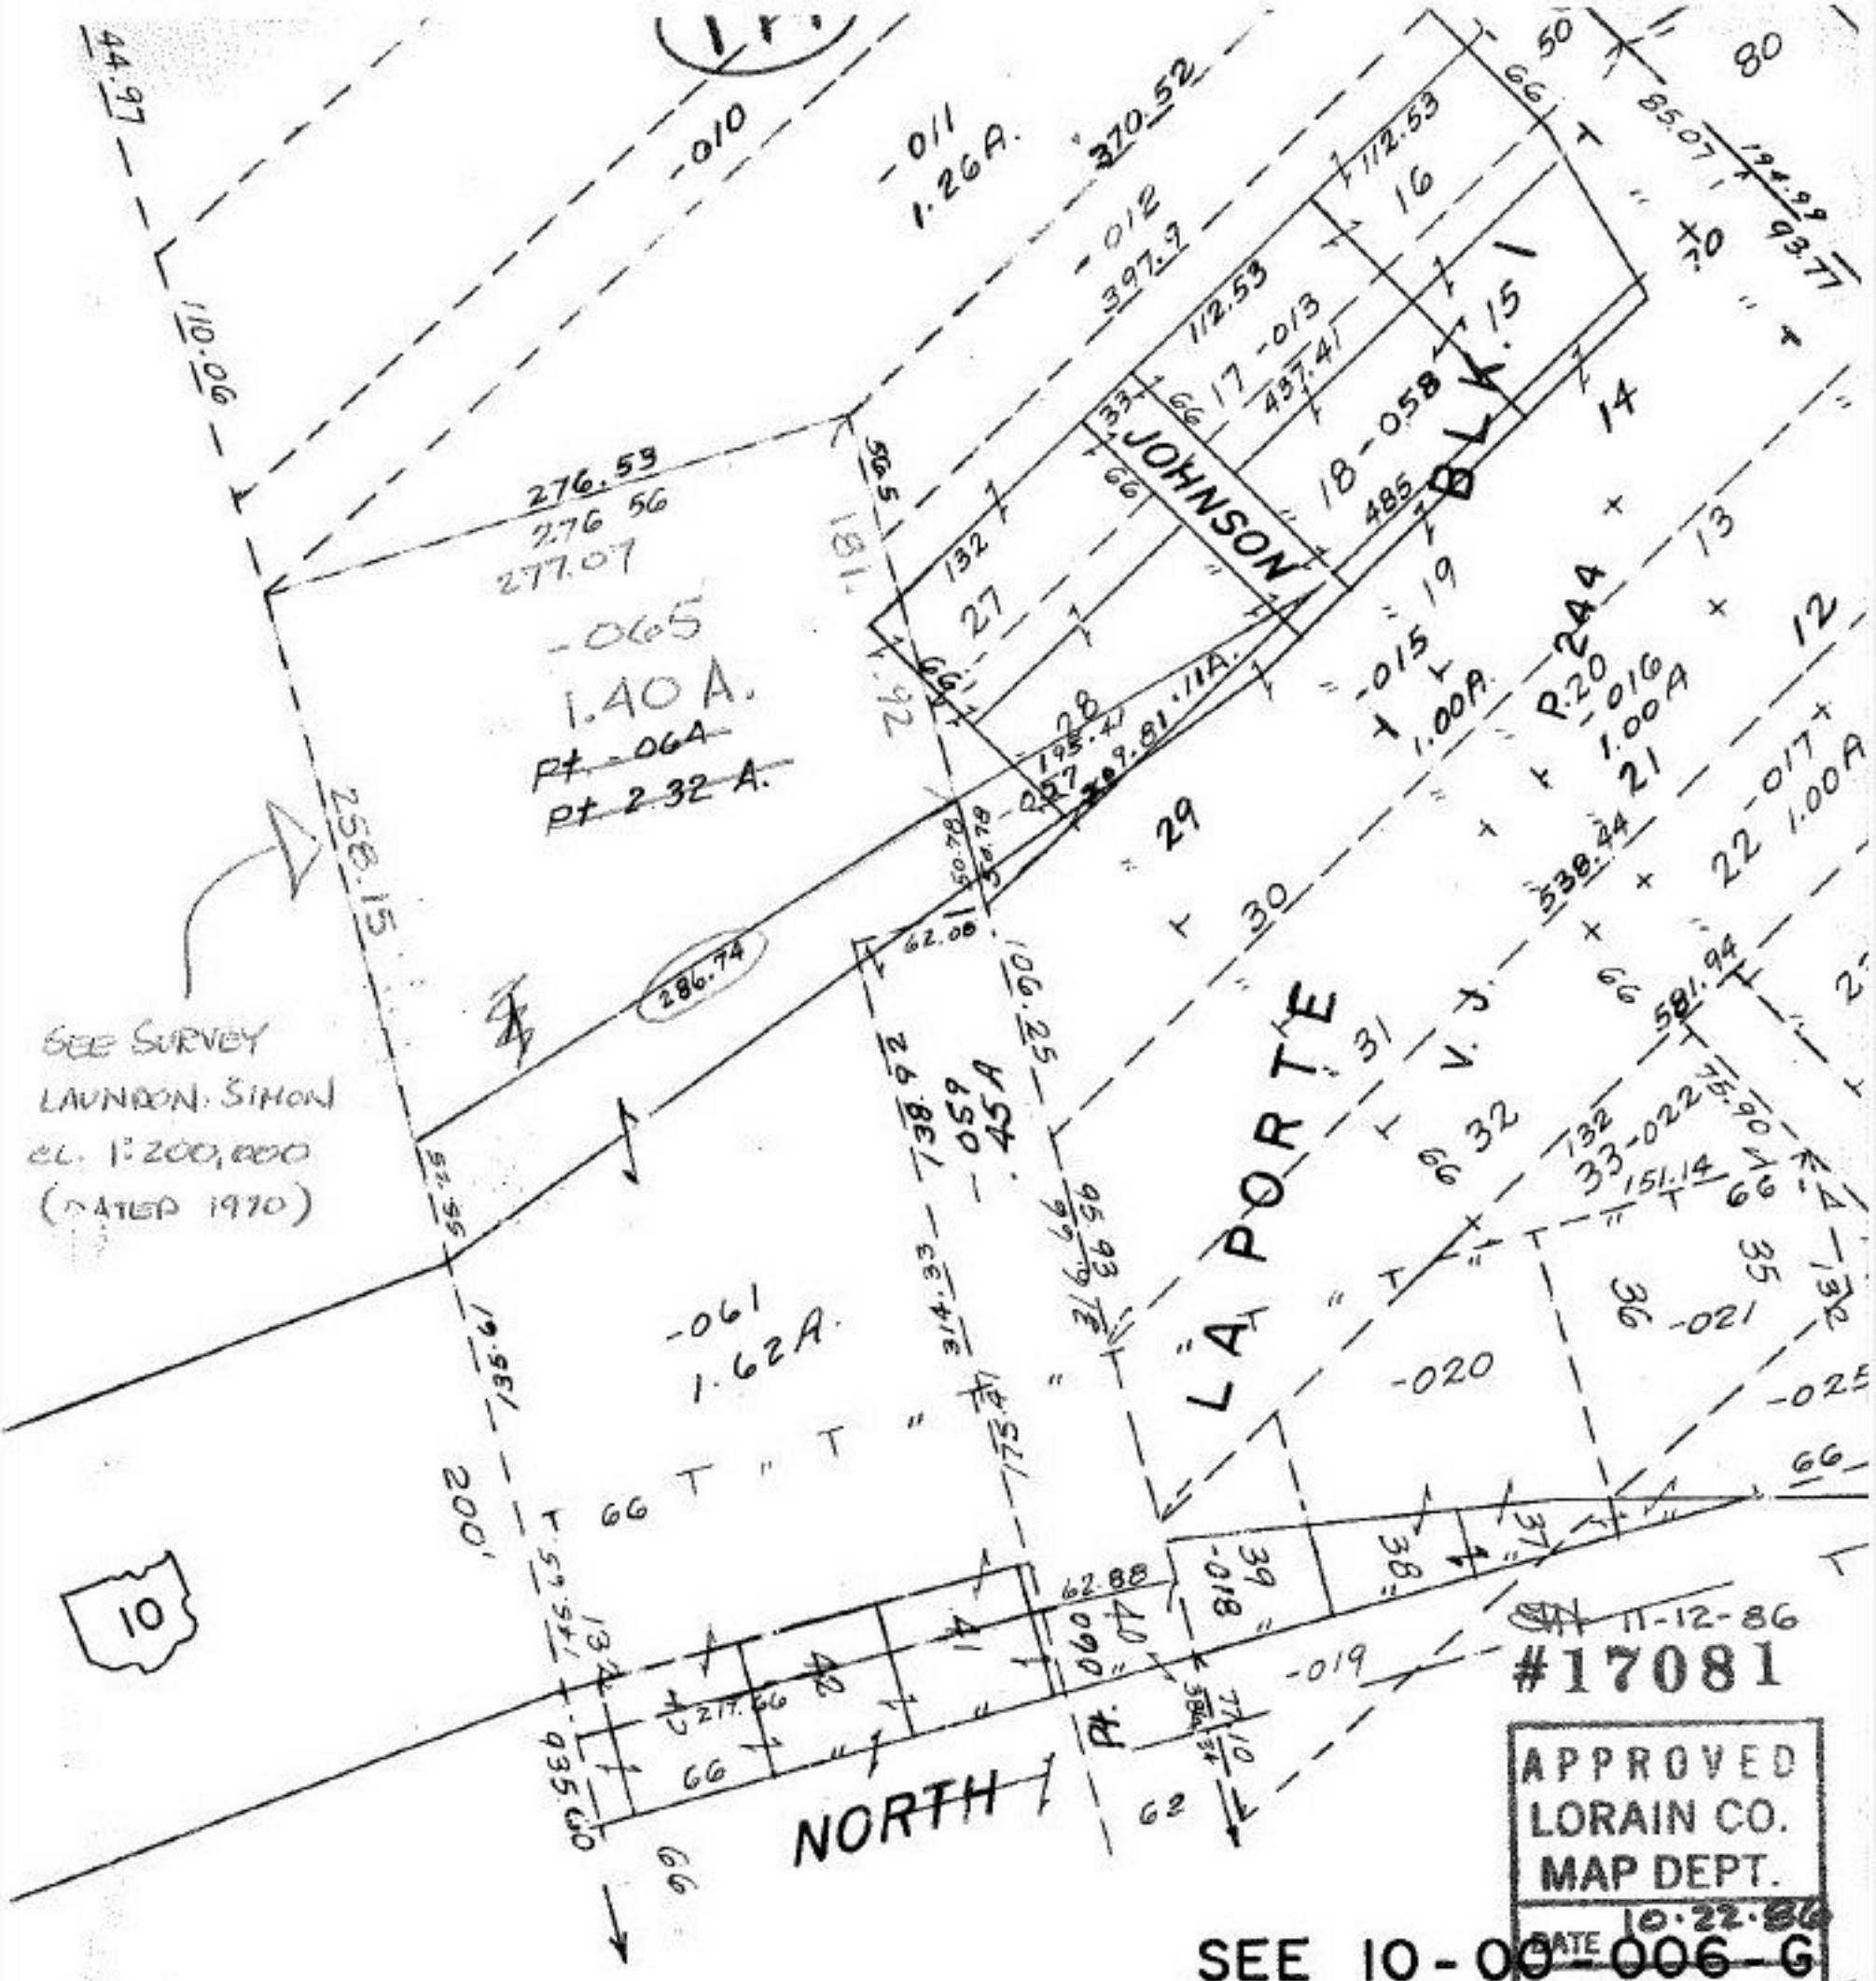

CARLISLE

E. 1/4 SEC. 6

SCALE 1" = 100'