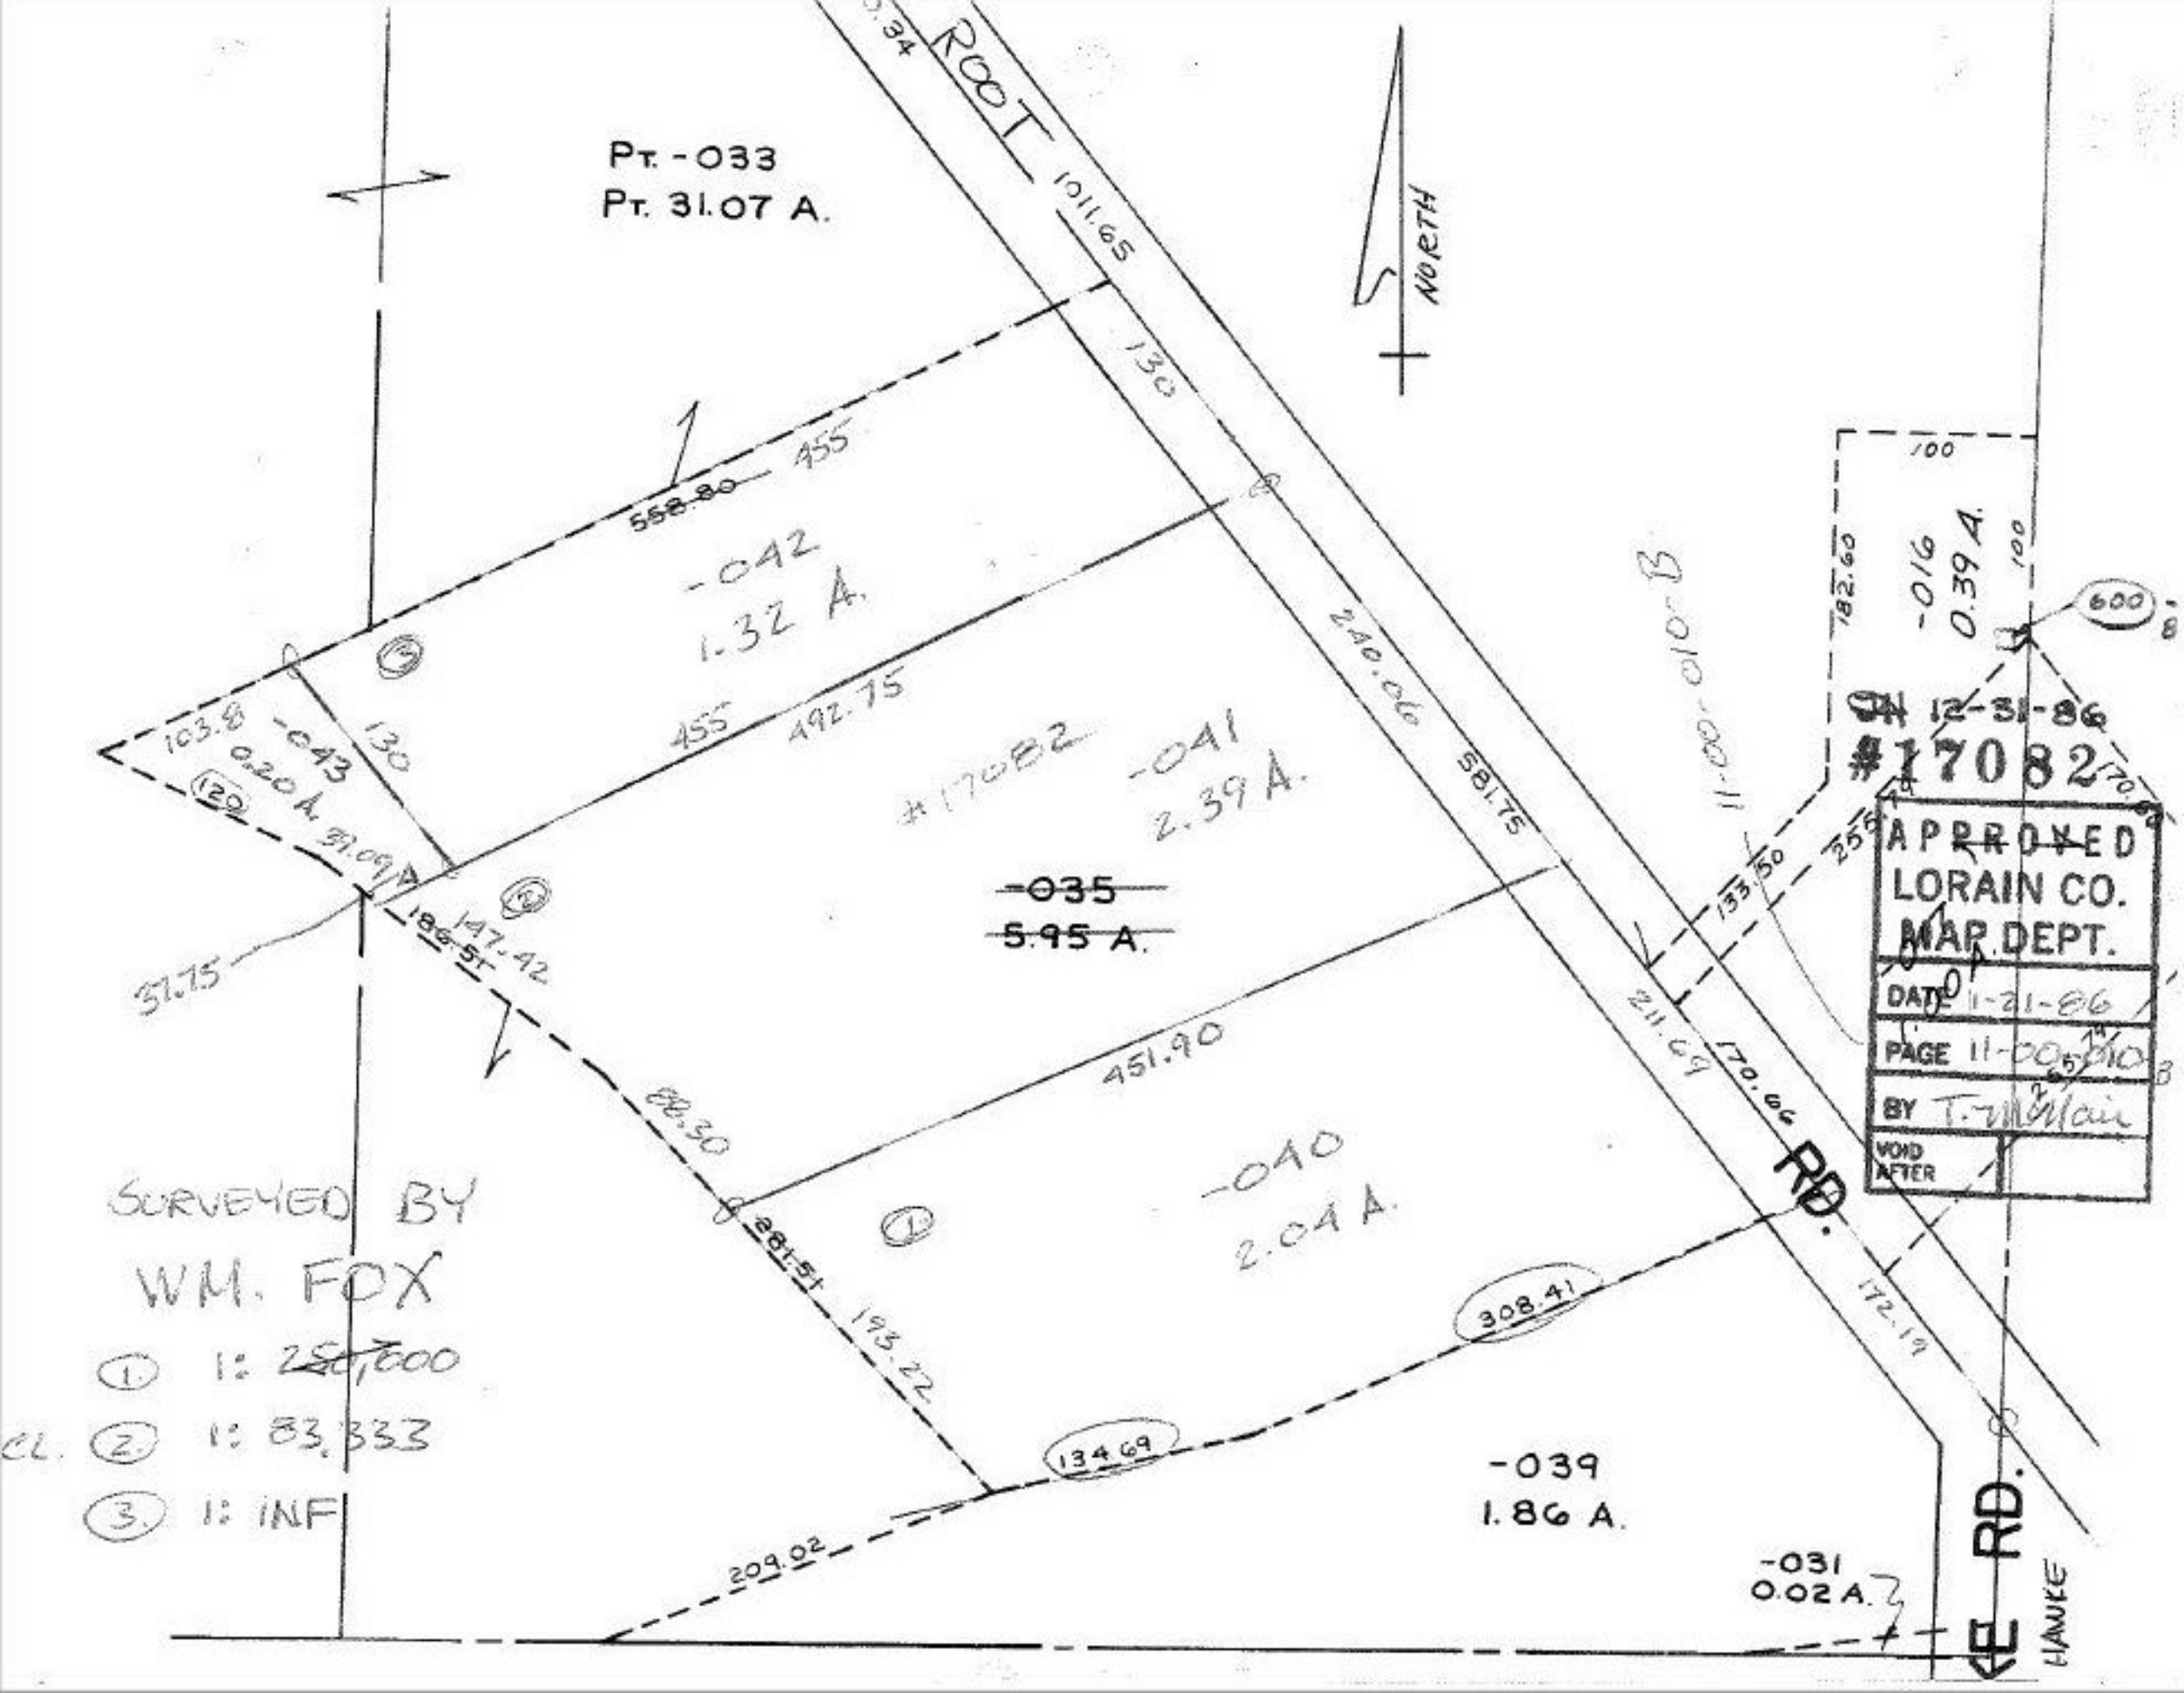

Pt. -033
Pt. 31.07 A.
ROOT
1011.65
130
NORTH
558.80
455
-042
1.32 A.
455
492.75
103.8
-043
0.20 A.
130
39.09 A
37.75
186.51
147.42
#17082
-041
2.39 A.
240.06
581.75
-035
5.95 A.
451.90
88.30
281.51
193.22
-040
2.04 A.
308.41
134.69
209.02
-039
1.86 A.
-031
0.02 A.
-016
0.39 A.
100
182.60
600
11-00-010-B
133.50
211.69
170.66
172.19
RD.
RD.
HANKE
SURVEYED BY
WM. FOX
1. 1: 250,000
CL. 2. 1: 83,333
3. 1: INF
JN 12-31-86
#17082
APPROVED
LORAIN CO.
MAP DEPT.
DATE 1-21-86
PAGE 11-00-010
BY T. McMain
VOID AFTER