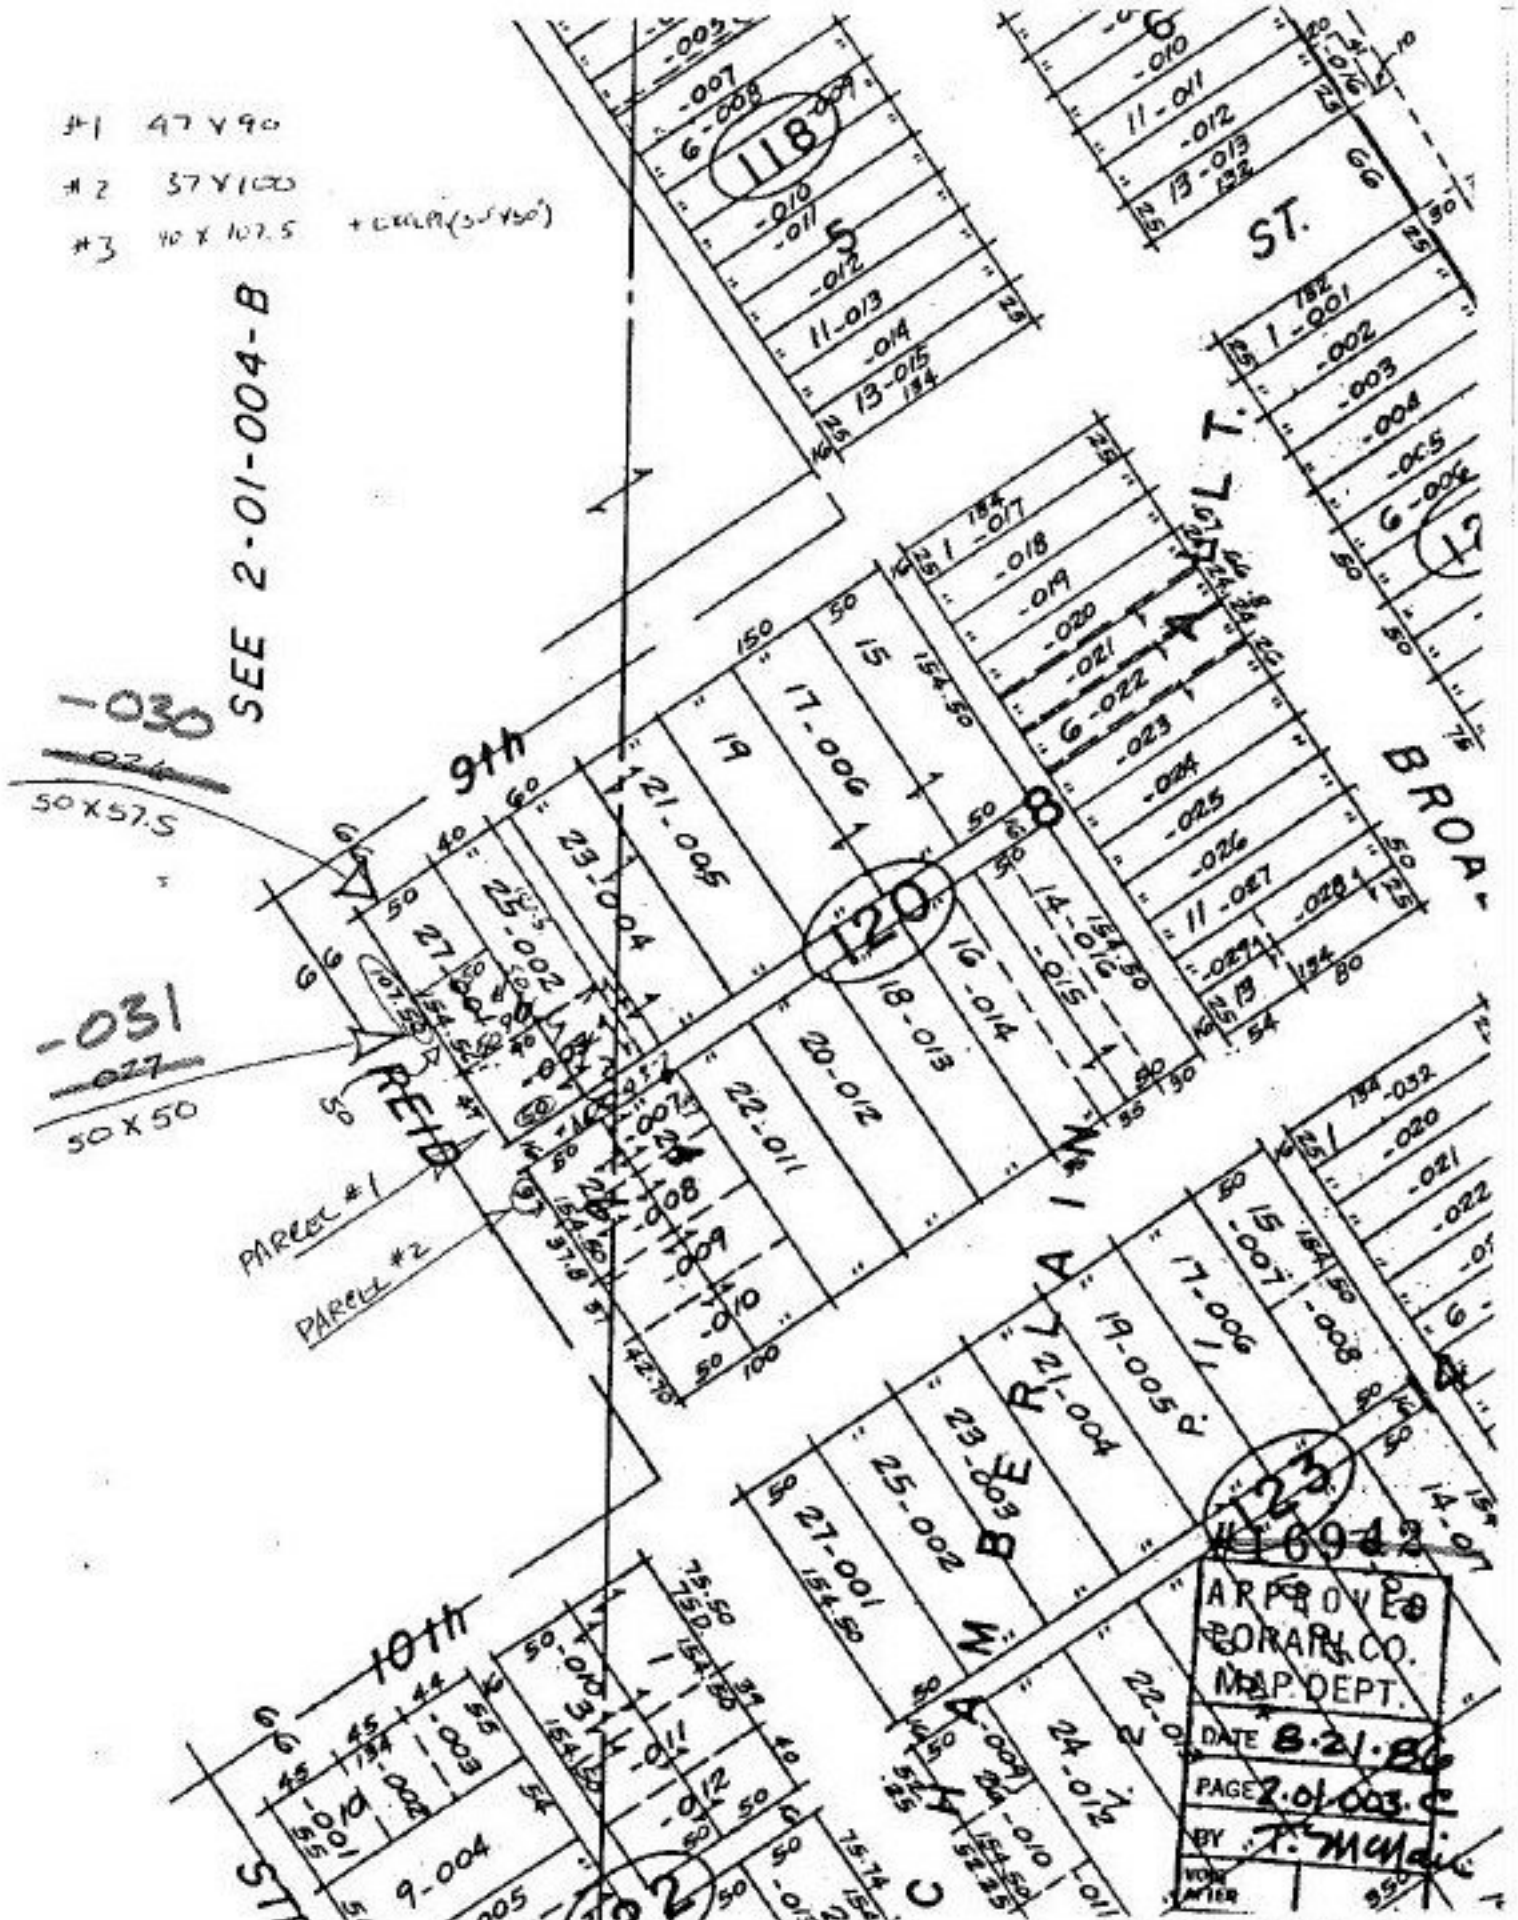

SH 11-12-86 #17083

PARCEL NO. CORRECTION

APPROVED
LORAIN CO.
MAP DEPT.
PAGE 2.01.003.C
BY T. McMair
VOID AFTER