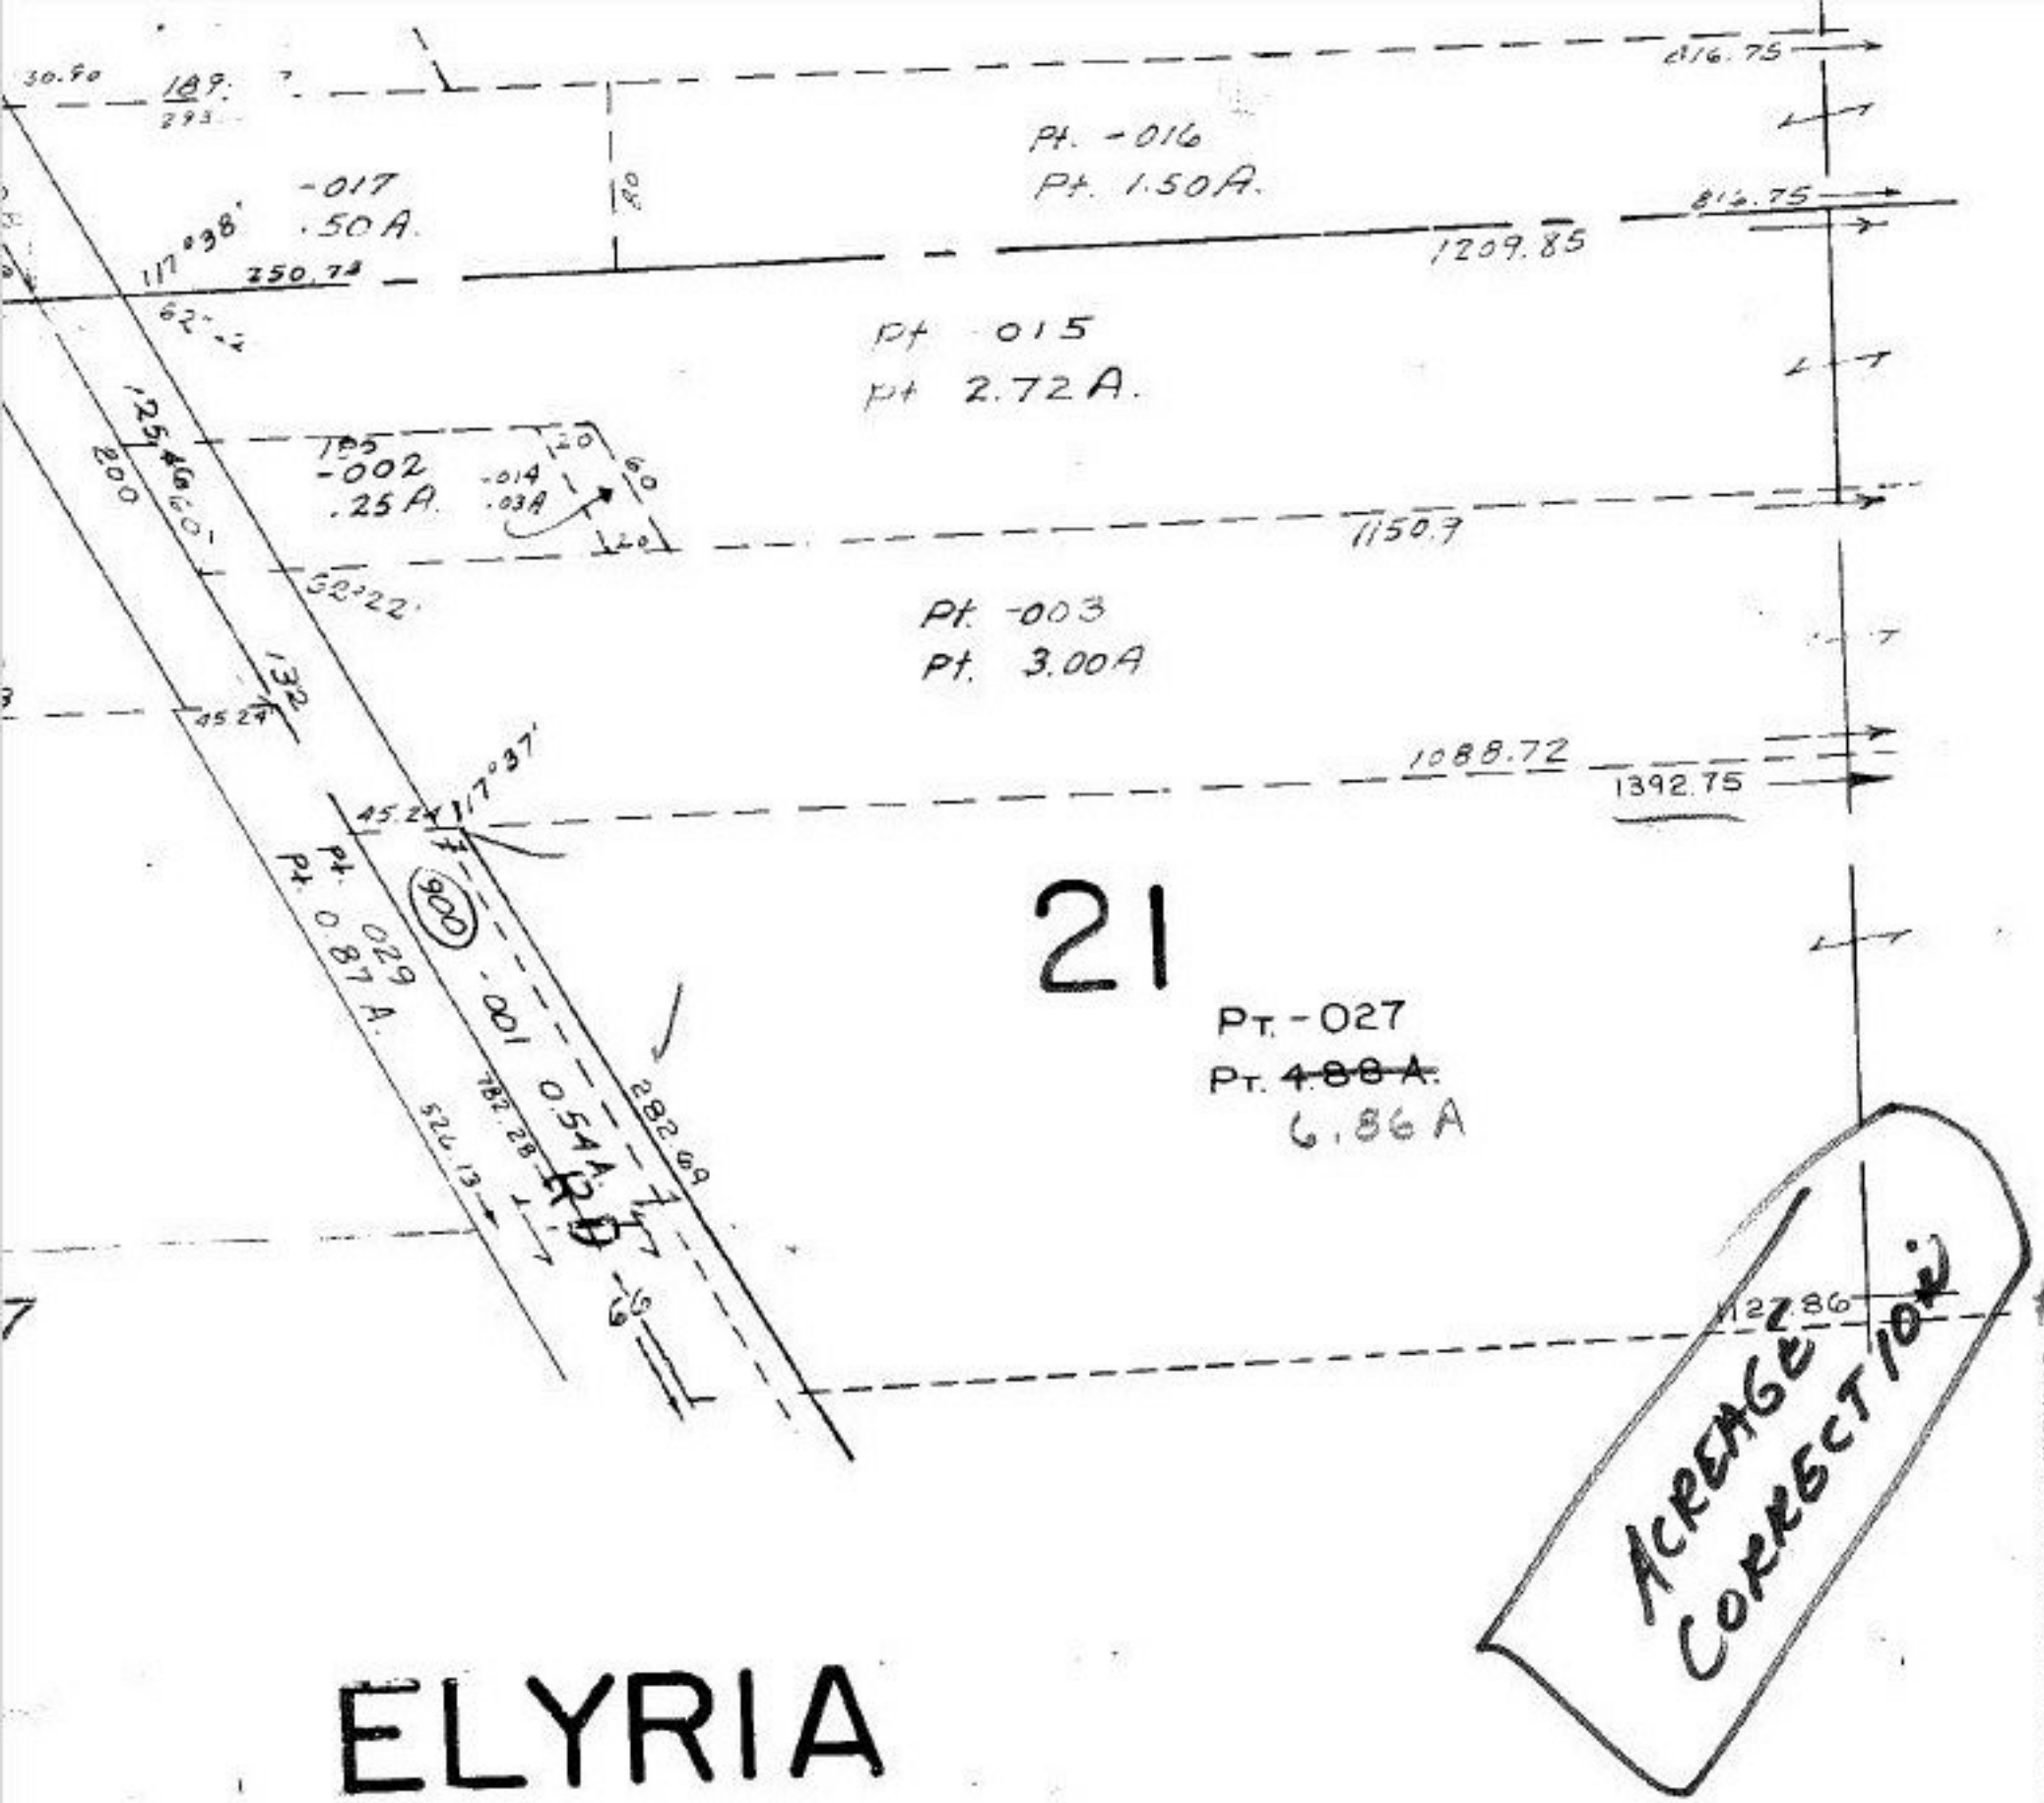

#17084
4-3-87

APPROVED
LORAIN CO.
MAP DEPT.
DATE 10-29-86
PAGE 6-29
BY [signature]
VOID AFTER 17084

ELYRIA

SCALE 1" = 100'