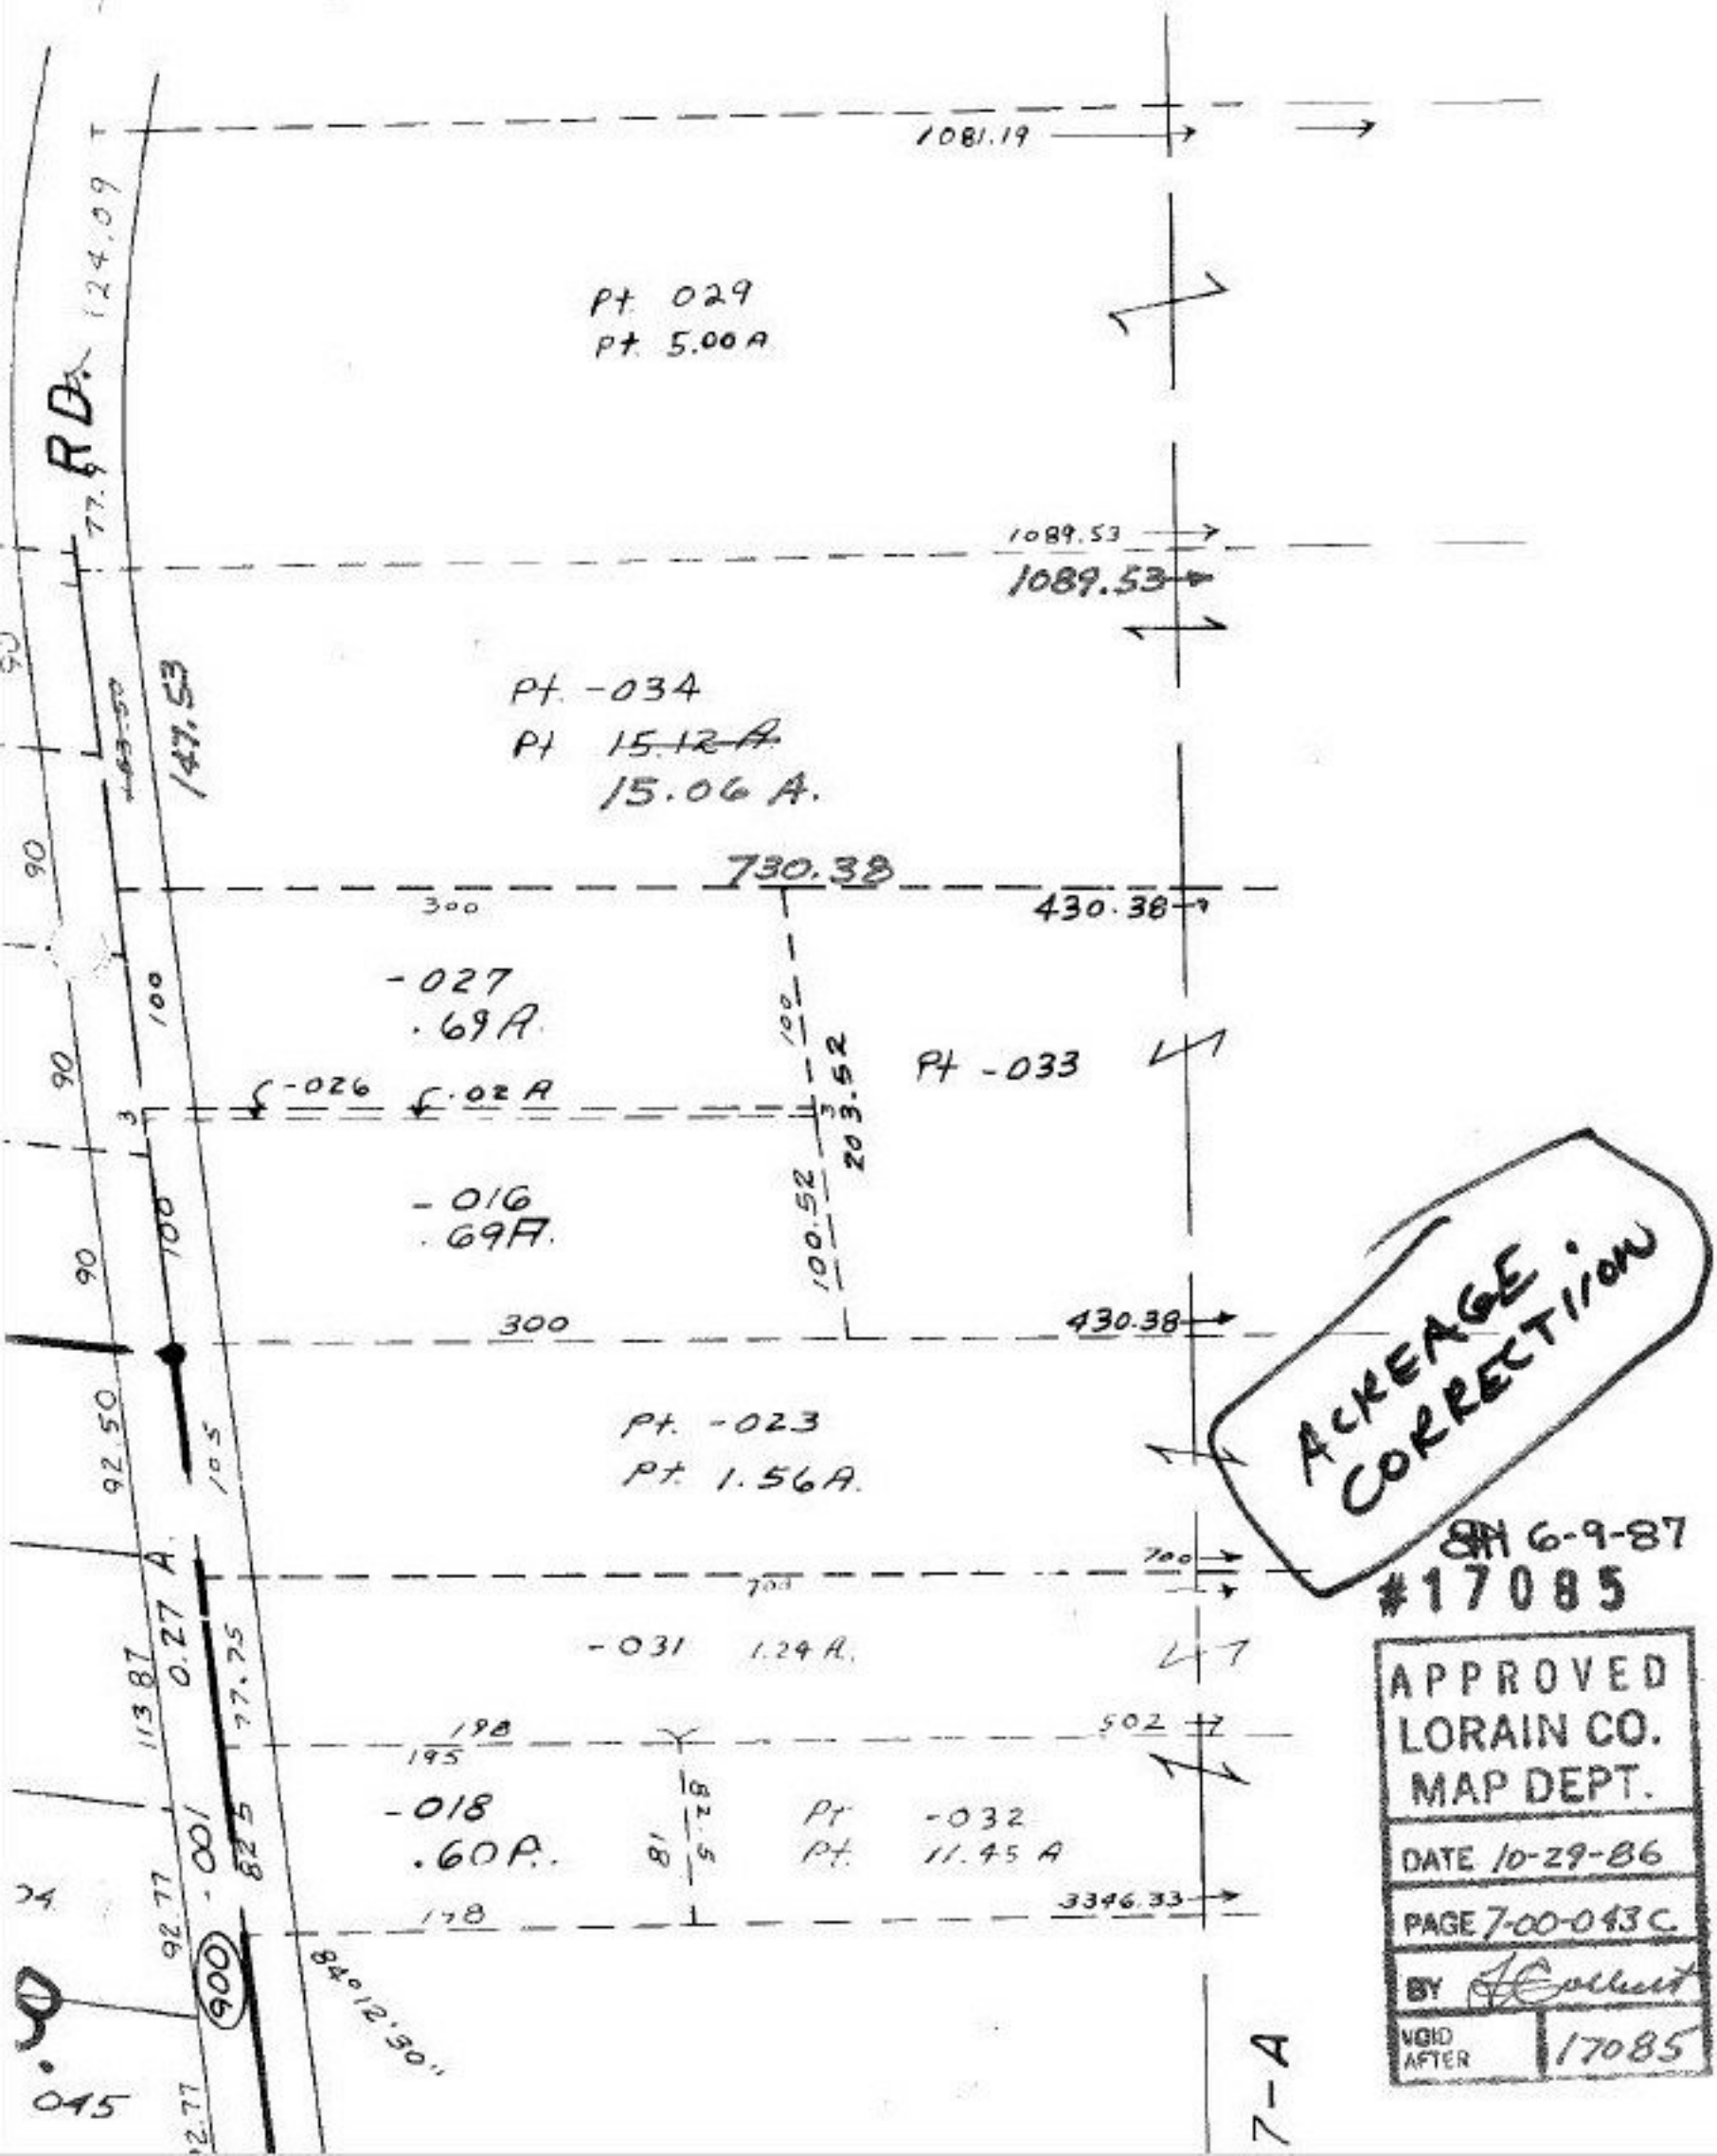

ACREAGE CORRECTION

SH 6-9-87

#17085

APPROVED
LORAIN CO.
MAP DEPT.

DATE 10-29-86

PAGE 7-00-043C

BY [signature]

VOID AFTER 17085