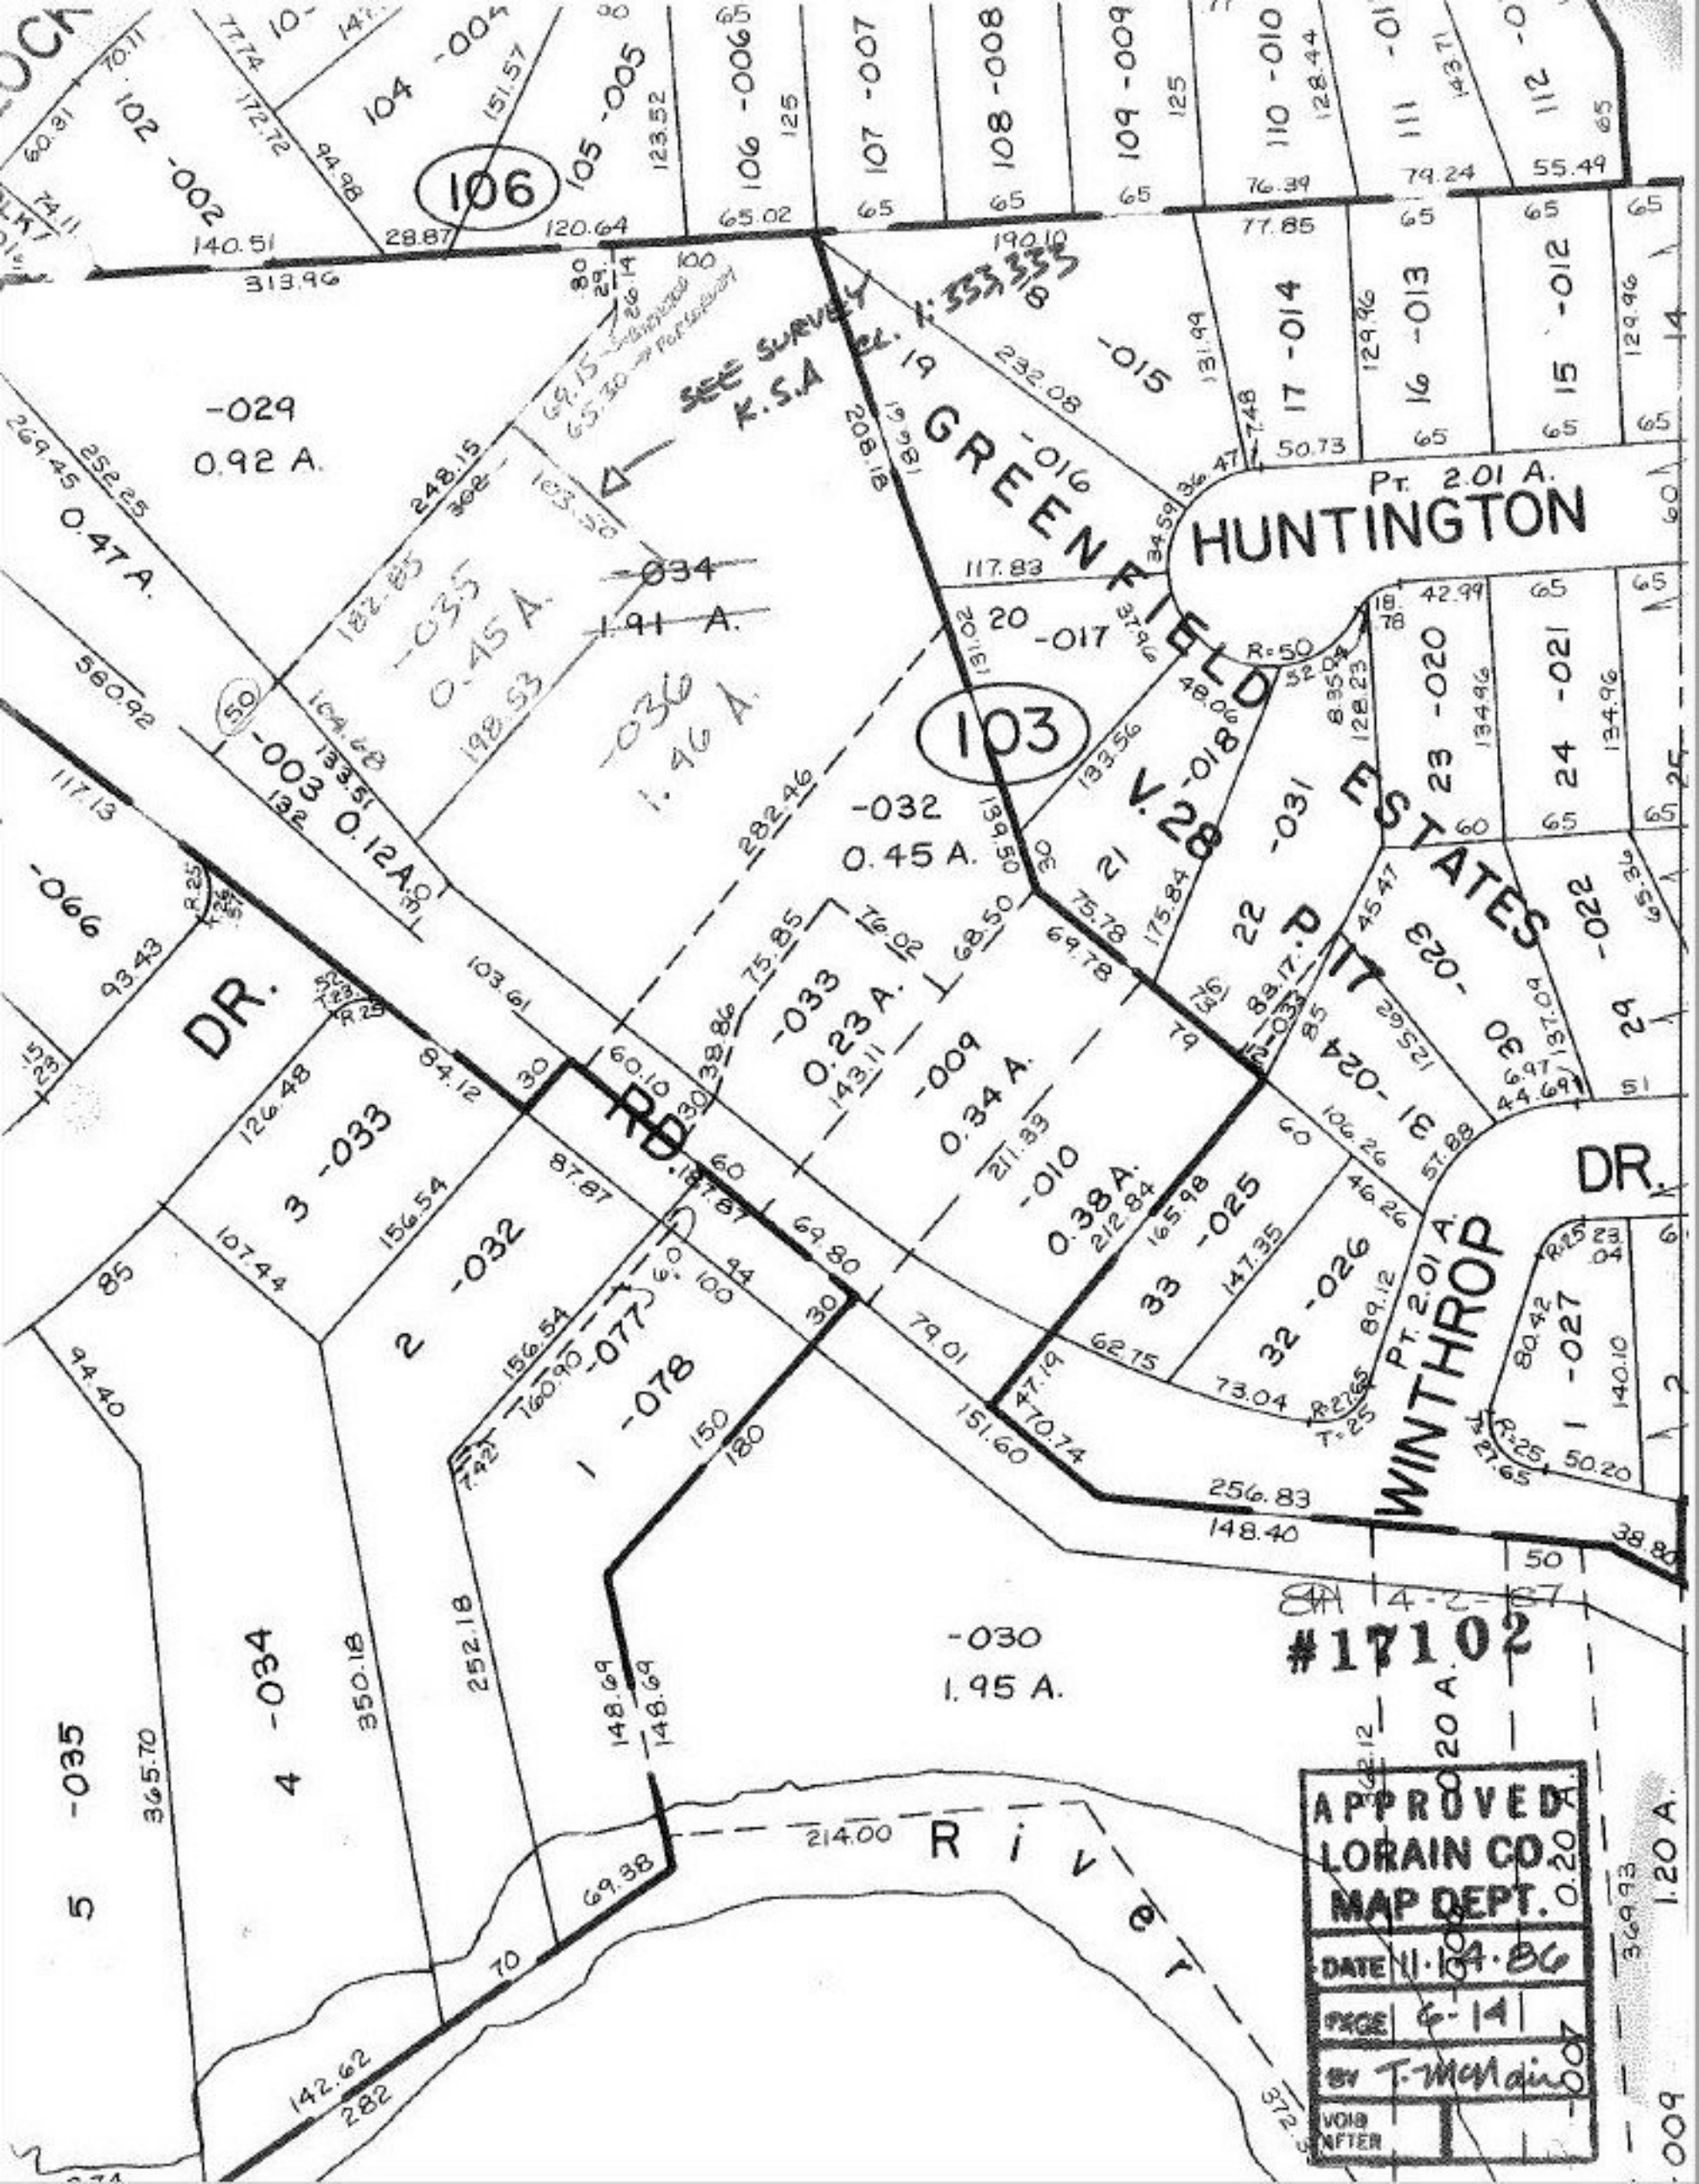

106
103
GREENFIELD
HUNTINGTON
ESTATES
WINTHROP
DR.
RD.
River
SEE SURVEY K.S.A
CL. 1:333,333
-029
0.92 A.
-034
1.91 A.
-035
0.45 A.
-036
1.46 A.
-032
0.45 A.
-033
0.23 A.
-009
0.34 A.
-010
0.38 A.
-030
1.95 A.
-003
0.12 A.
-066
-017
-016
-015
-018
-031
-022
-023
-024
-025
-026
-027
-077
-078
-034
-035
-032
-033
-034
-035
-007
-009
1.20 A.
0.20 A.
#17102
APPROVED
LORAIN CO.
MAP DEPT.
DATE 11-14-86
PAGE 6-14
BY T. McMain
VOID AFTER