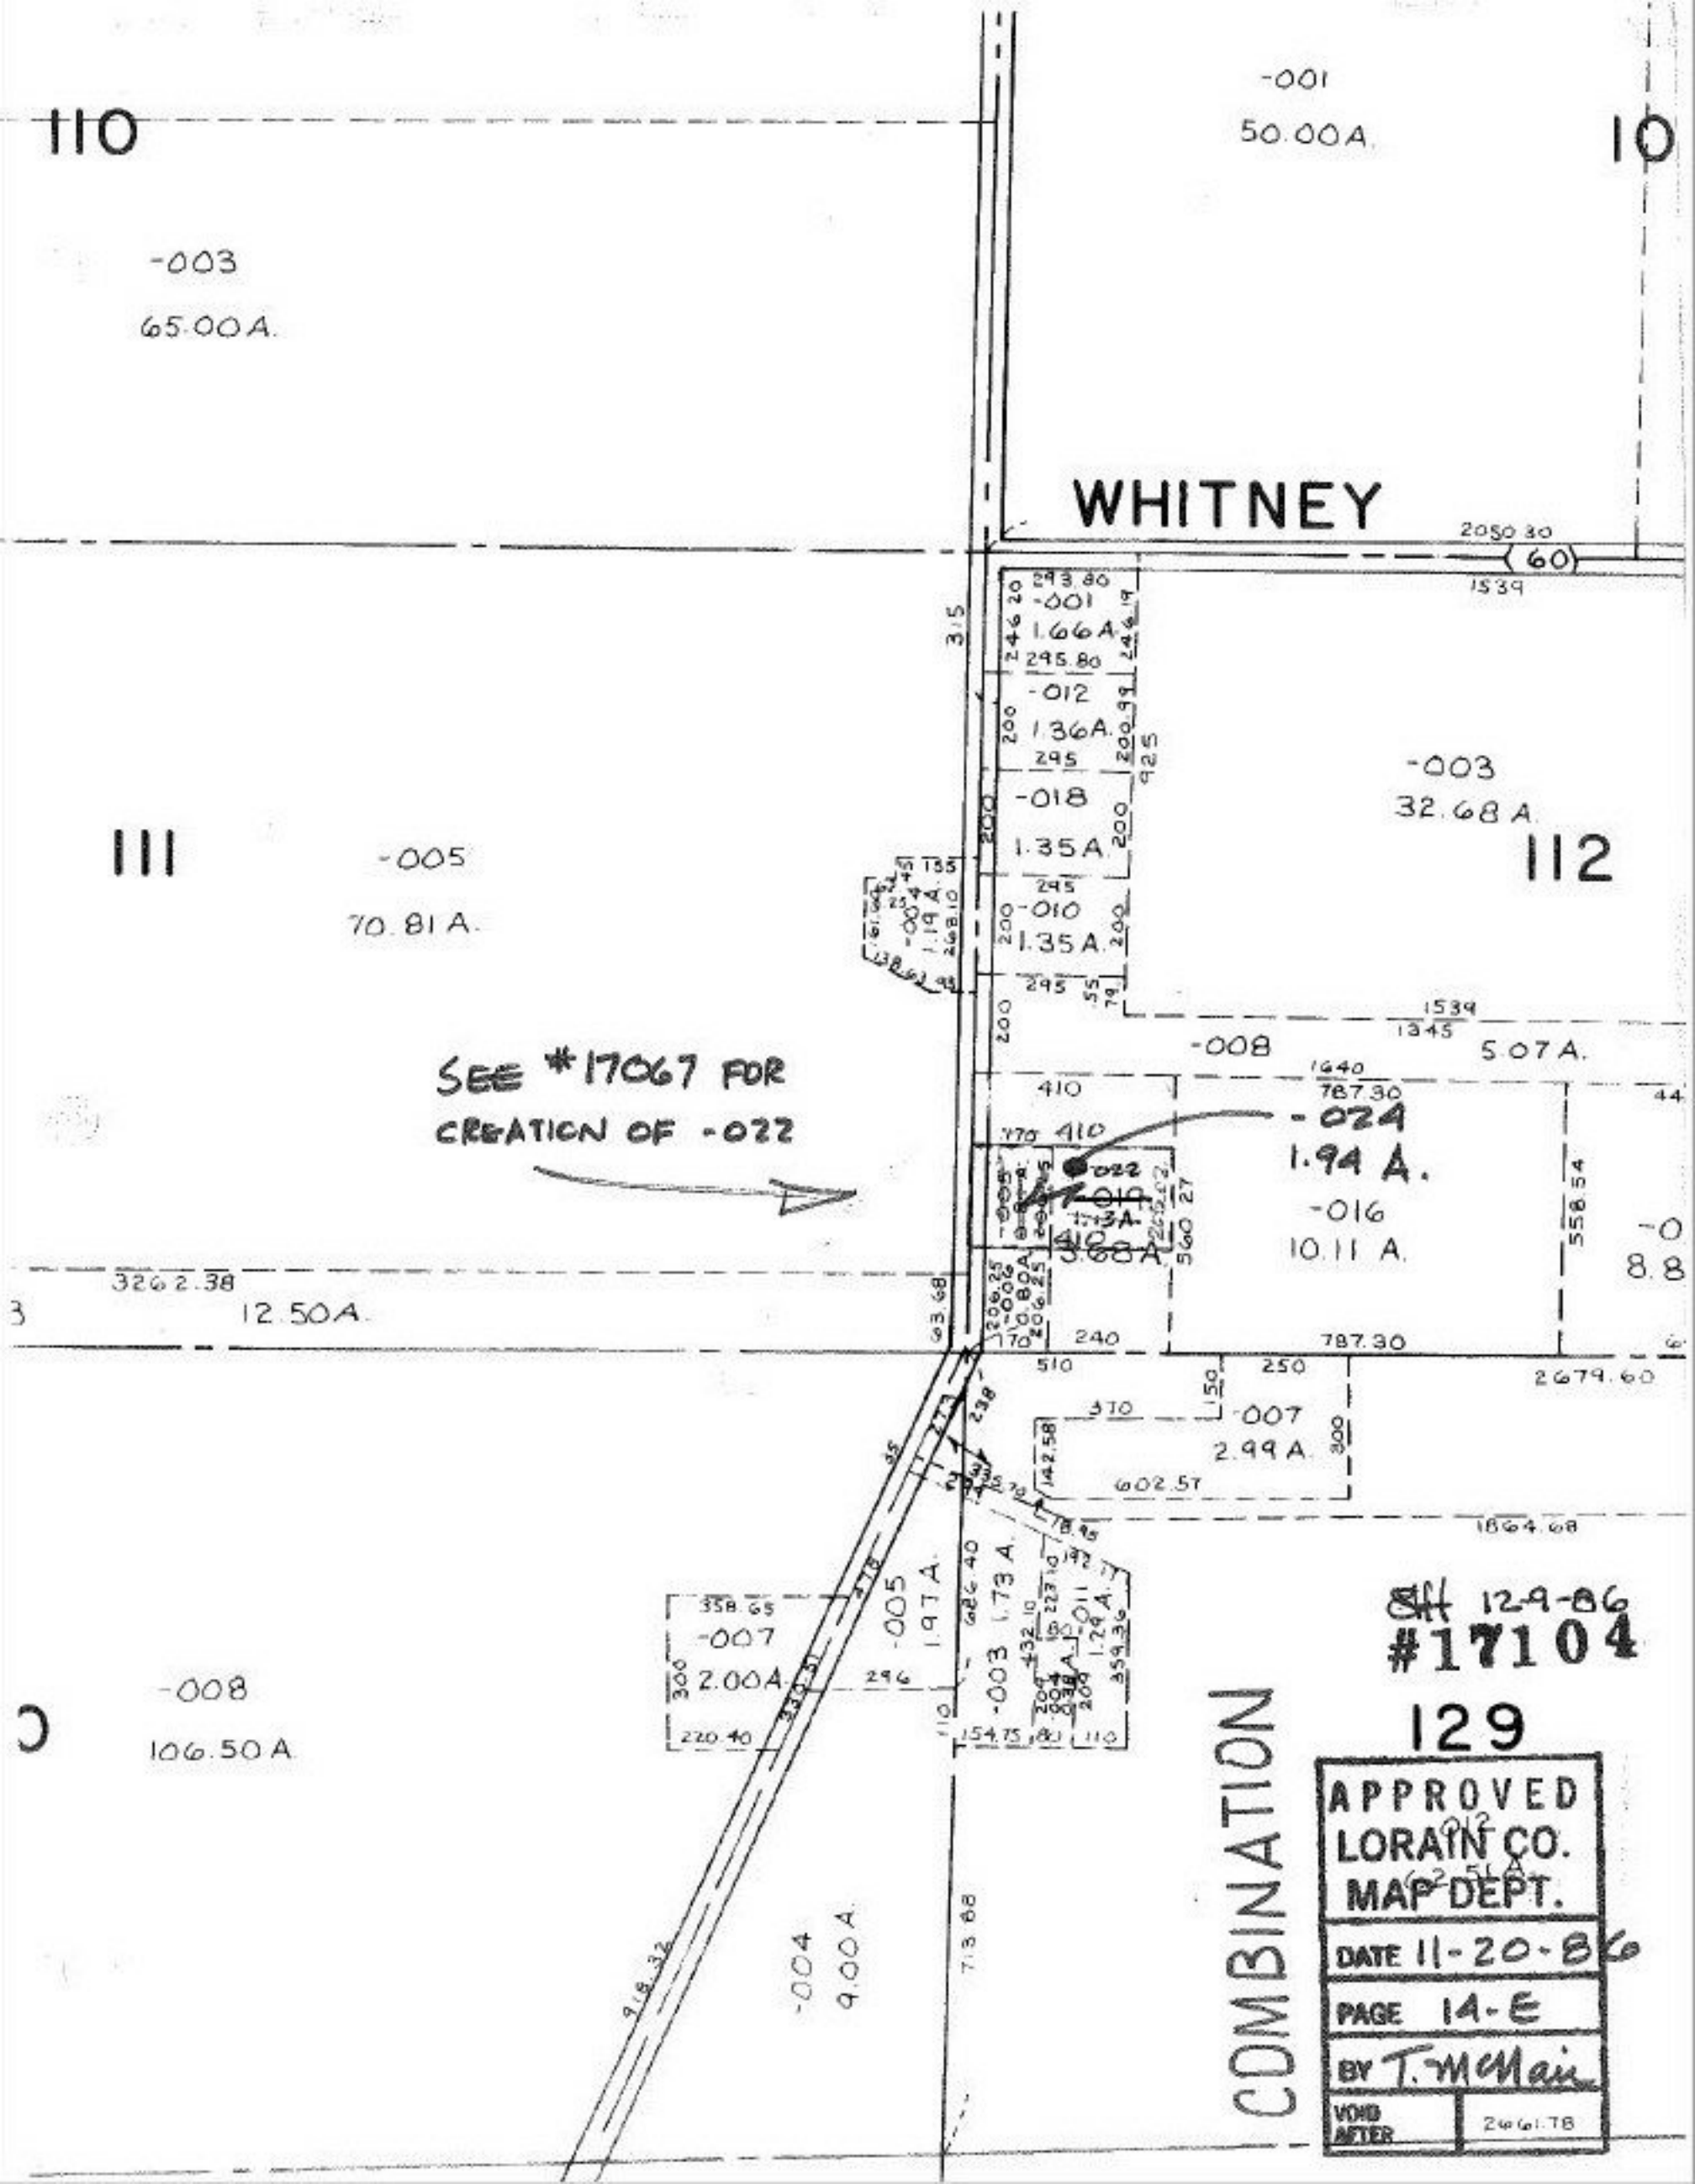
110
-001
50.00A.
10
-003
65.00A.
WHITNEY
2050.30
60
1539
-001
1.66A.
-012
1.36A.
-018
1.35A.
-010
1.35A.
-003
32.68A.
111
-005
70.81A.
112
-008
5.07A.
SEE #17067 FOR
CREATION OF -022
-024
1.94 A.
-016
10.11 A.
3262.38
12.50A.
-007
2.99A.
2679.60
1864.68
-007
2.00A.
-005
1.97A.
-003
1.73A.
-008
106.50A.
-004
9.00A.
COMBINATION
129
APPROVED
LORAIN CO.
MAP DEPT.
DATE 11-20-86
PAGE 14-E
BY T. McMain
VOID AFTER
2661.78
12-9-86
#17104