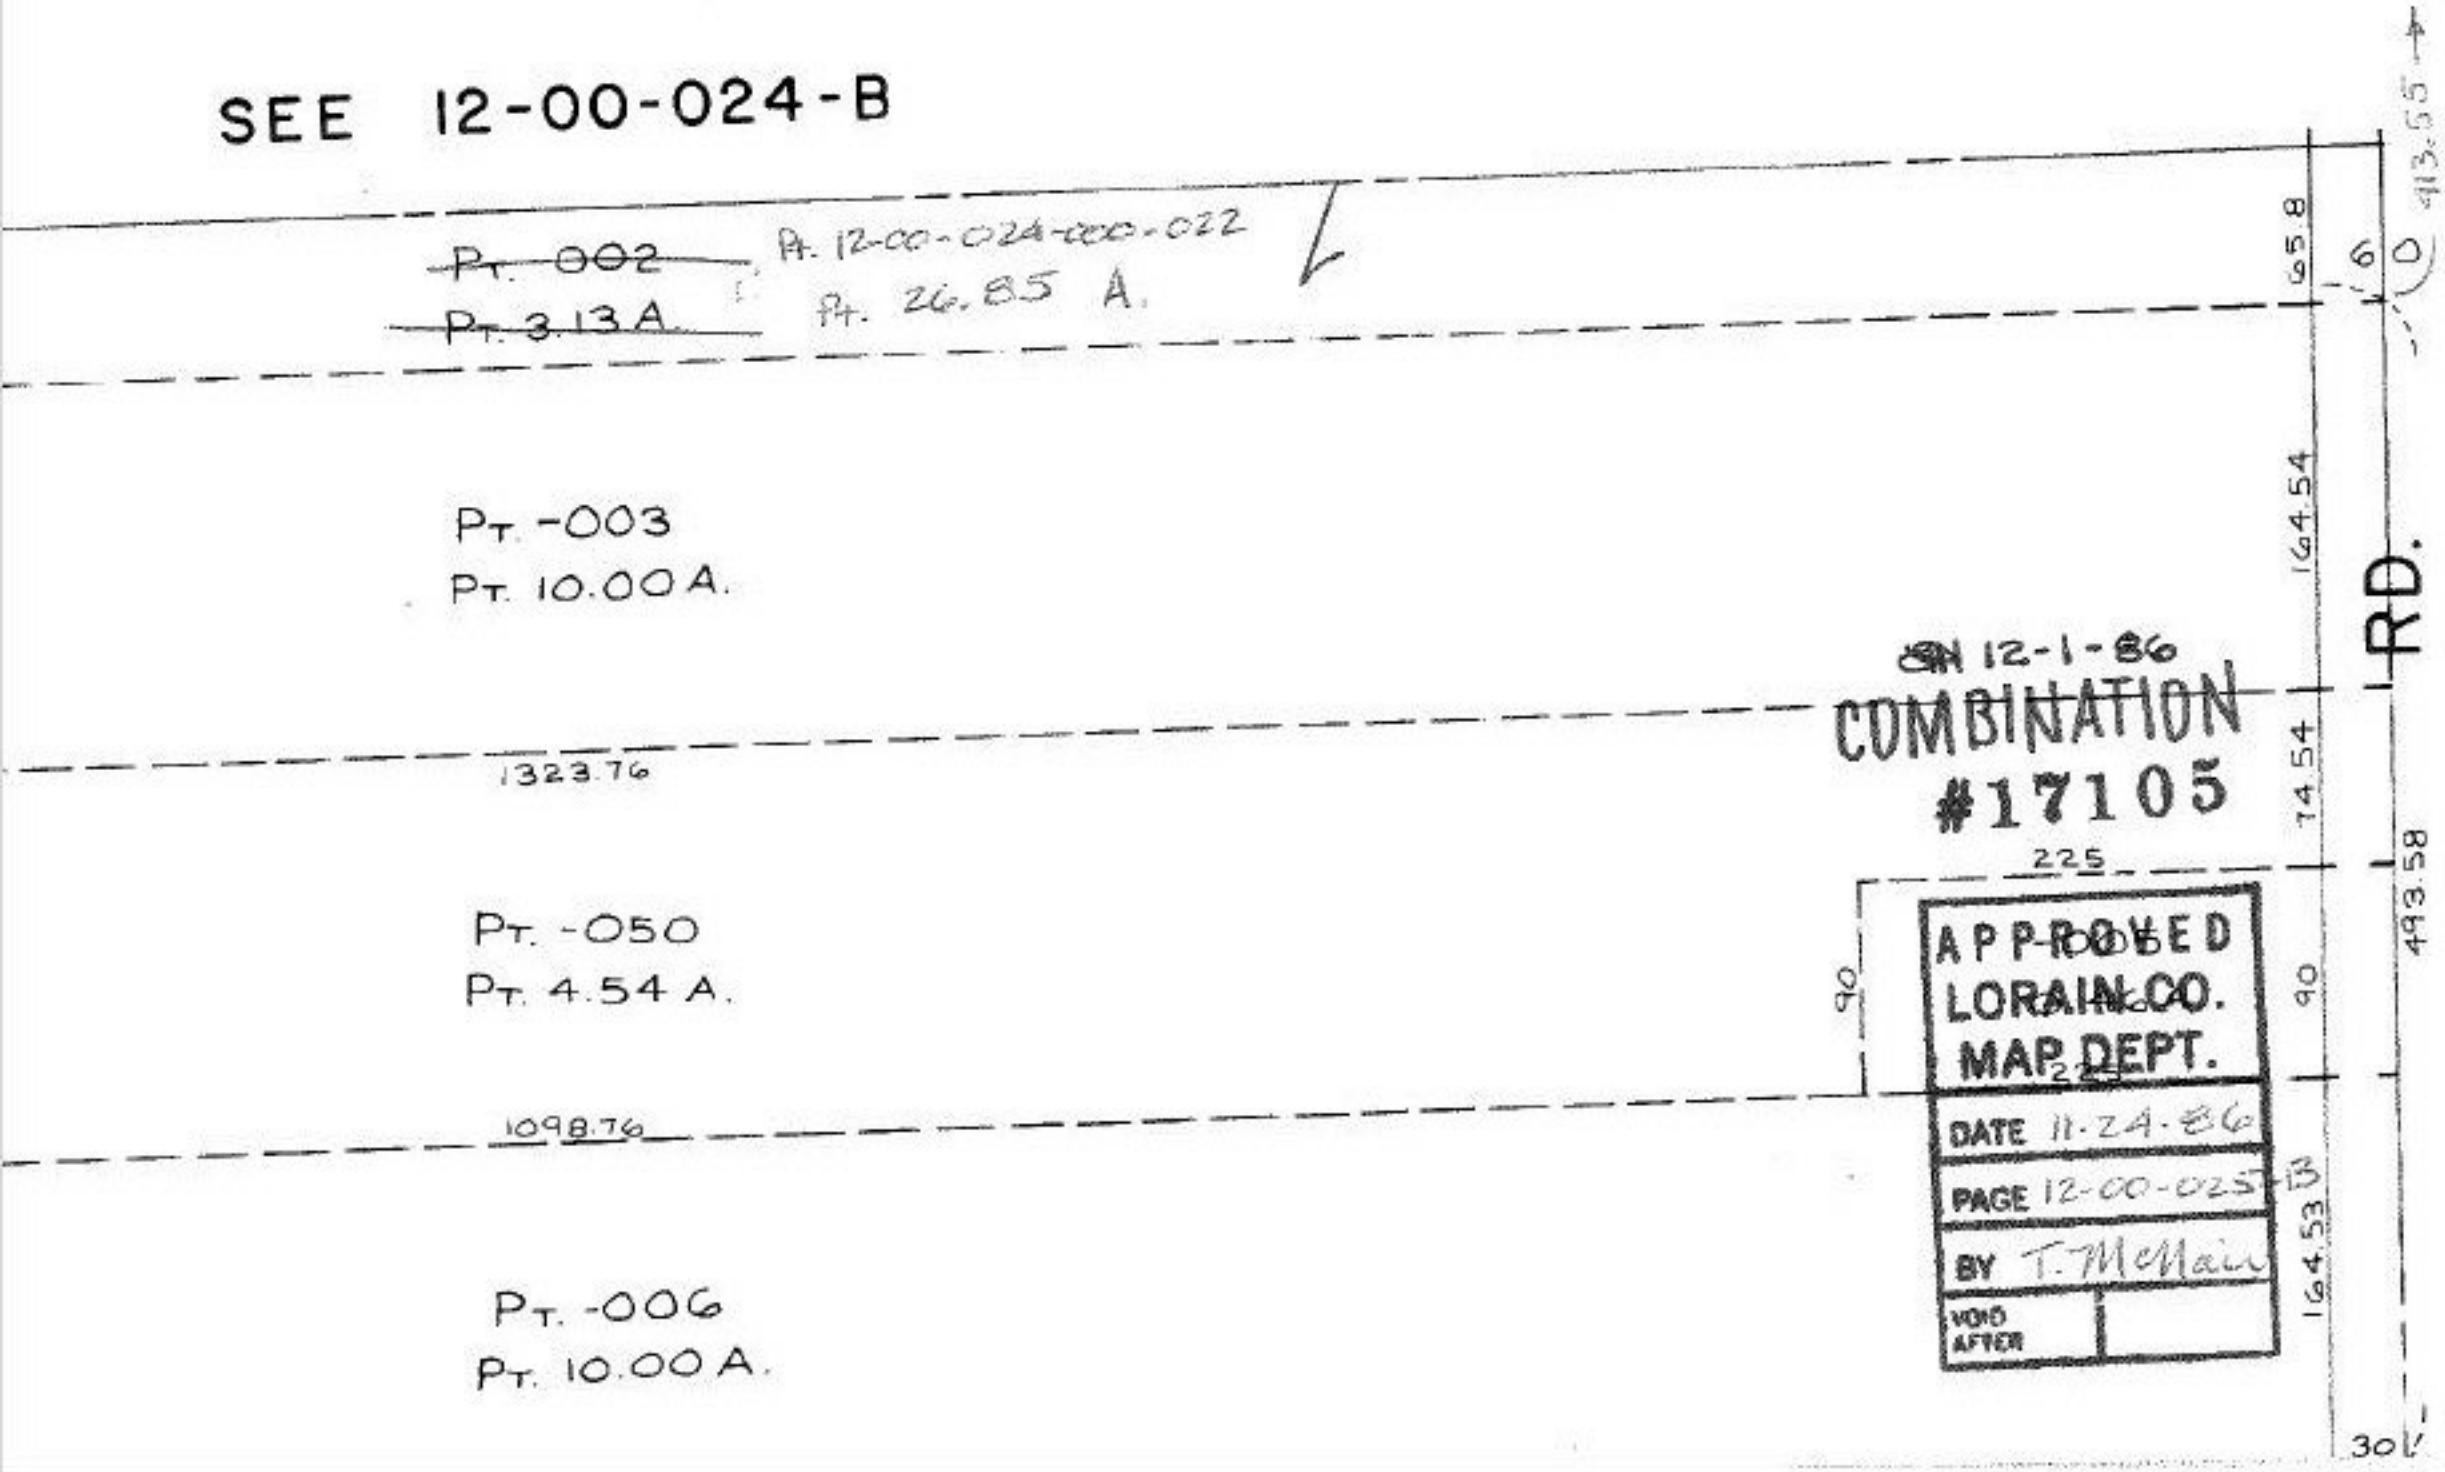
SEE 12-00-024-B
~~Pt. 002~~
~~Pt. 3.13 A.~~
Pt. 12-00-024-000-022
Pt. 26.85 A.
Pt. -003
Pt. 10.00 A.
1323.76
Pt. -050
Pt. 4.54 A.
1098.76
Pt. -006
Pt. 10.00 A.
12-1-86
COMBINATION
#17105
APPROVED
LORAIN CO.
MAP DEPT.
DATE 11-24-86
PAGE 12-00-025-B
BY T. McNair
VOID AFTER
65.8
164.54
74.54
90
164.53
413.55
493.58
RD.
30