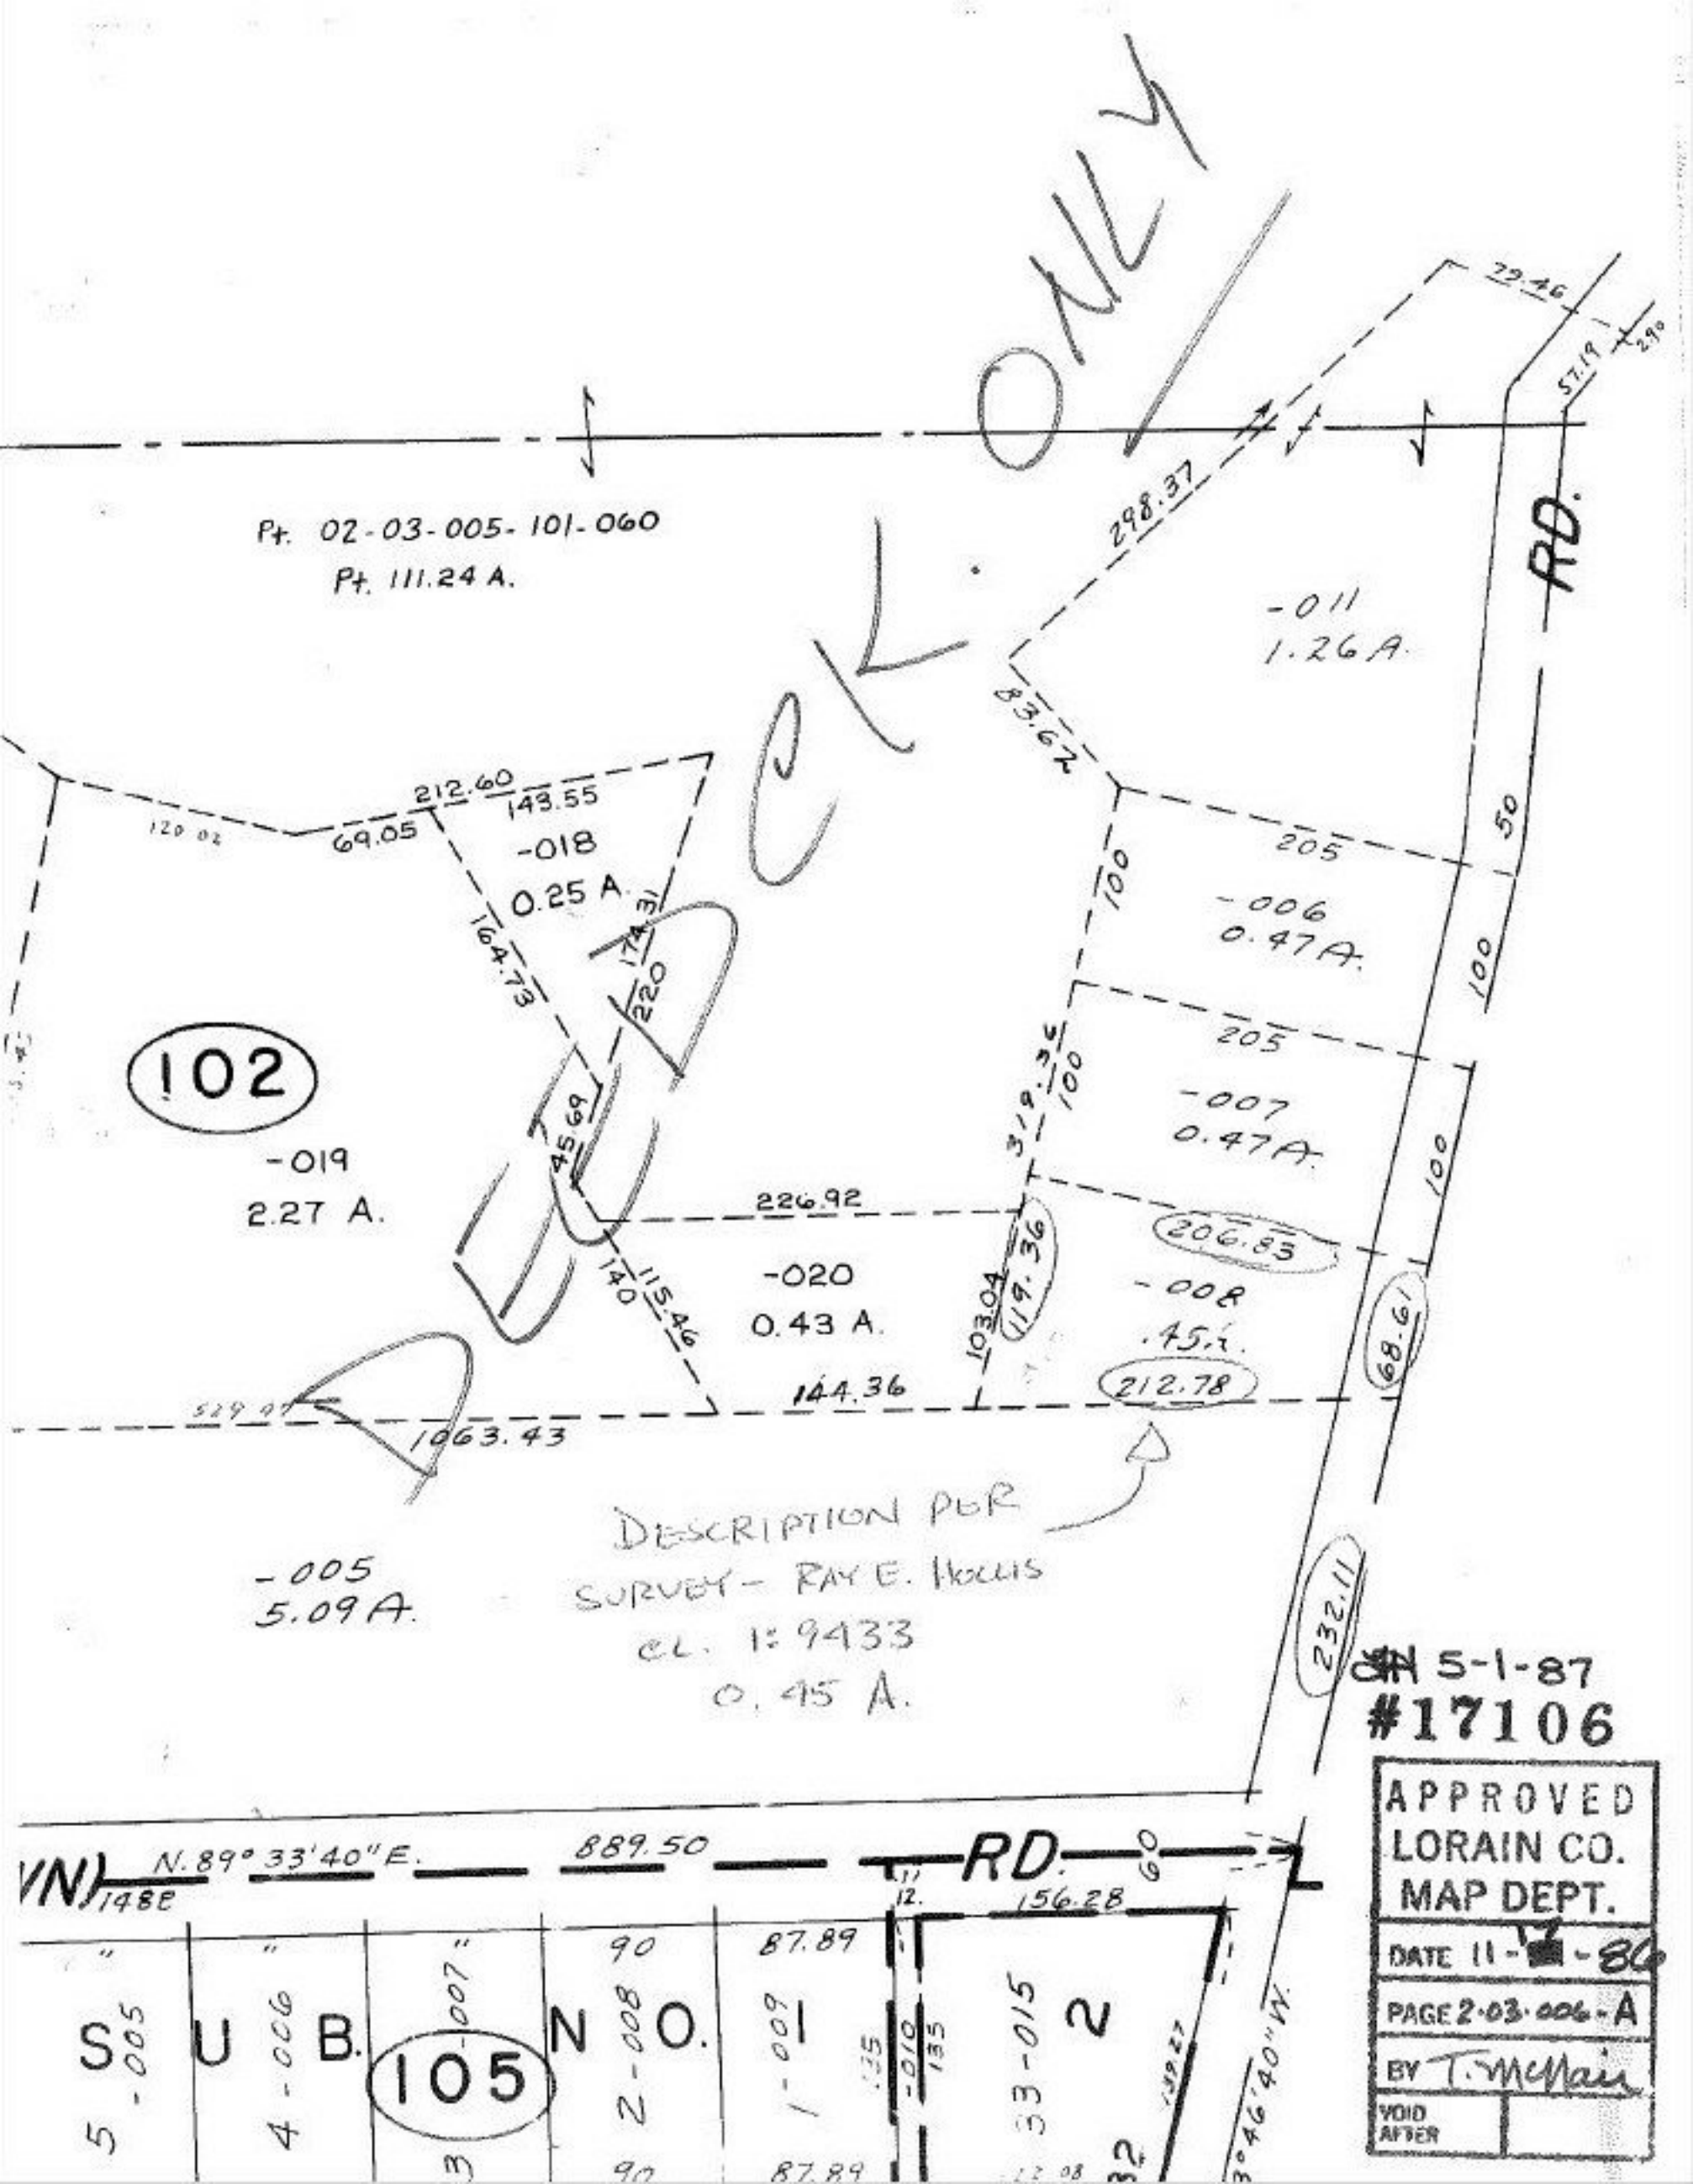

5-1-87
#17106

APPROVED
LORAIN CO.
MAP DEPT.
DATE 11-17-86
PAGE 2-03-006-A
BY T. McNair
VOID AFTER