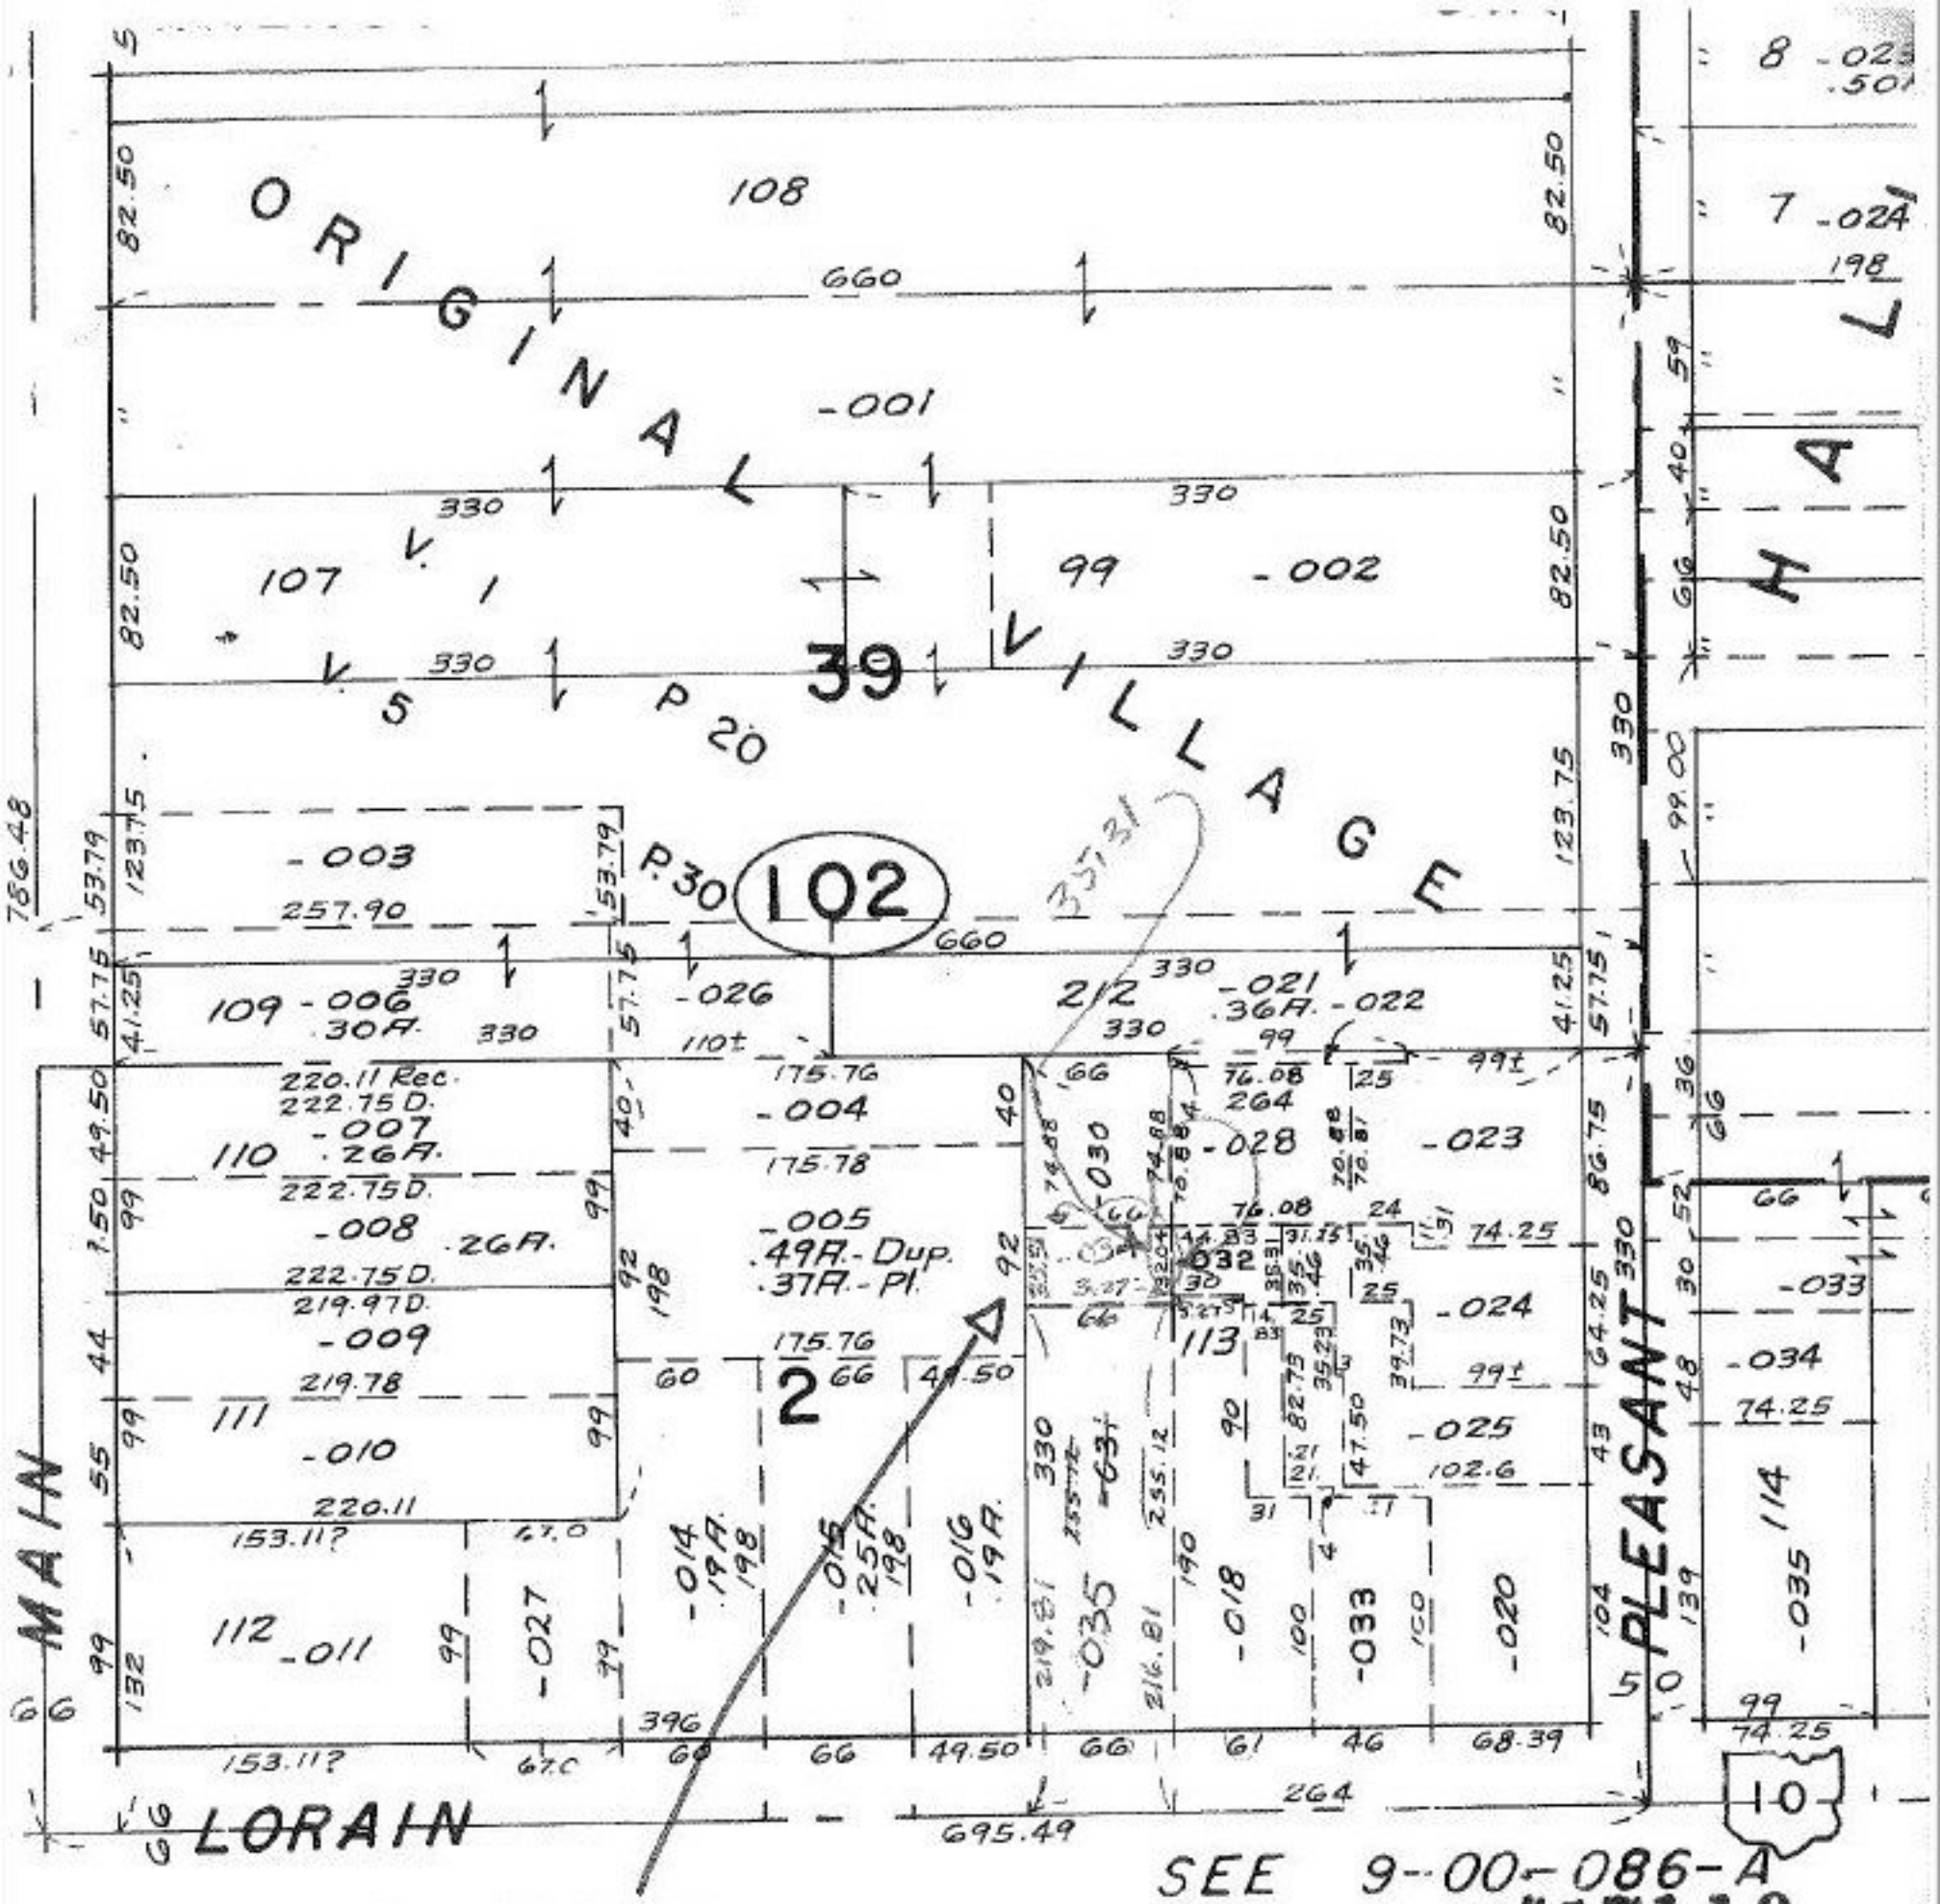

#17110

2-19-87

APPROVED
LORAIN CO.
MAP DEPT.
DATE 11·18·86
PAGE 9·00·076 A
BY T. McNair
VOID AFTER

RUSSIA TWP.

SCALE: 1" = 100'