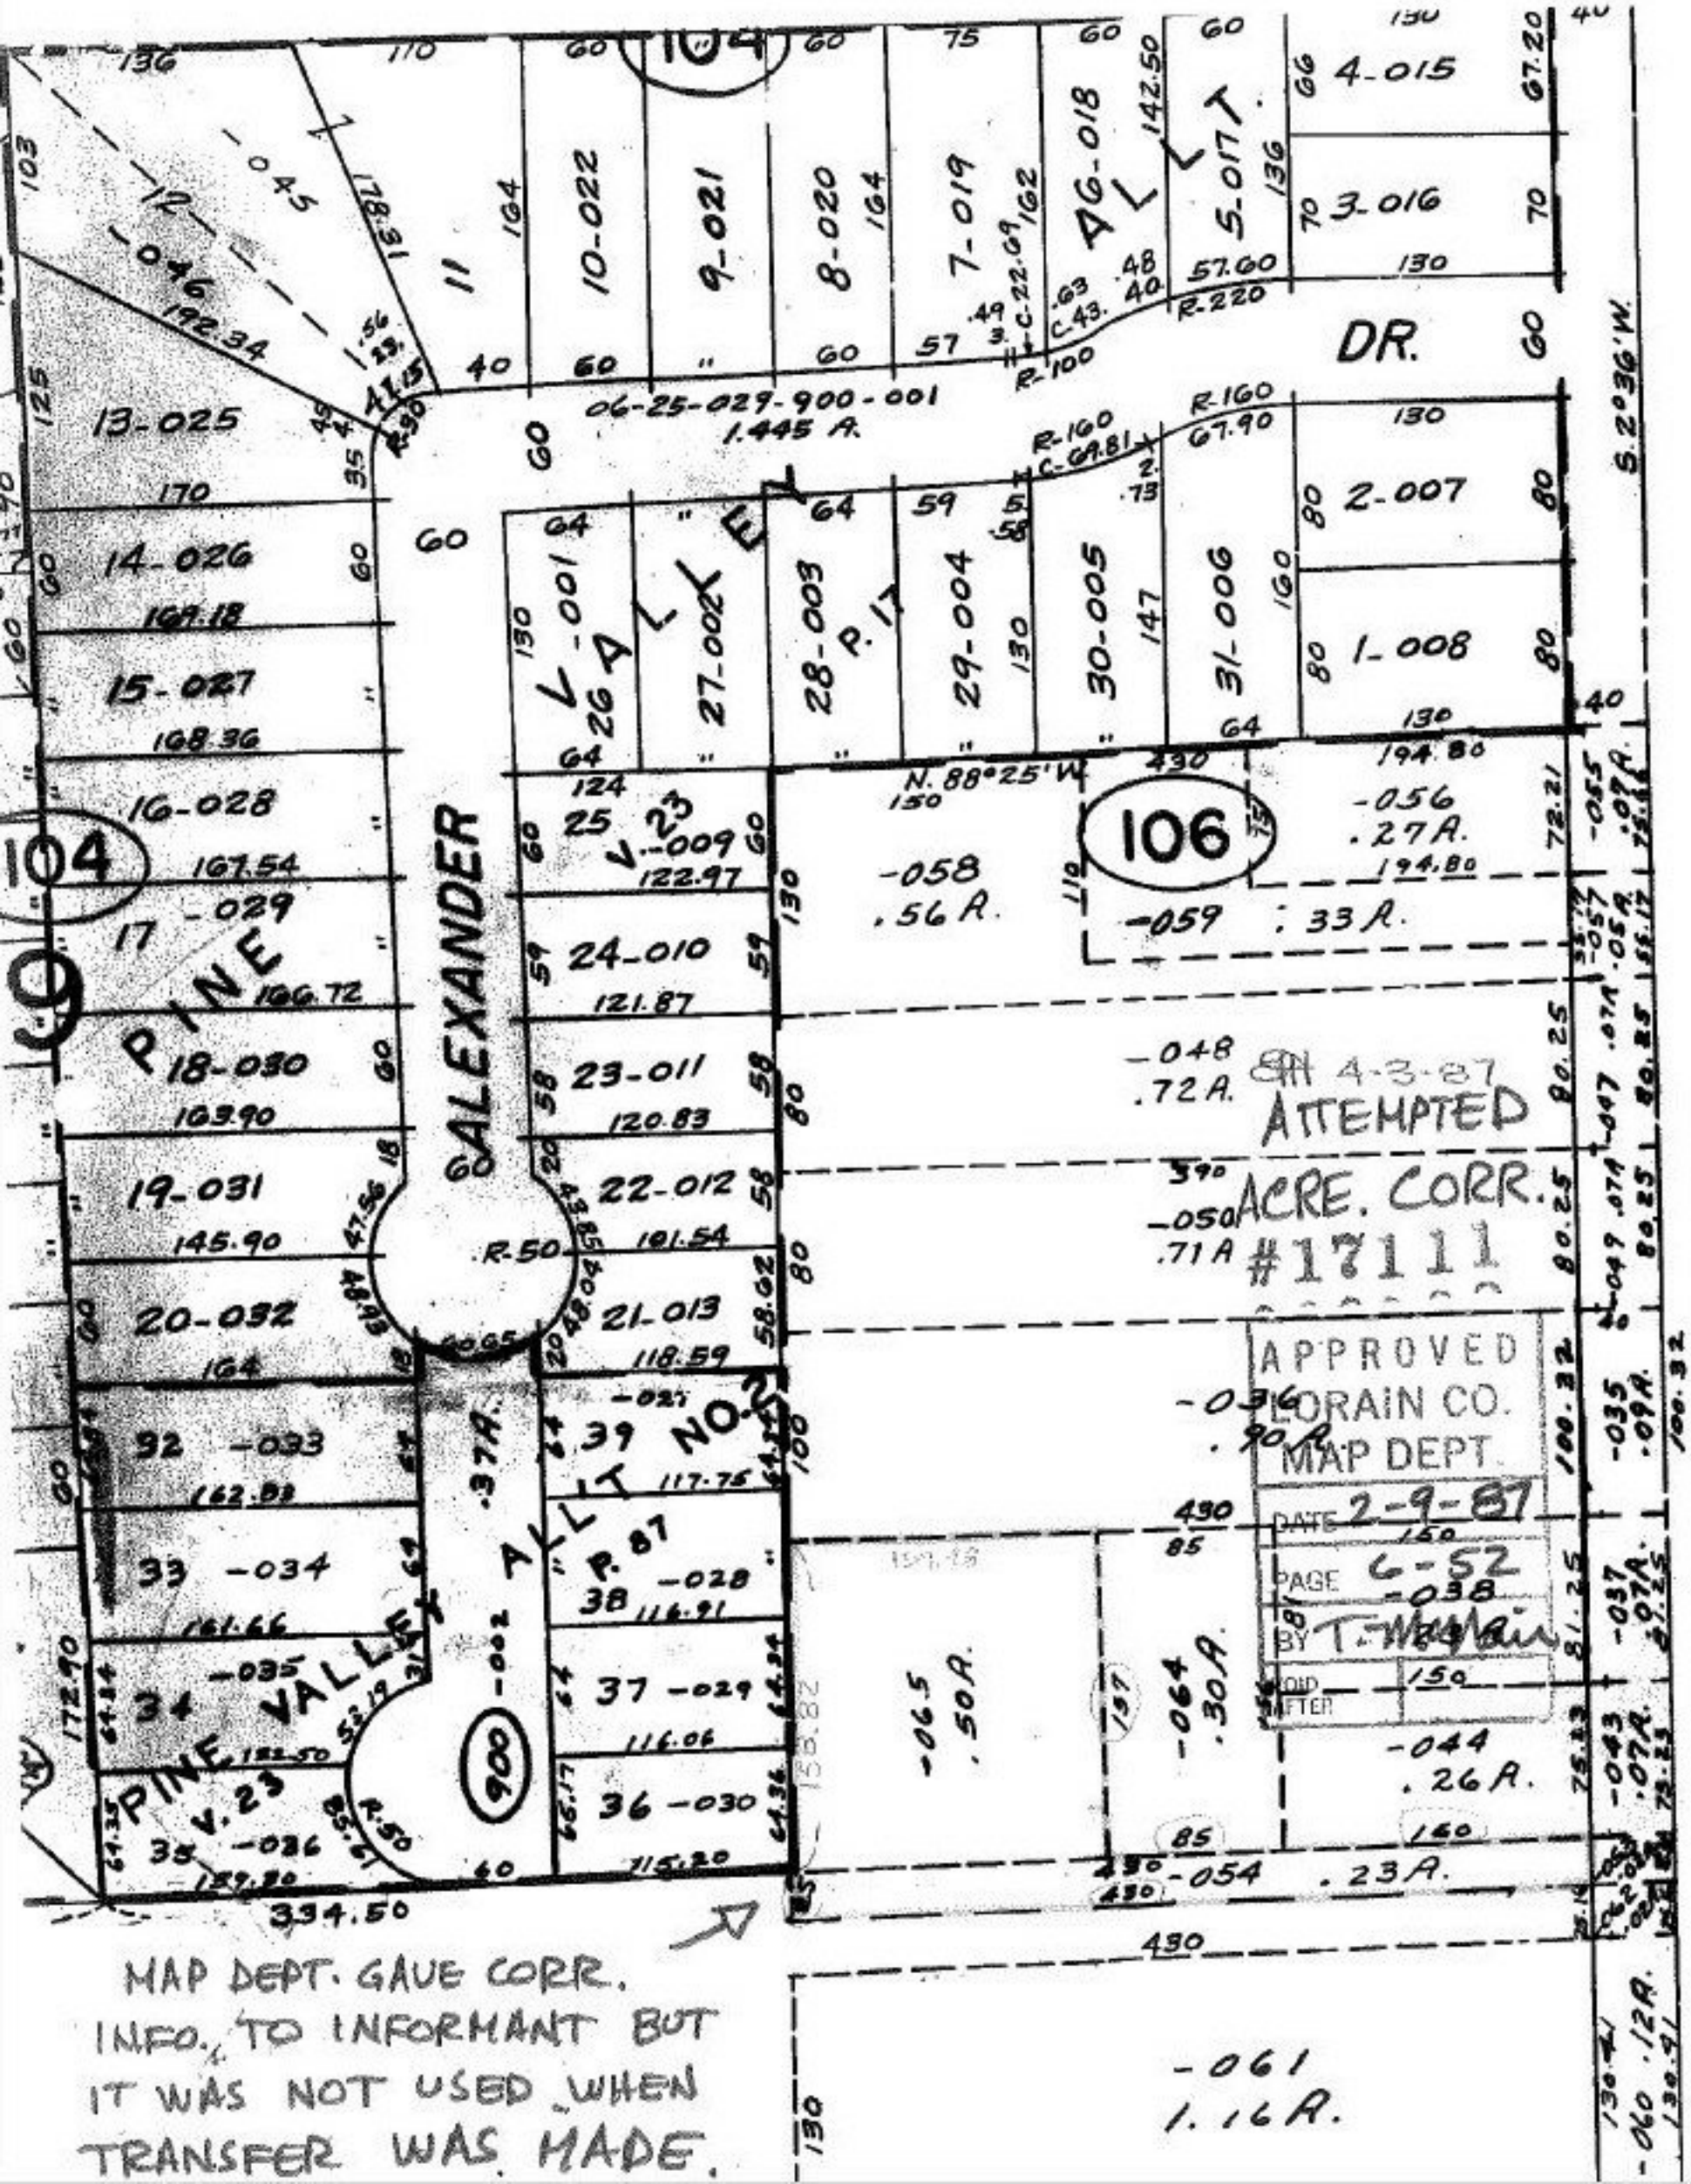

MAP DEPT. GAVE CORR. INFO. TO INFORMANT BUT IT WAS NOT USED WHEN TRANSFER WAS MADE.