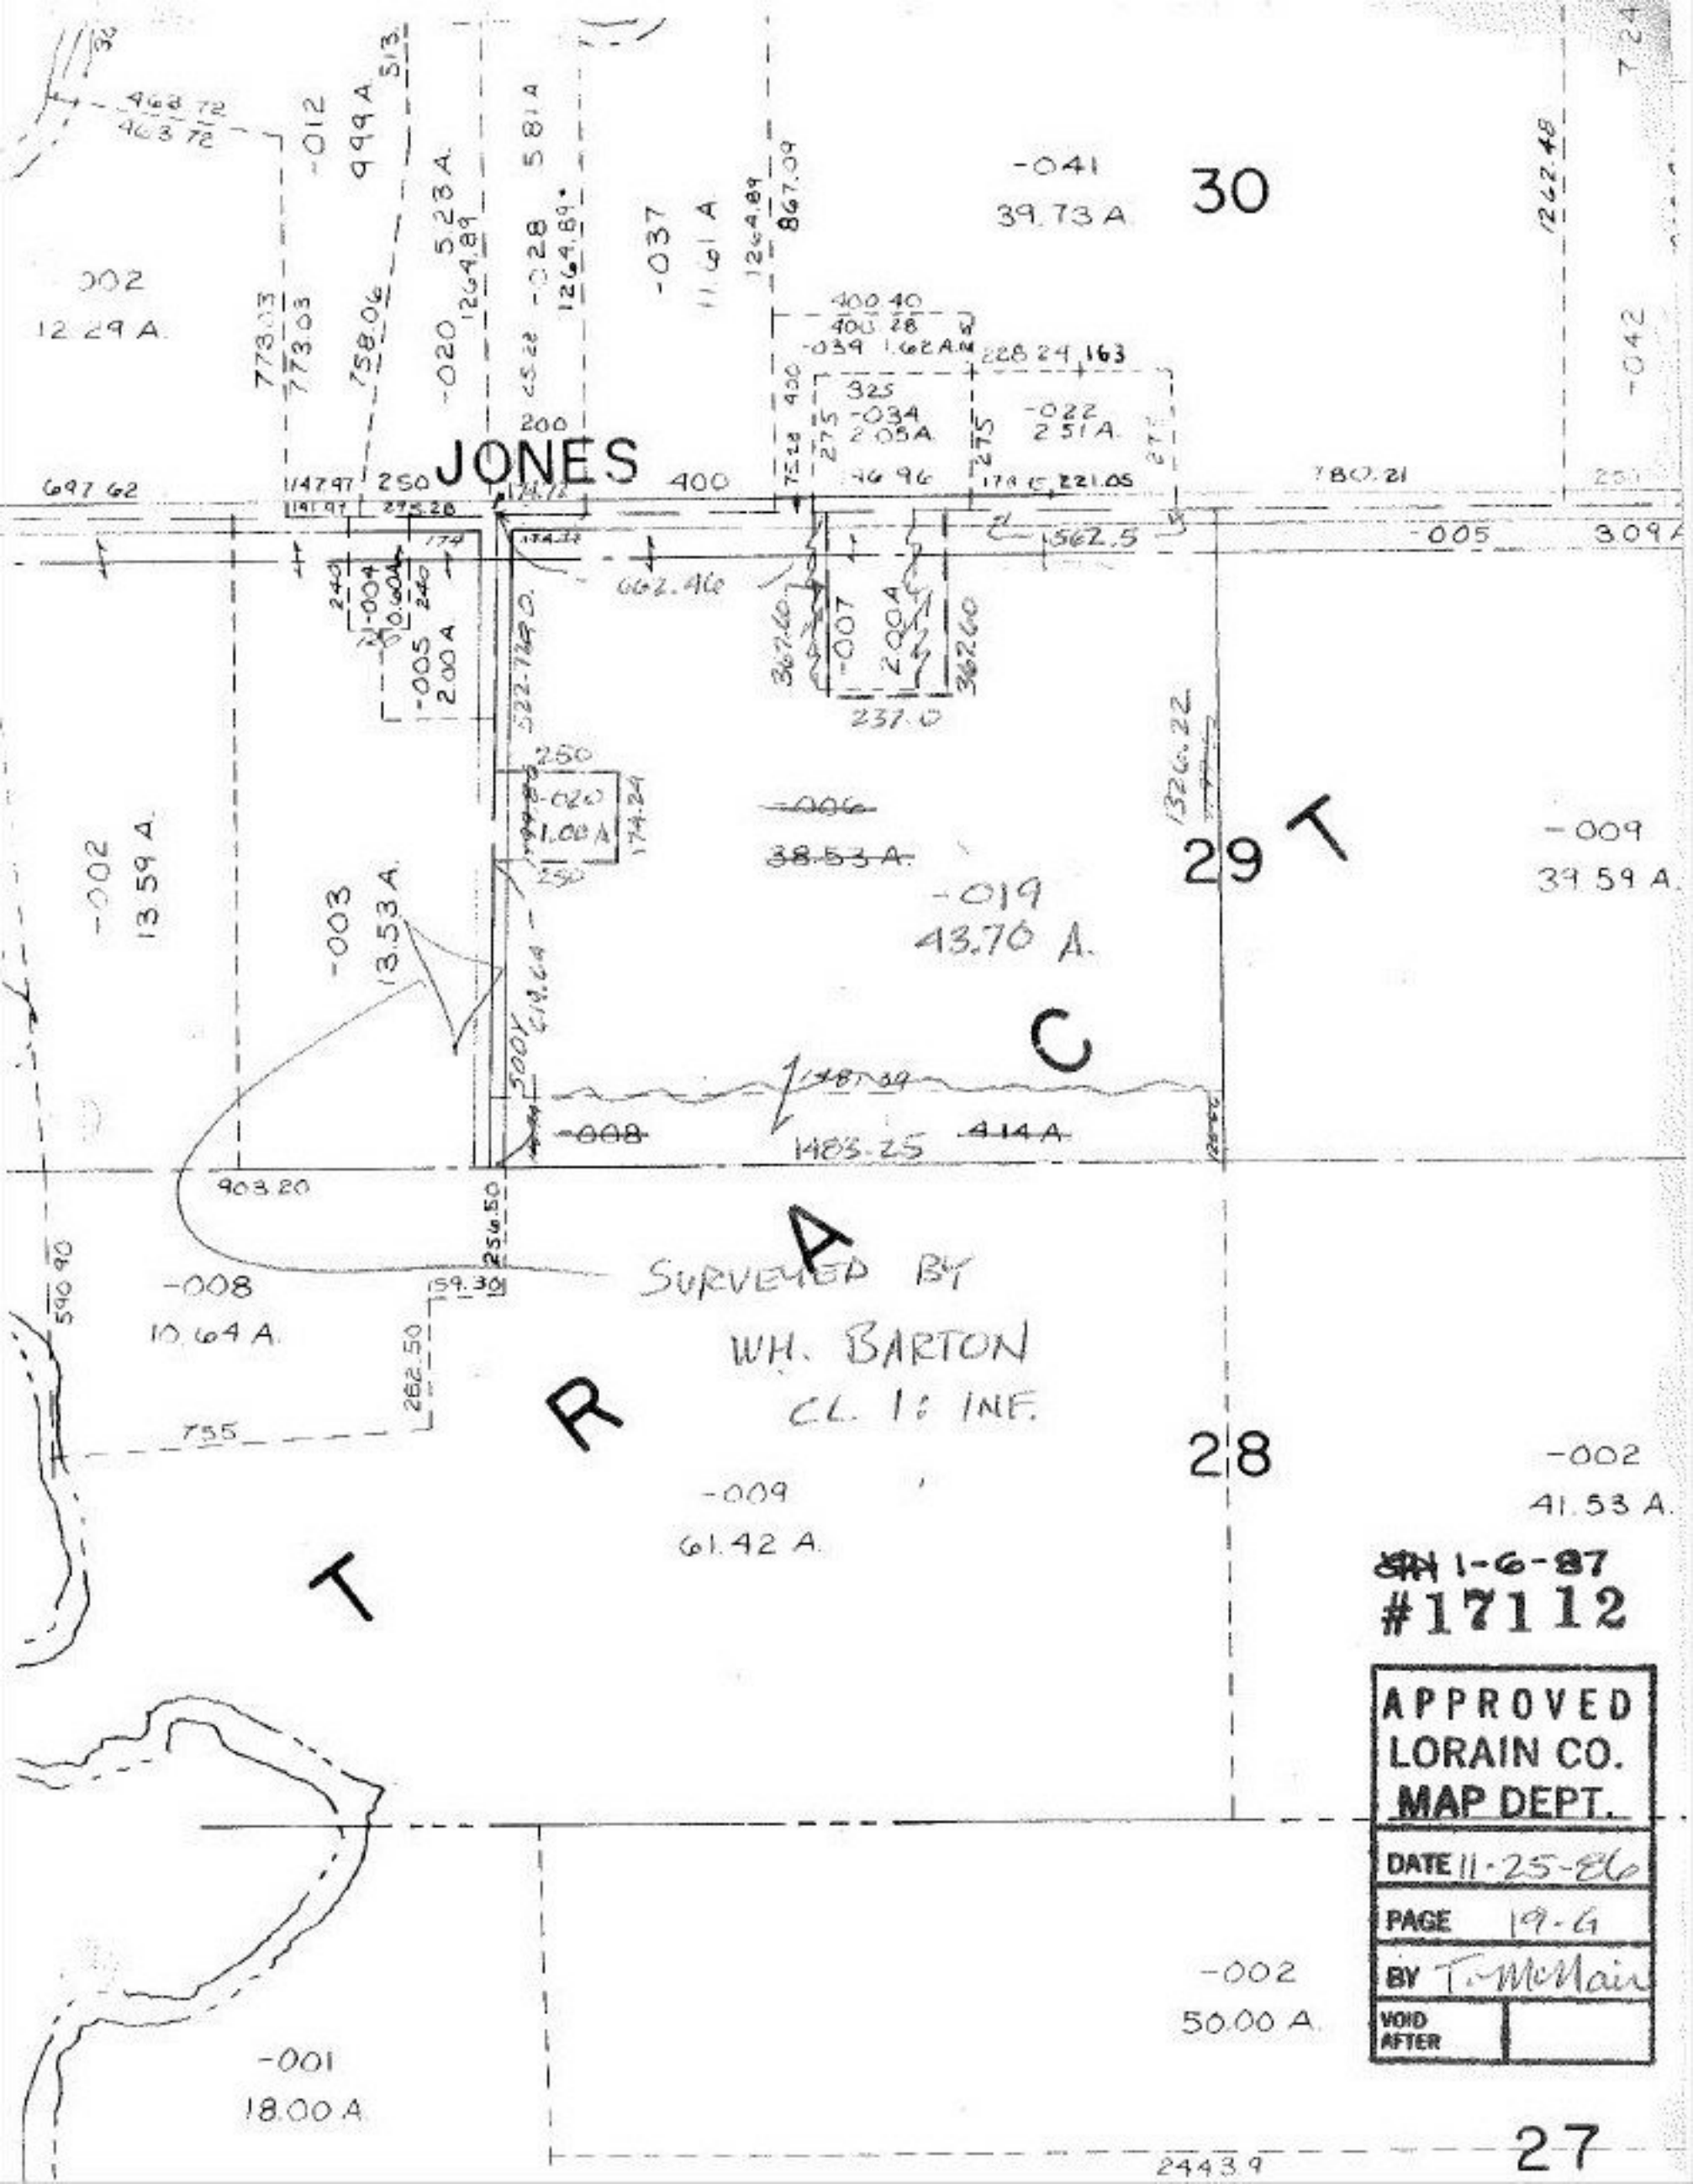

1-6-87
#17112

APPROVED
LORAIN CO.
MAP DEPT.

DATE 11-25-86
PAGE 19-G
BY T. McNair
VOID AFTER