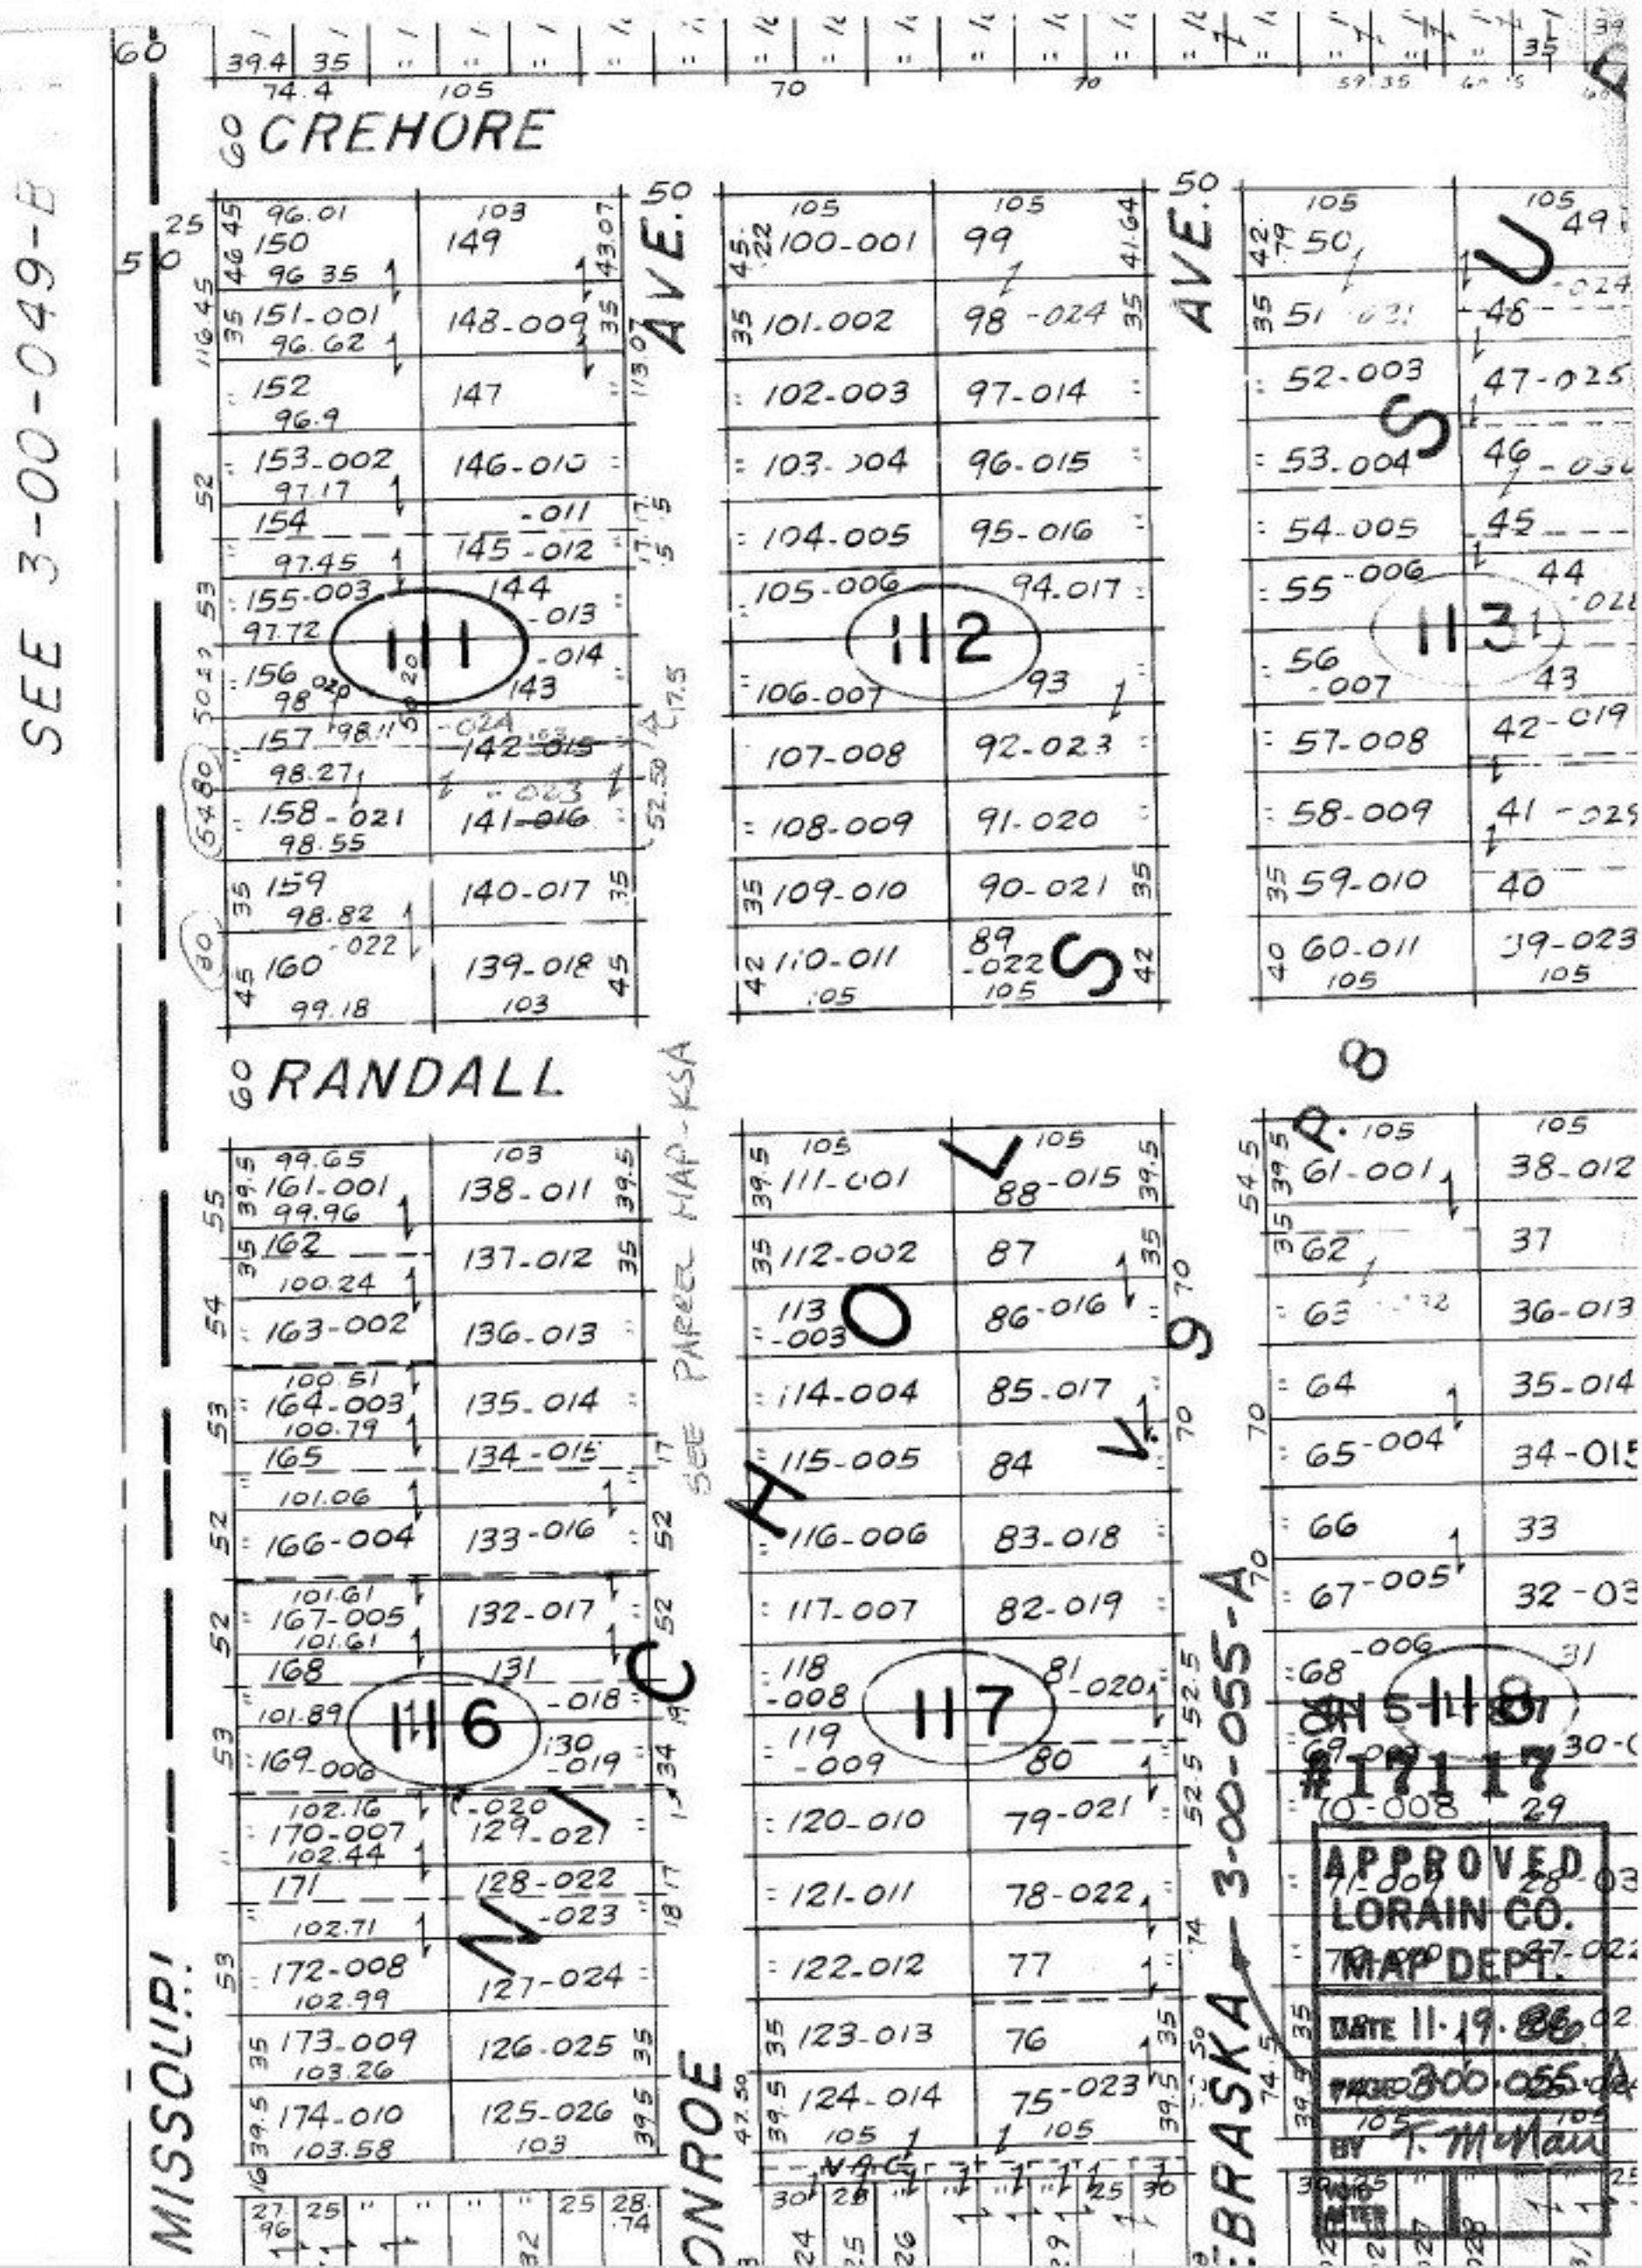

CREHORE
RANDALL
MISSOURI
ONROE
AVE.
AVE.
SEE 3-00-049-B
SEE PARREL MAP-KSA
111
112
113
116
117
118
#17117
APPROVED
LORAIN CO.
MAP DEPT.
DATE 11-19-86
PAGE 3-00-055-A
BY T. McNair