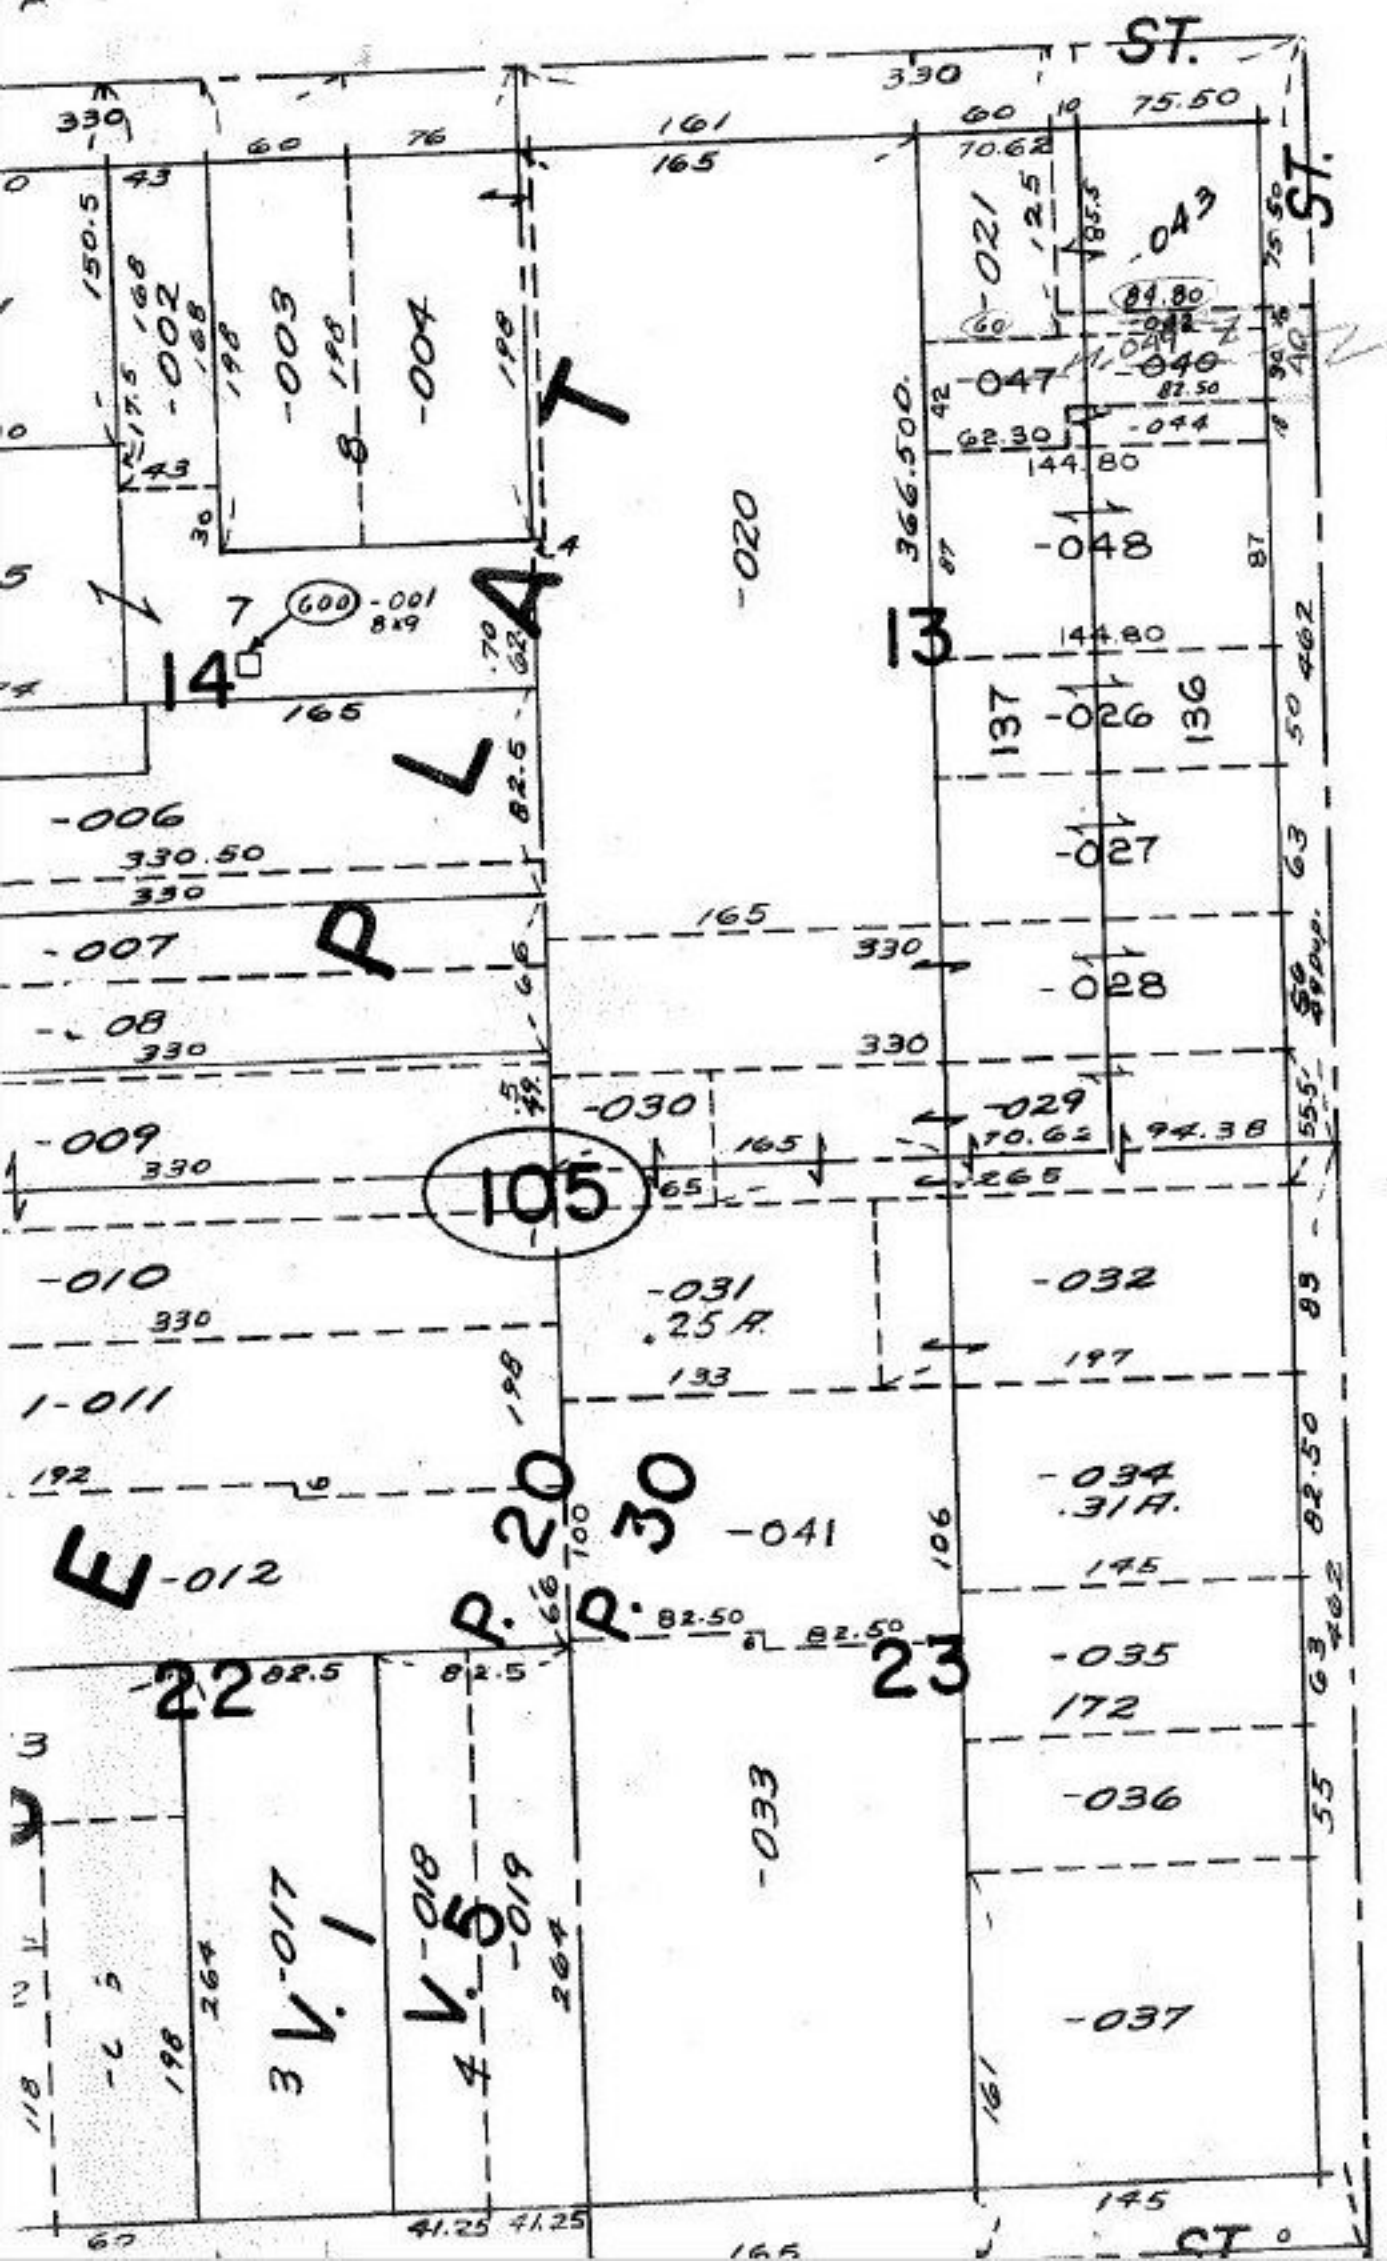

17119
-049
40 x 144.8

11-26-86
COMBINATION
#17119

APPROVED
LORAIN CO.
MAP DEPT.
DATE 11-24-86
PAGE 9-00-086-A
BY T. McNair
VOID AFTER