DONE 7/8/68 W. Kochis

6-1-87 CB

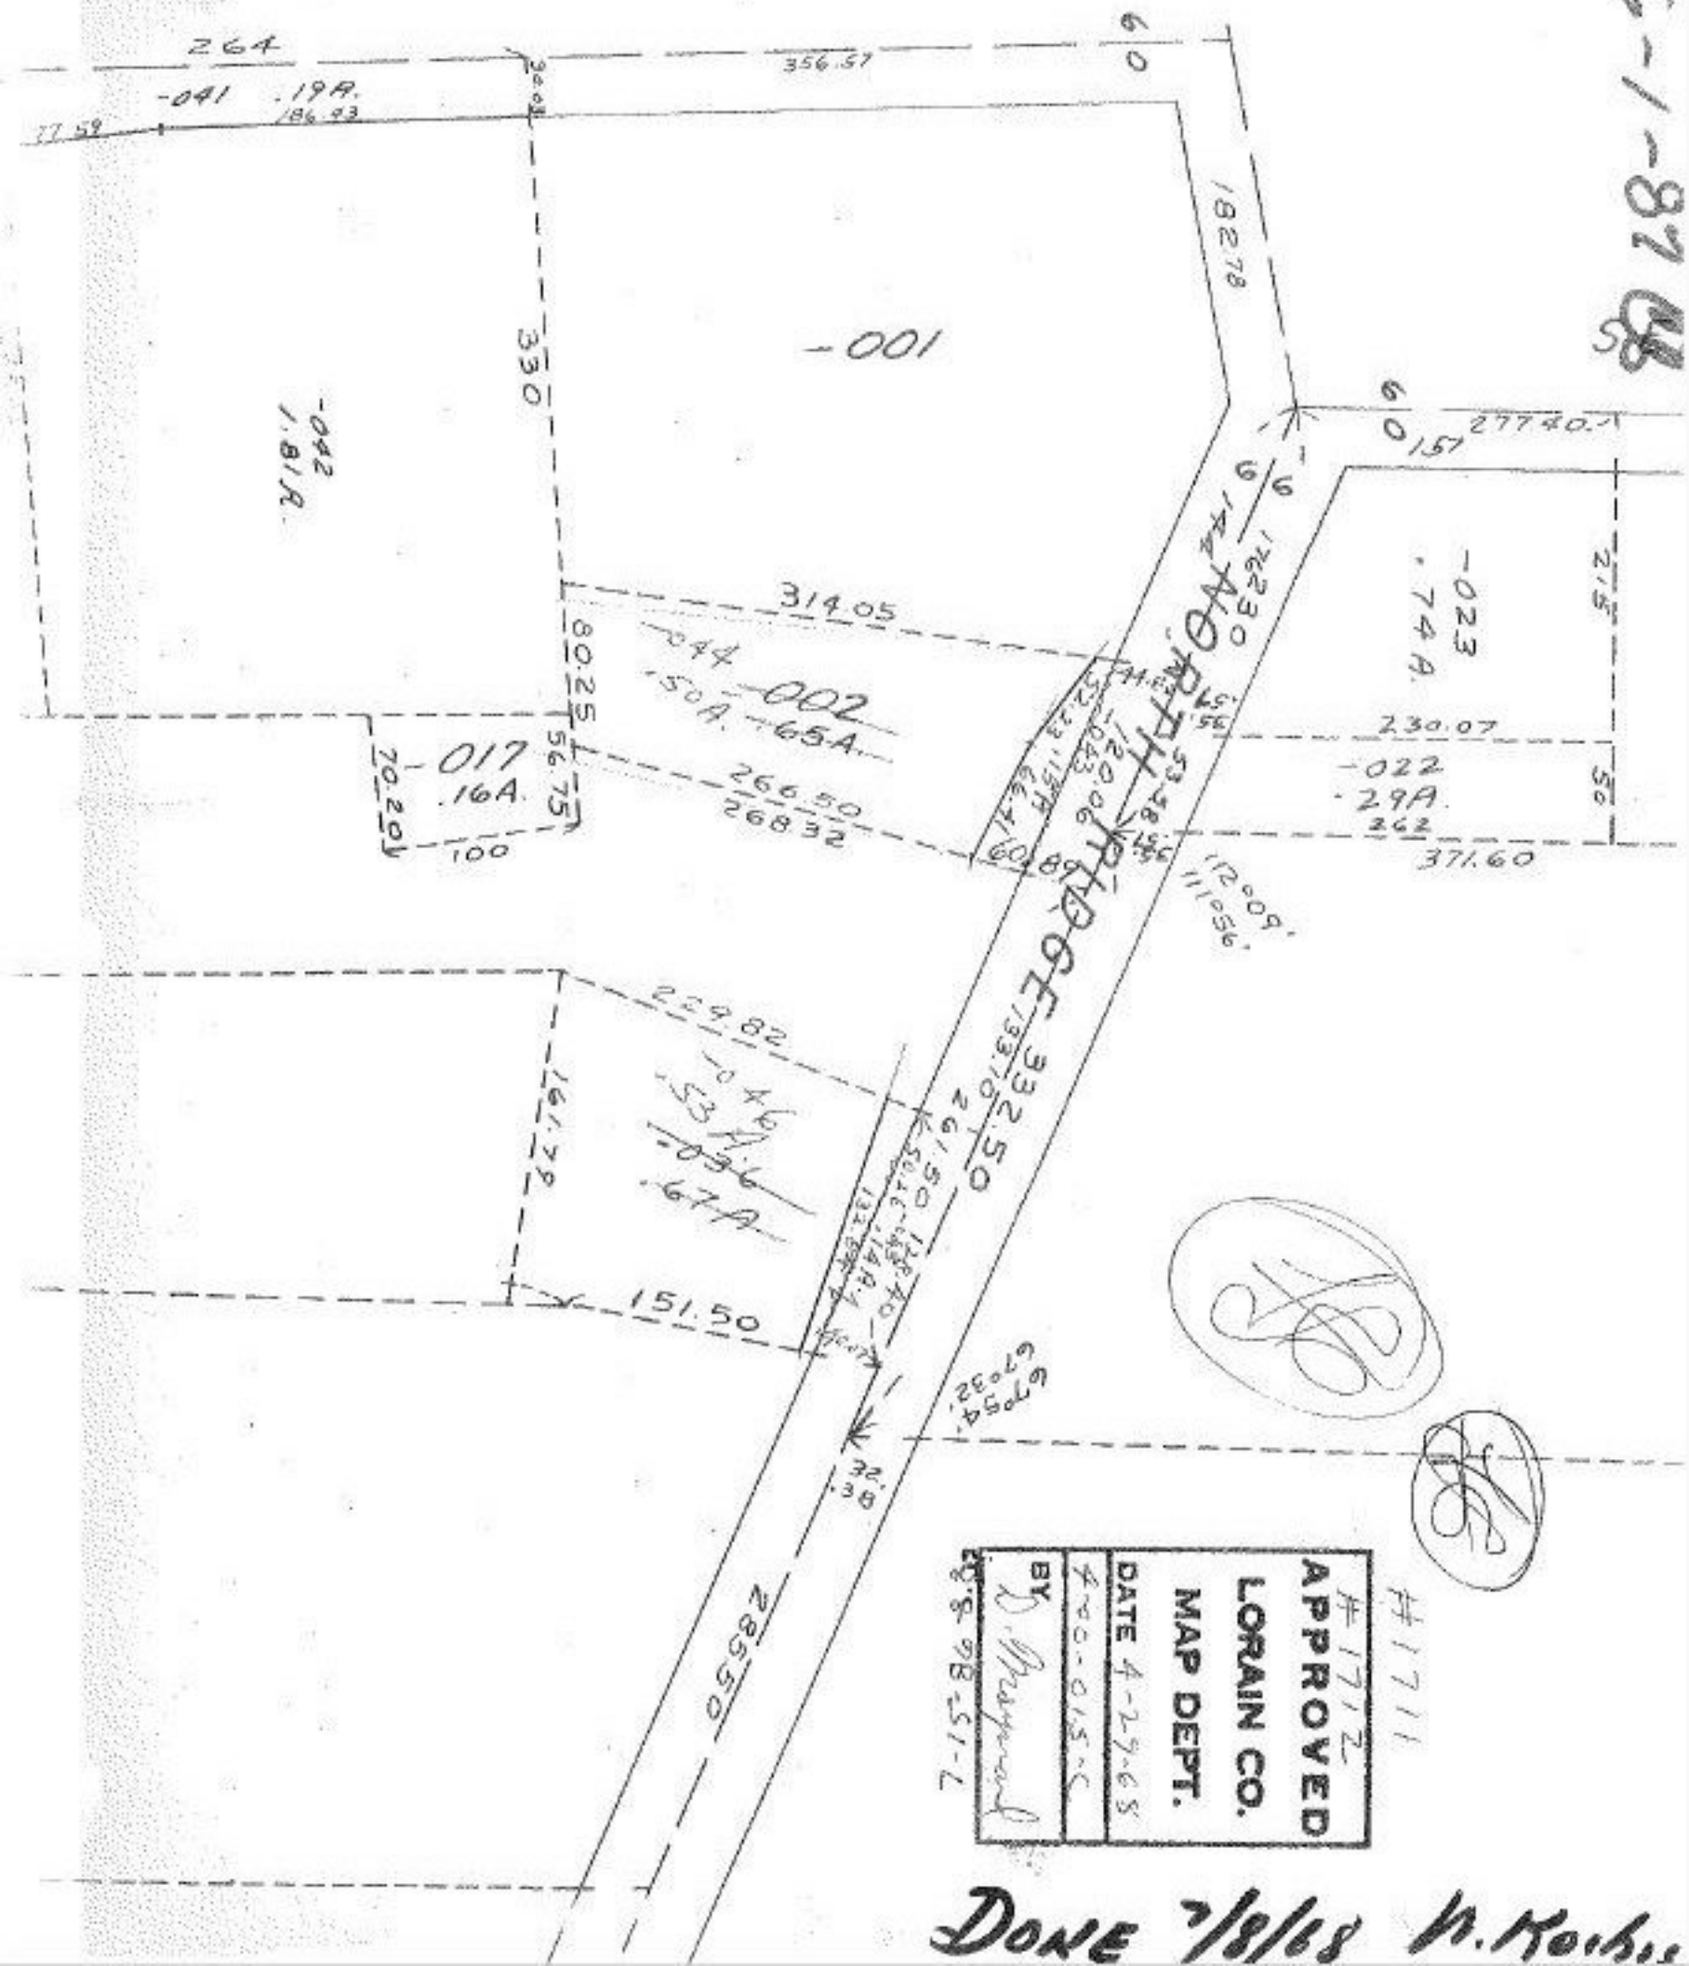


DONE 7/8/68 W. Kochis