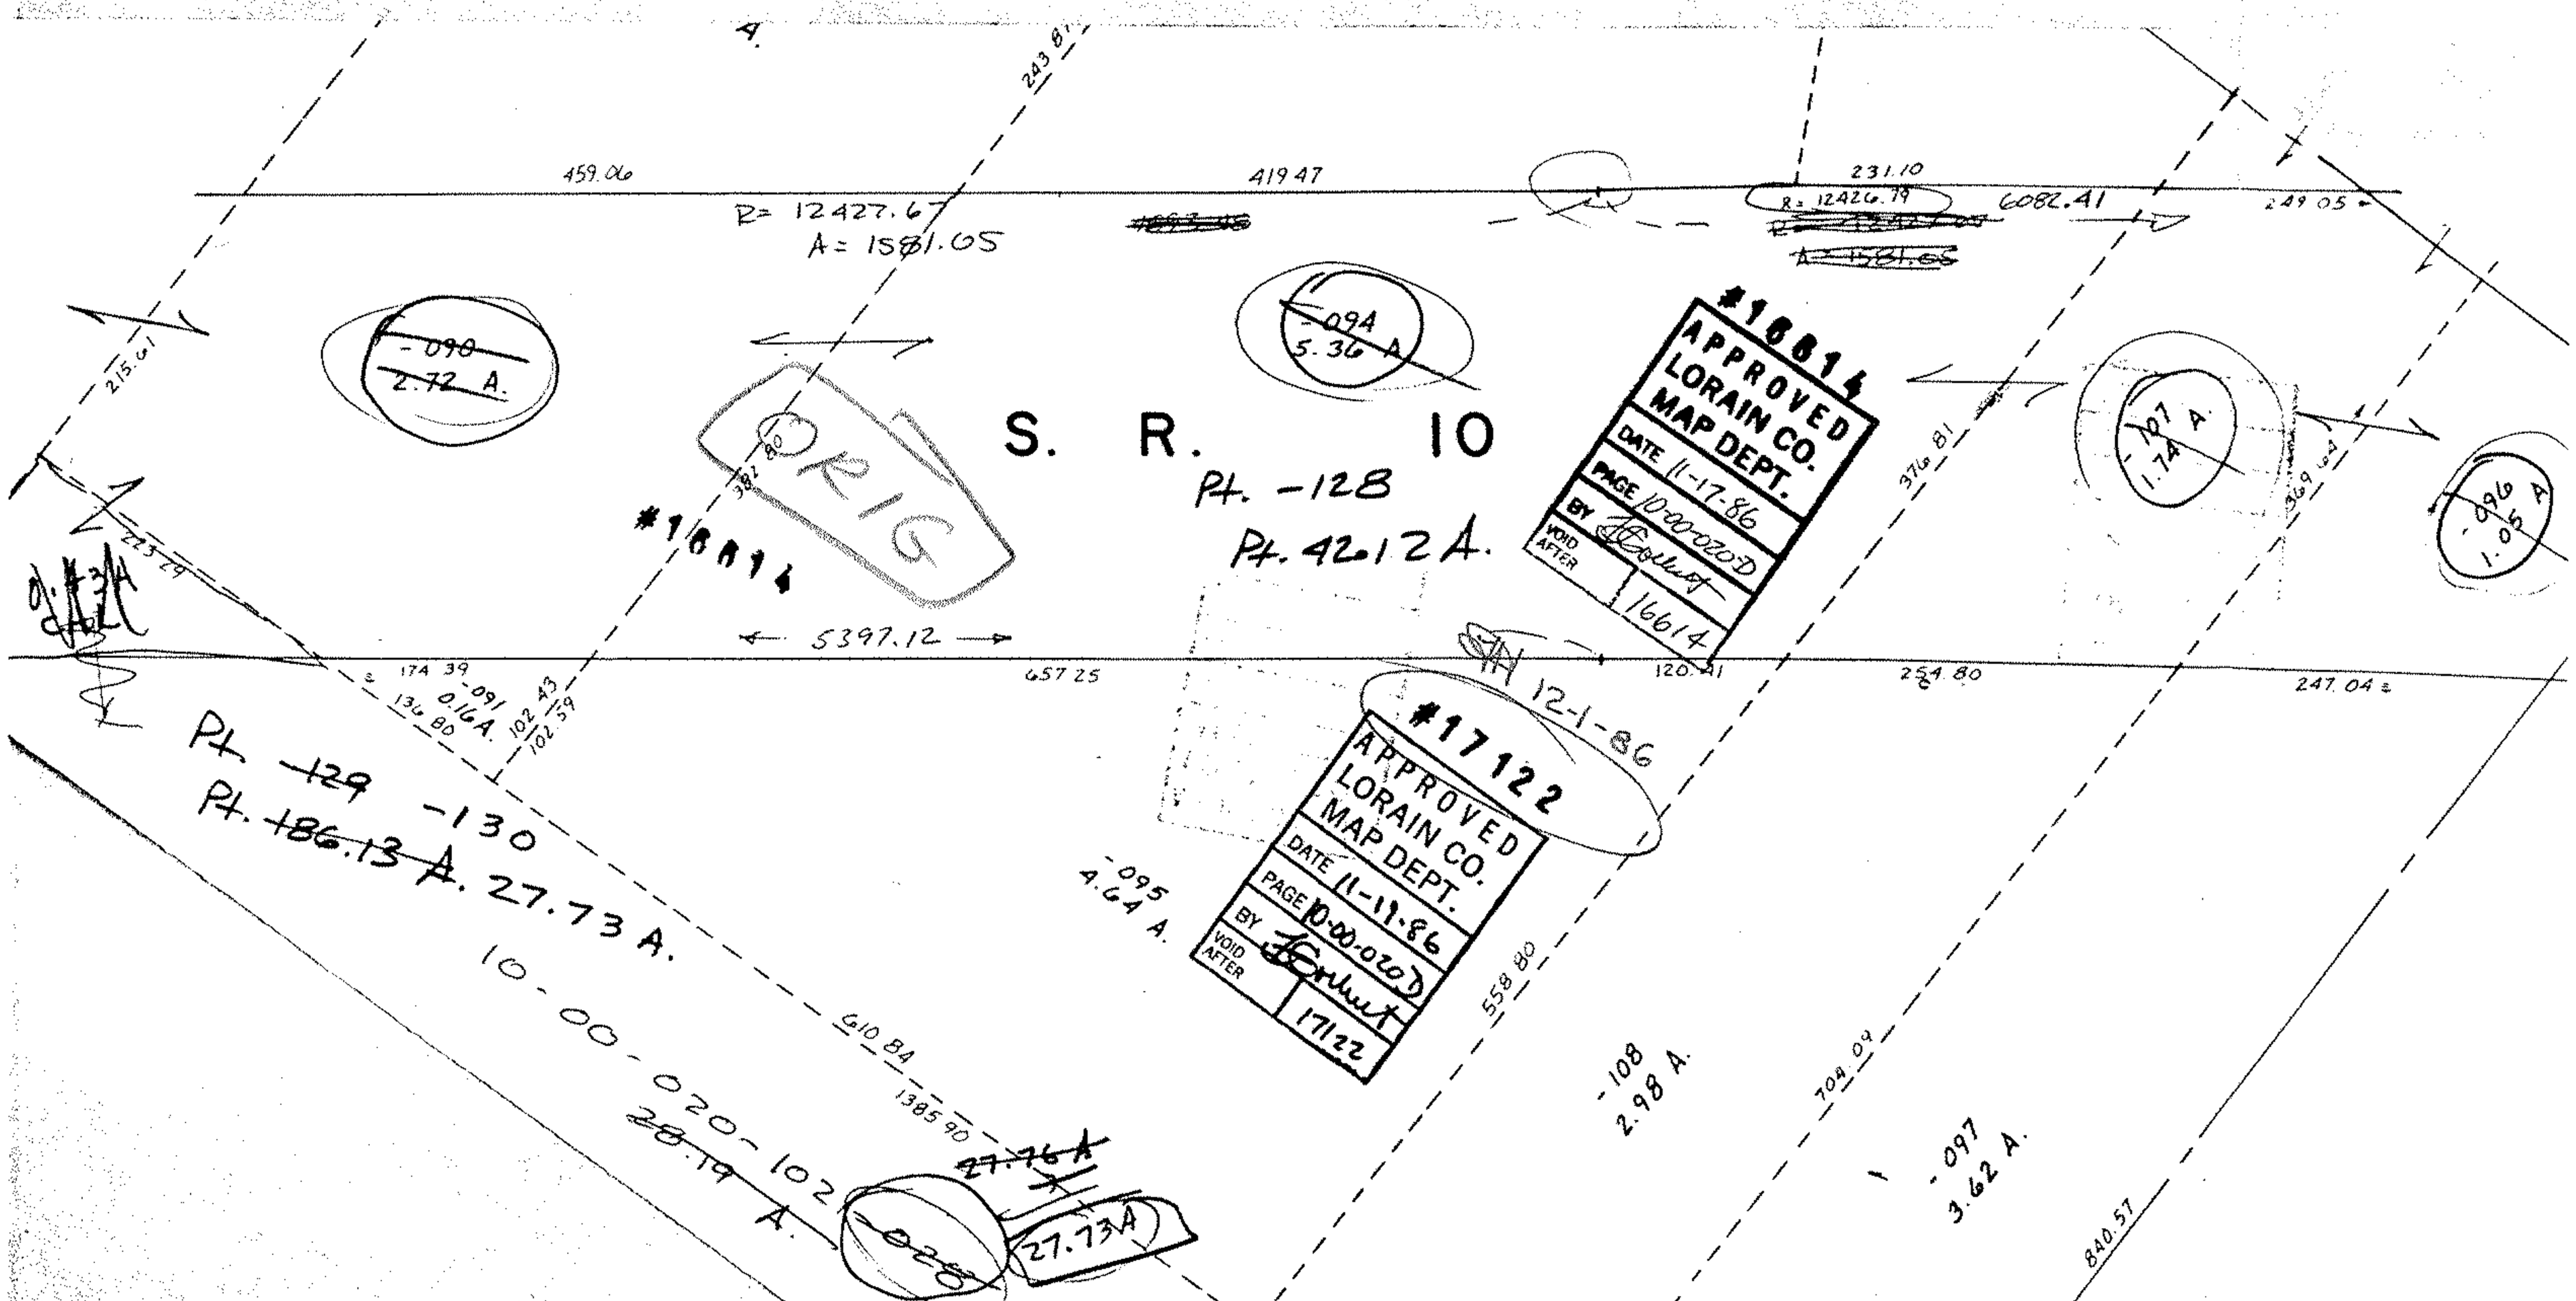

S. R. 10
Pt. -128
Pt. 42.12 A.
R= 12427.67
A= 1581.05
R= 12426.79
459.06
419.47
231.10
6082.41
249.05
243.81
215.61
223.29
382.80
5397.12
657.25
120.41
254.80
247.04
376.81
369.64
174.39
136.80
102.43
102.59
610.84
1385.90
558.80
704.09
840.57
-090
2.72 A.
-094
5.36 A.
-107
1.74 A.
-096
1.05 A.
-095
4.64 A.
-108
2.98 A.
-097
3.62 A.
-091
0.16 A.
-028
27.76 A
27.73 A
ORIG
#16614
APPROVED
LORAIN CO.
MAP DEPT.
DATE 11-17-86
PAGE 10-00-020-D
BY
VOID AFTER
16614
#17122
APPROVED
LORAIN CO.
MAP DEPT.
DATE 11-19-86
PAGE 10-00-020-D
BY
VOID AFTER
17122
12-1-86
Pt. -129 -130
Pt. 186.13 A. 27.73 A.
10-00-020-102
28.19 A.