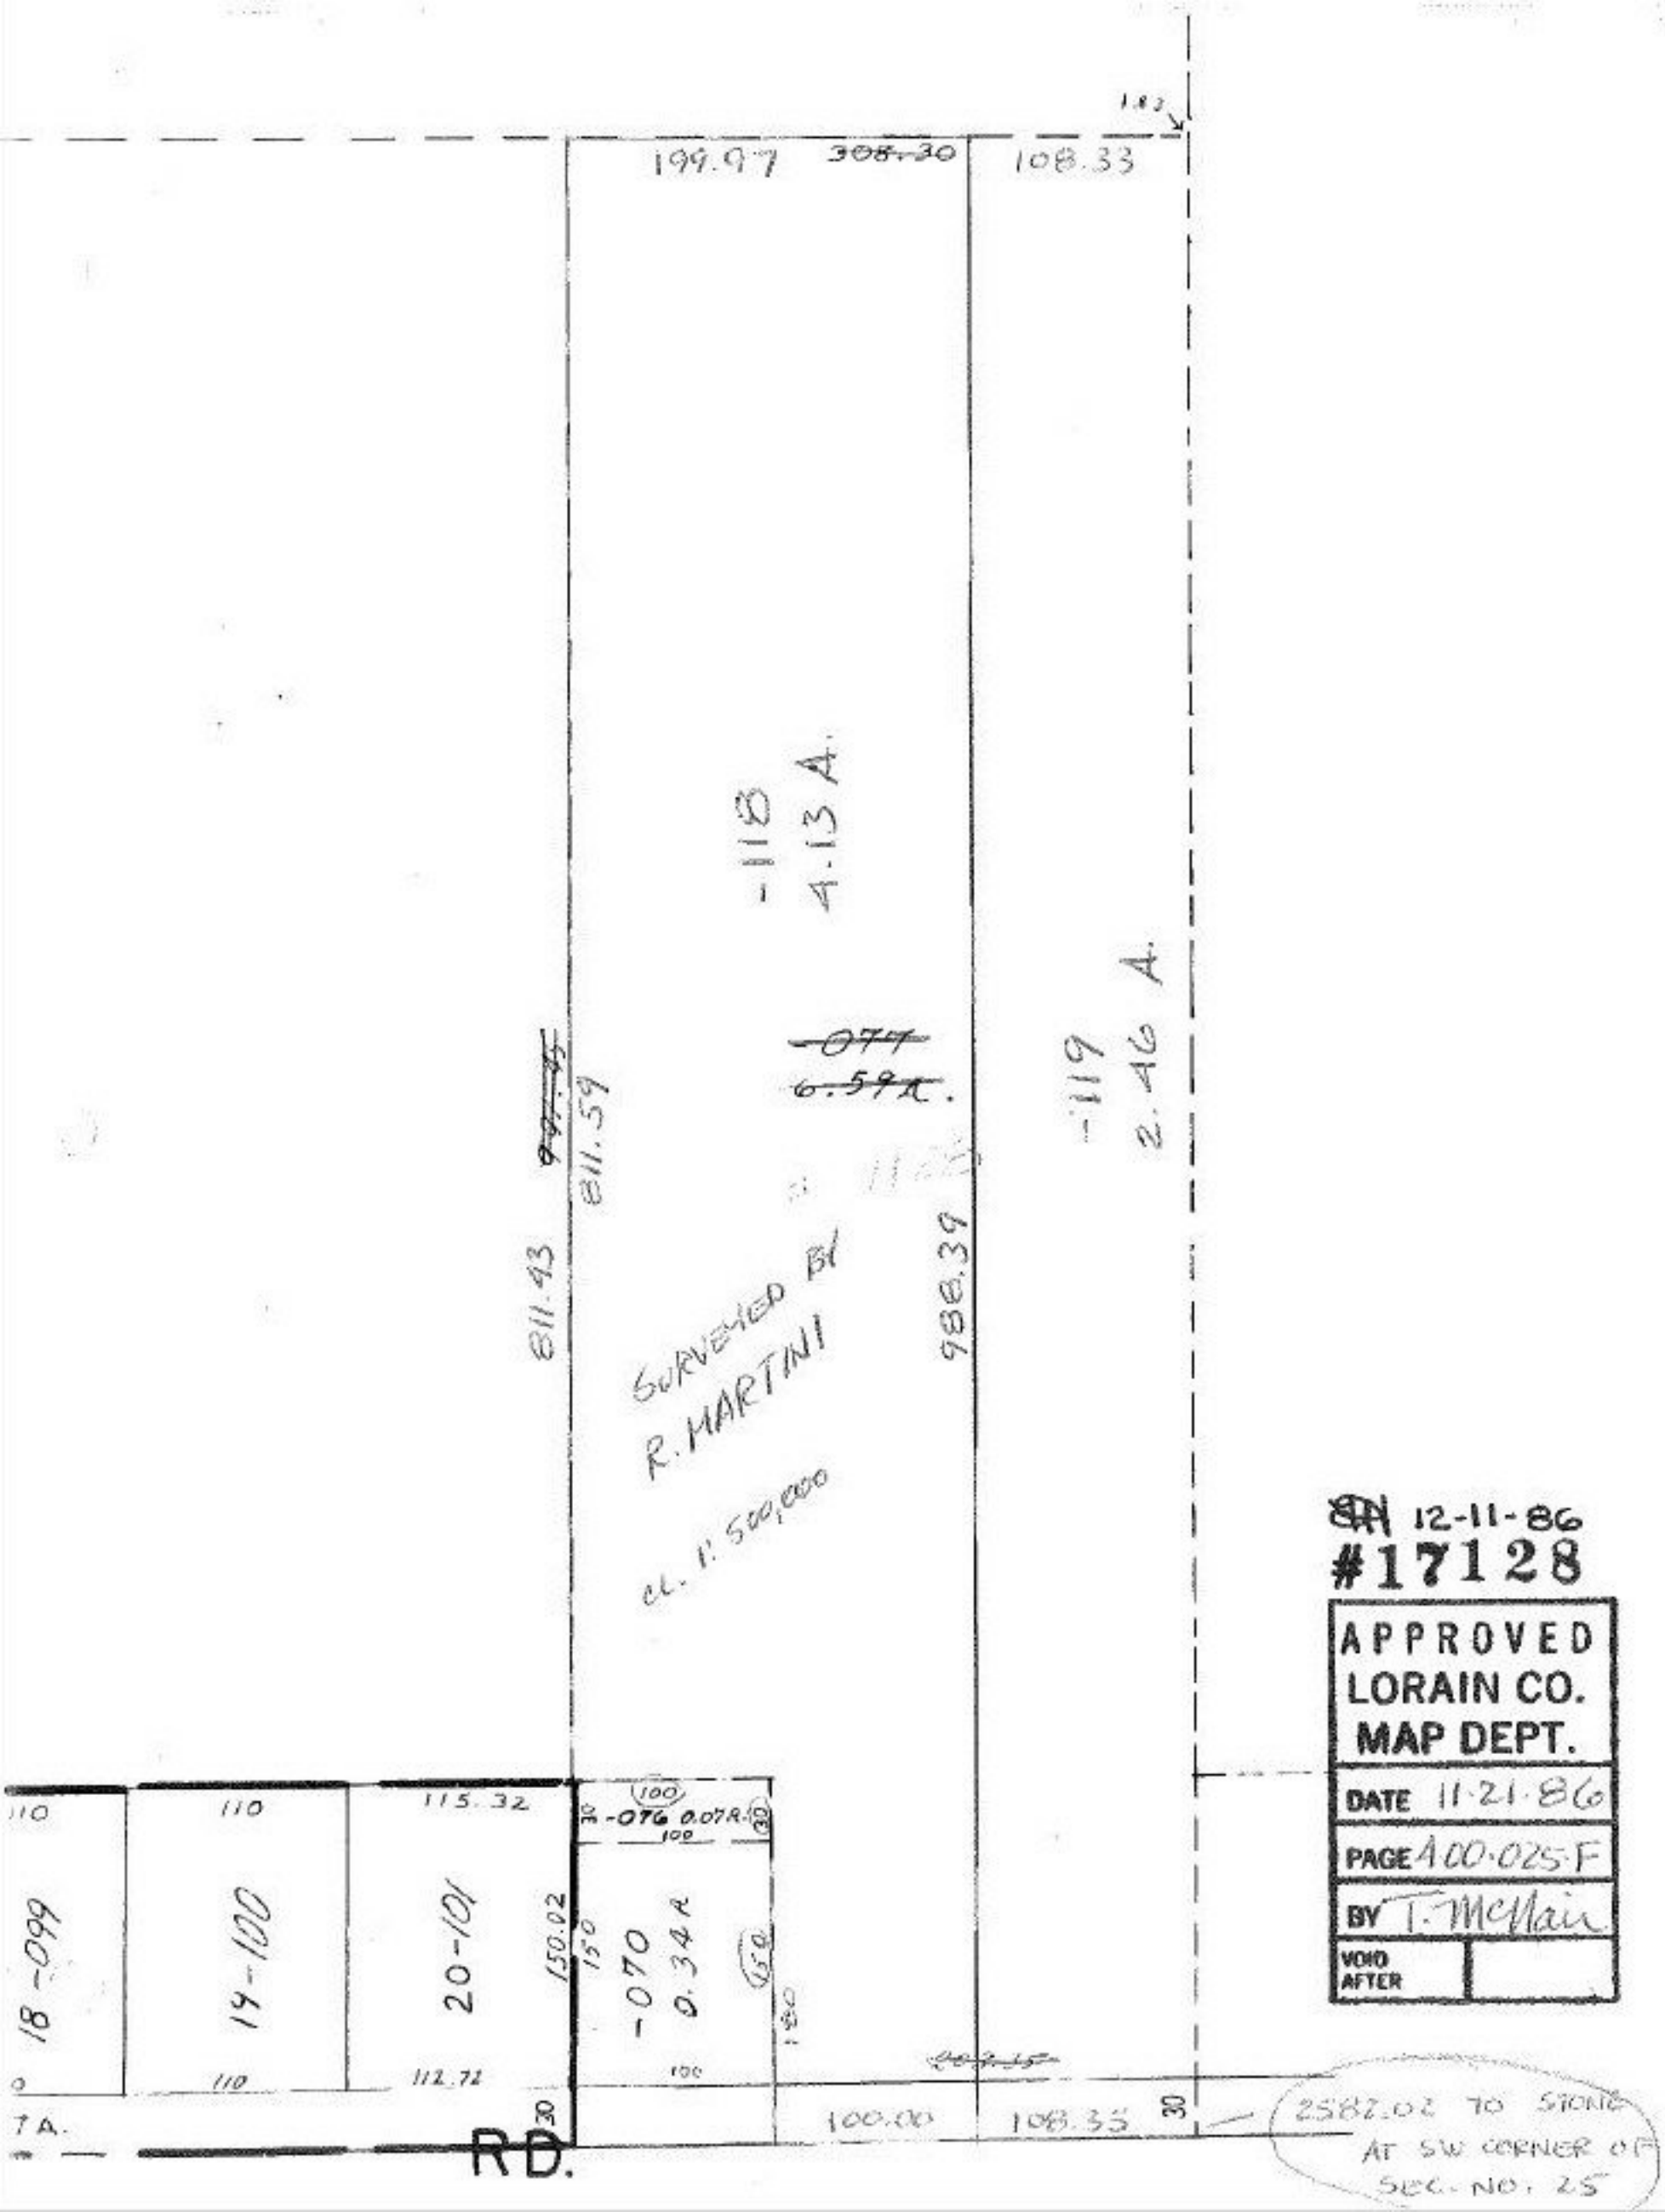

1.83
199.97
~~308.30~~
108.33
-118
4.13 A.
~~-077~~
~~6.59 A.~~
-119
2.46 A.
811.59
811.43
988.39
SURVEYED BY
R. MARTINI
CL. 1:500,000
12-11-86
#17128
APPROVED
LORAIN CO.
MAP DEPT.
DATE 11-21-86
PAGE 400-025-F
BY T. McNair
VOID AFTER
110
110
115.32
-076 0.07 A.
100
30
18-099
19-100
20-101
150.02
150
-070
0.34 A
150
180
110
112.72
100
7 A.
RD.
100.00
108.35
30
2582.02 TO STONE
AT SW CORNER OF
SEC. NO. 25