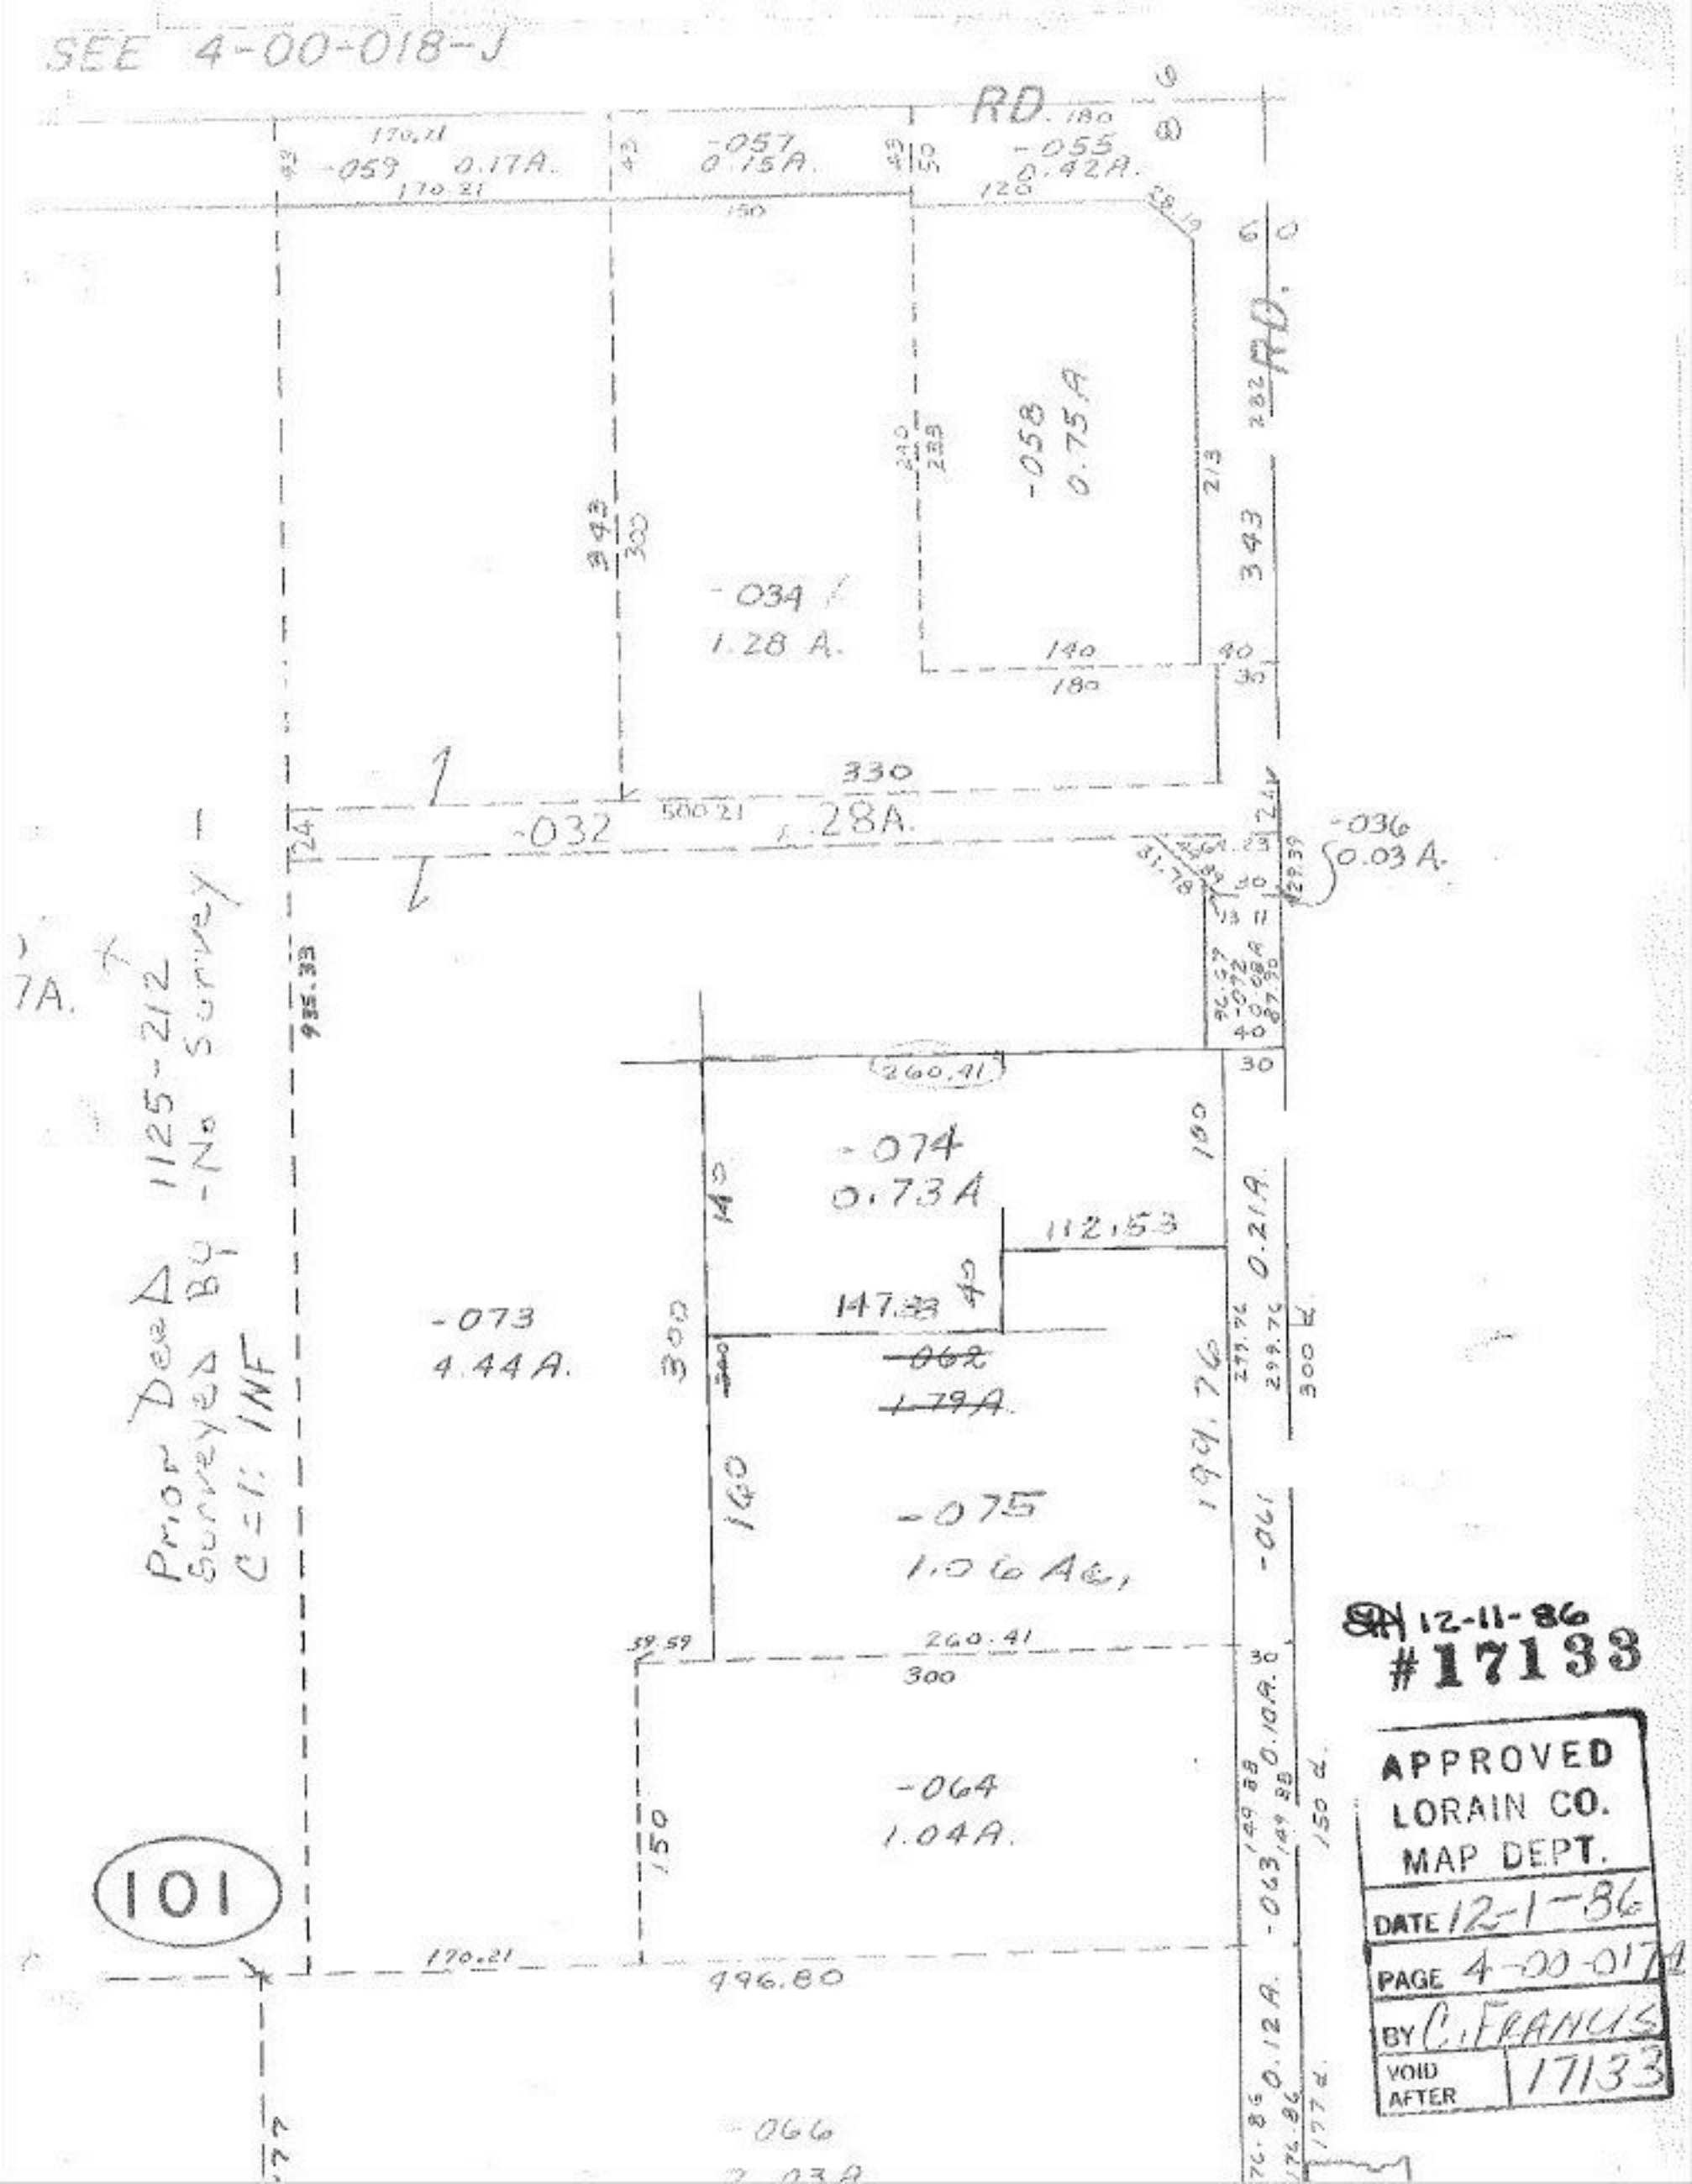
SEE 4-00-018-J
RD.
-059 0.17A.
-057 0.15A.
-055 0.42A.
-058 0.75A
-034 1.28 A.
-032 1.28A.
-036 0.03 A.
-074 0.73A
-073 4.44A.
-062 1.79A.
-075 1.06 Ac.
-064 1.04A.
-066
Prior Deed 1125-212
Surveyed By -No Survey
C=1: INF
101
12-11-86
#17133
APPROVED
LORAIN CO.
MAP DEPT.
DATE 12-1-86
PAGE 4-00-017
BY C. FRANCIS
VOID AFTER 17133