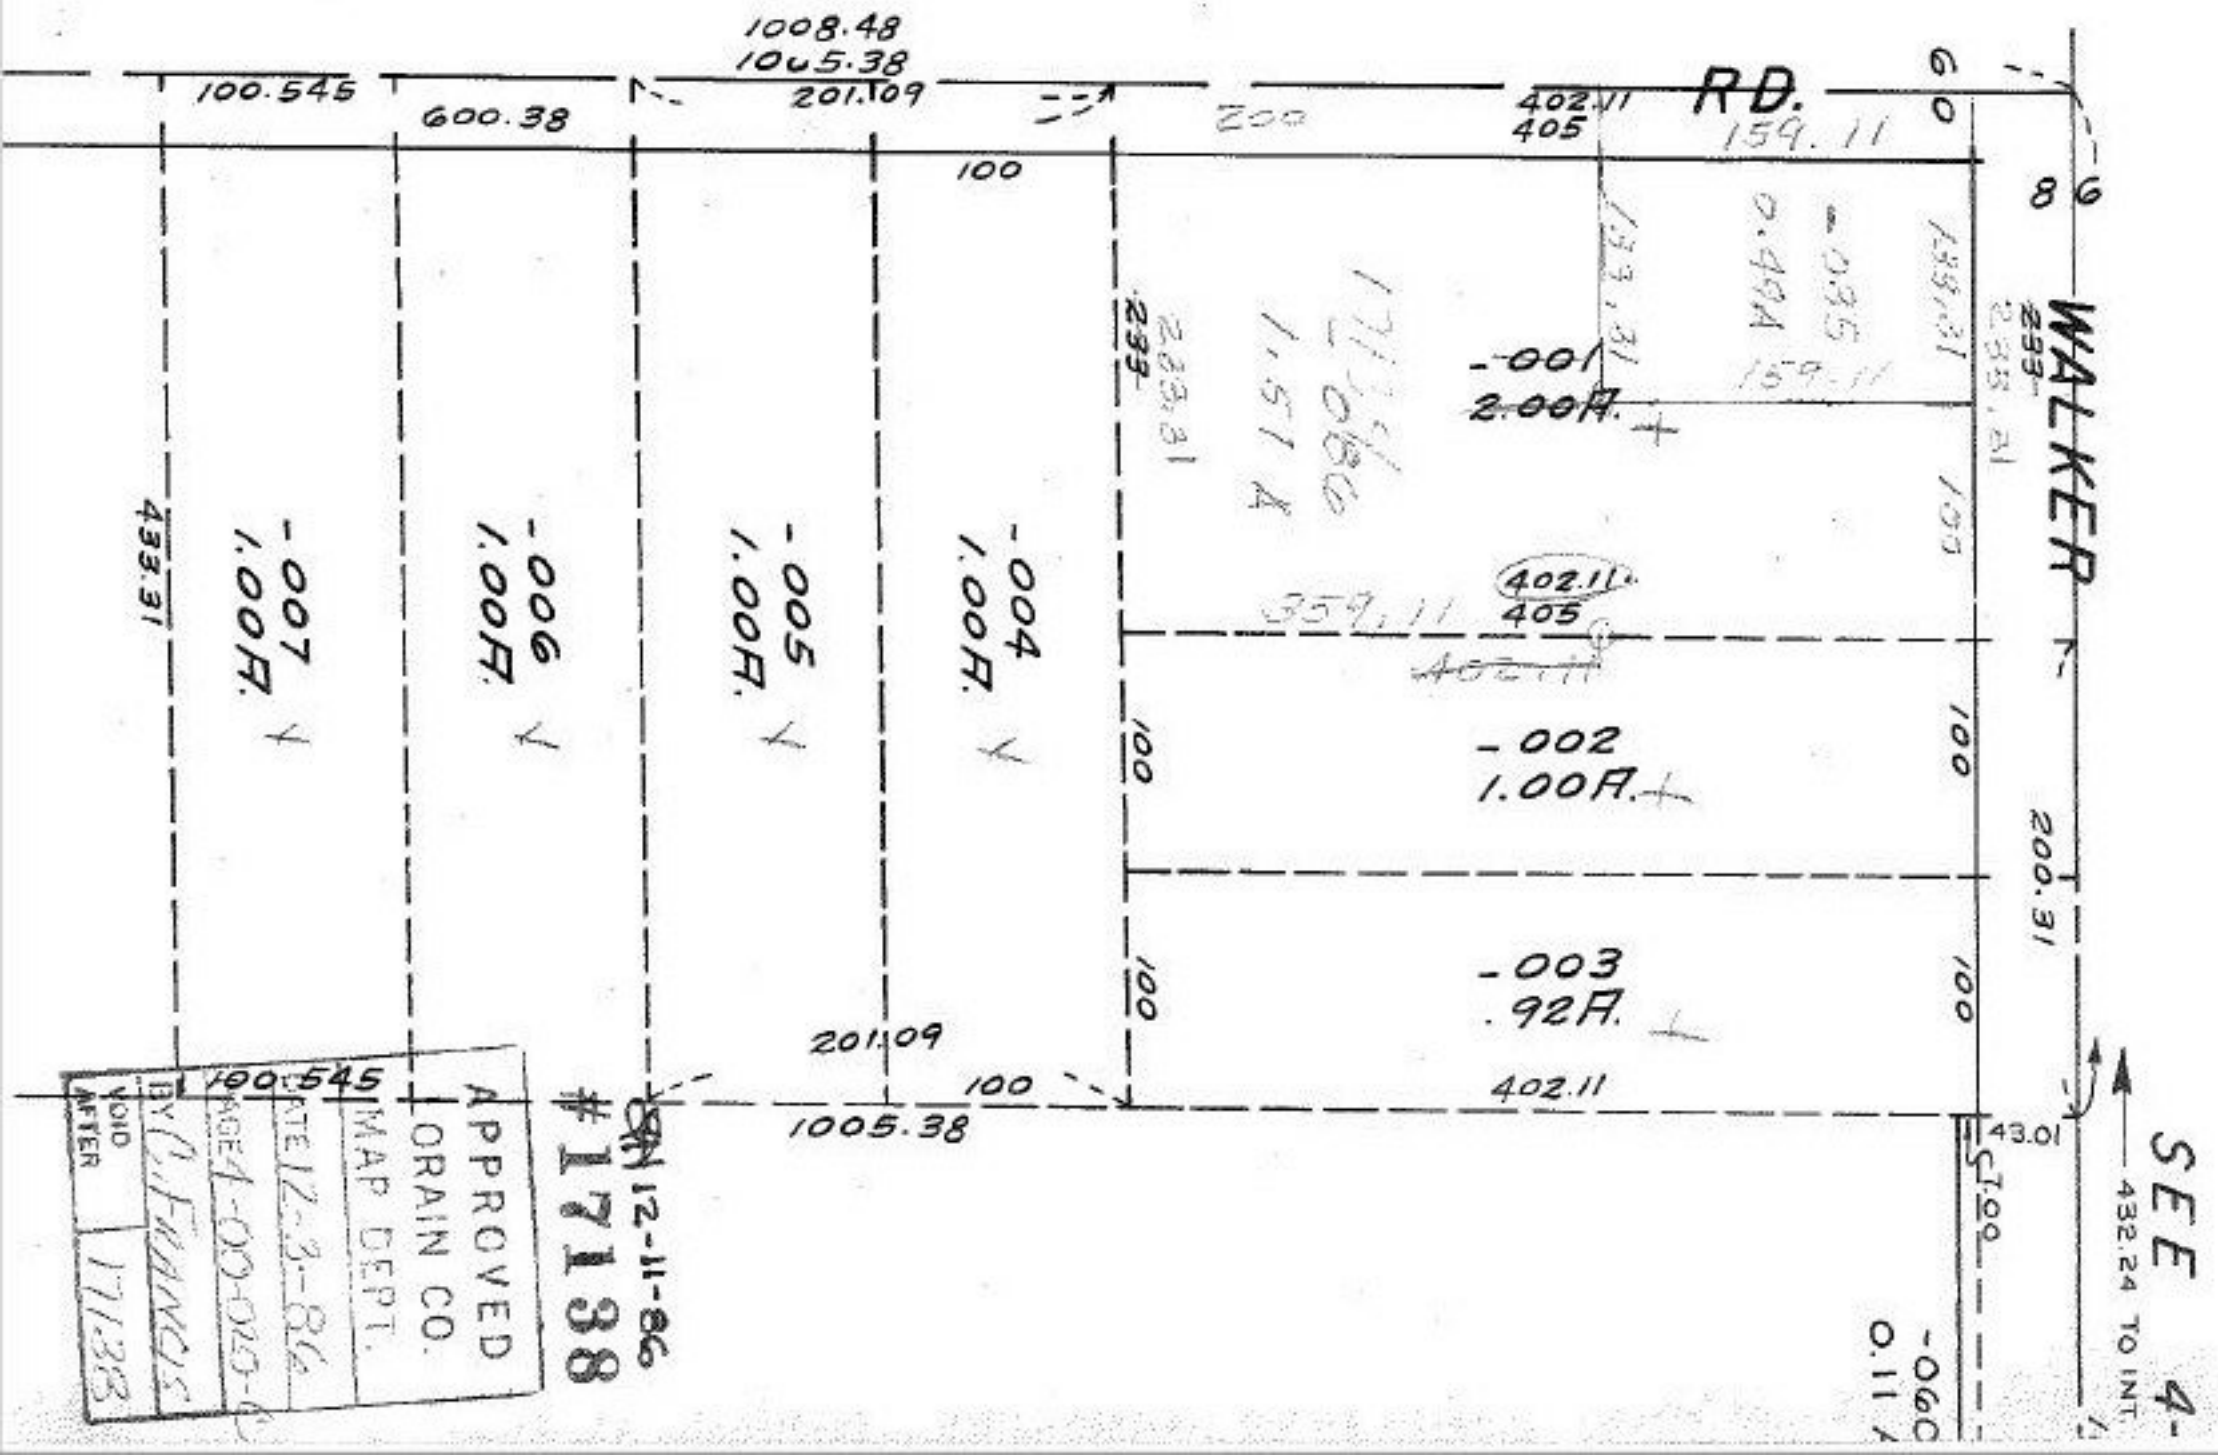04-00-020-104-~~00~~
Prior Deed 979-513
Surveyed By: William B. Barton
Reg. Surveyor
C=1:INF