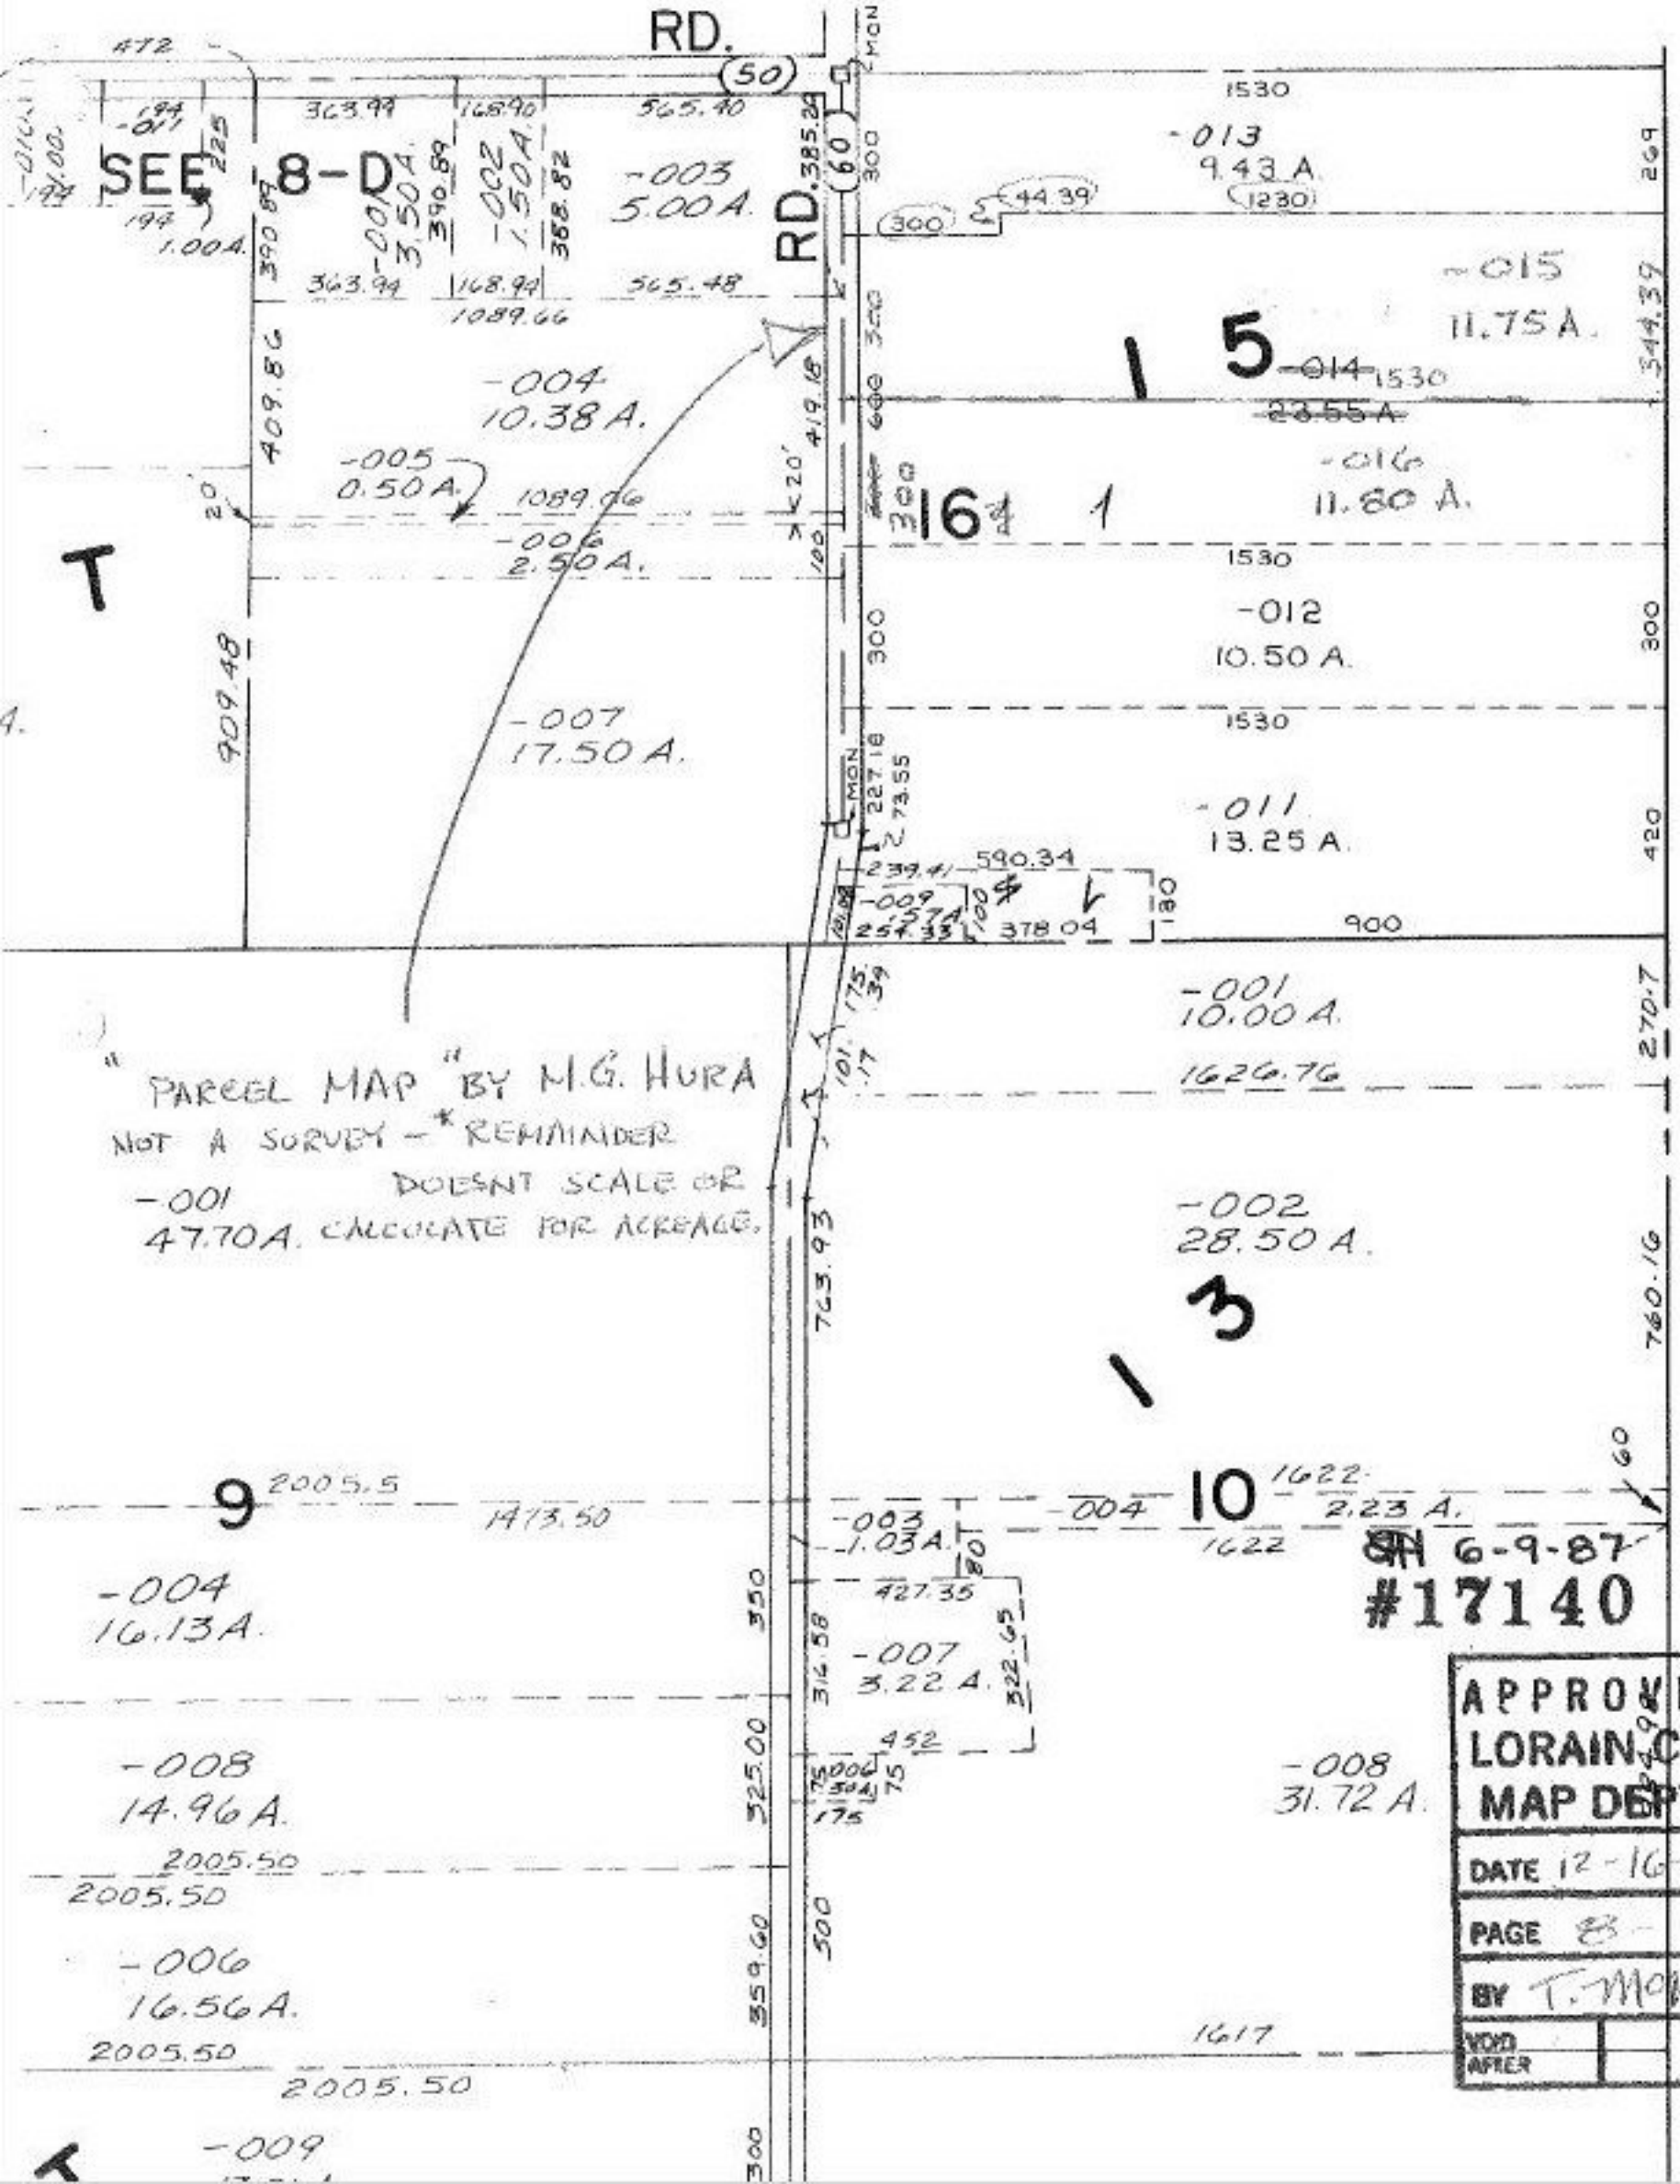
RD.
SEE 8-D
RD.
-003
5.00 A.
-004
10.38 A.
-005
0.50 A.
-006
2.50 A.
-007
17.50 A.
-013
9.43 A.
-015
11.75 A.
-014
23.55 A.
-016
11.80 A.
-012
10.50 A.
-011
13.25 A.
-001
10.00 A.
-002
28.50 A.
-001
47.70 A.
"PARCEL MAP" BY M.G. HURA
NOT A SURVEY - *REMAINDER
DOESNT SCALE OR
CALCULATE FOR ACREAGE.
-004
16.13 A.
-008
14.96 A.
-006
16.56 A.
-009
-003
1.03 A.
-007
3.22 A.
-004
2.23 A.
-008
31.72 A.
6-9-87
#17140
APPROVED
LORAIN CO.
MAP DEPT.
DATE 12-16-86
PAGE 8-H
BY T. McNair
VOID
AFTER