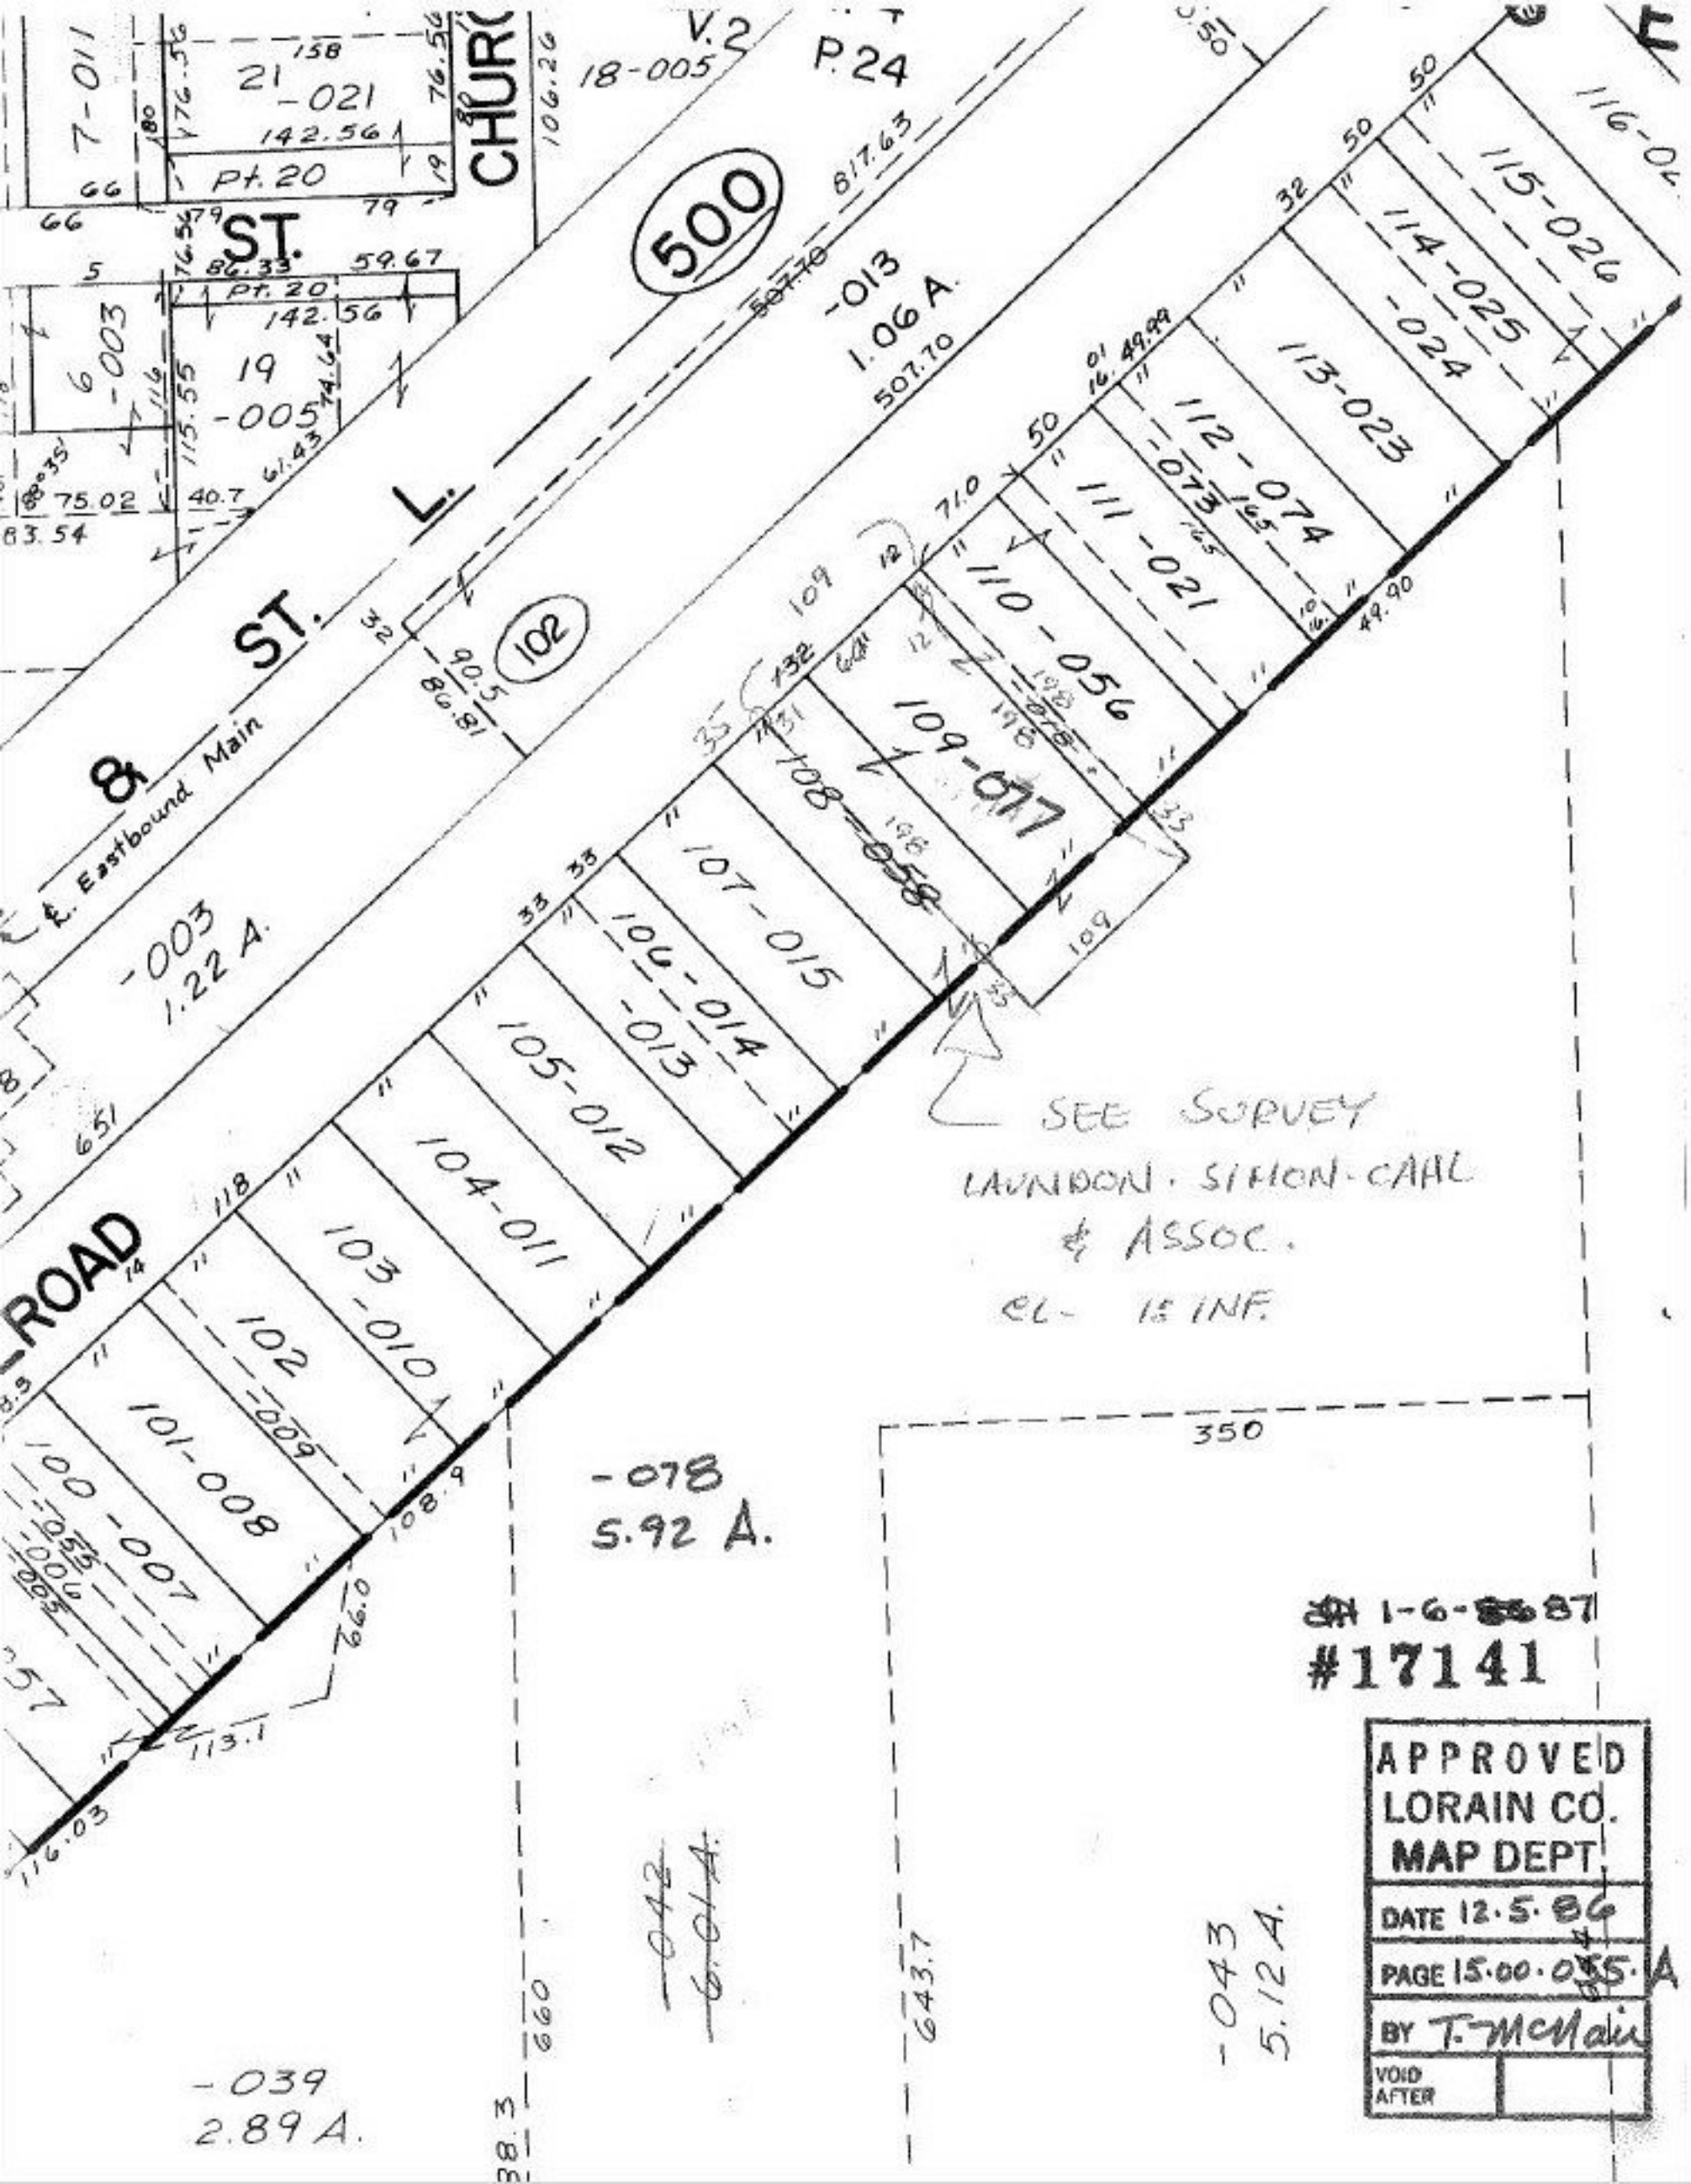

1-6-87

#17141

APPROVED
LORAIN CO.
MAP DEPT.
DATE 12.5.86
PAGE 15.00.055.A
BY T. McNair
VOID AFTER