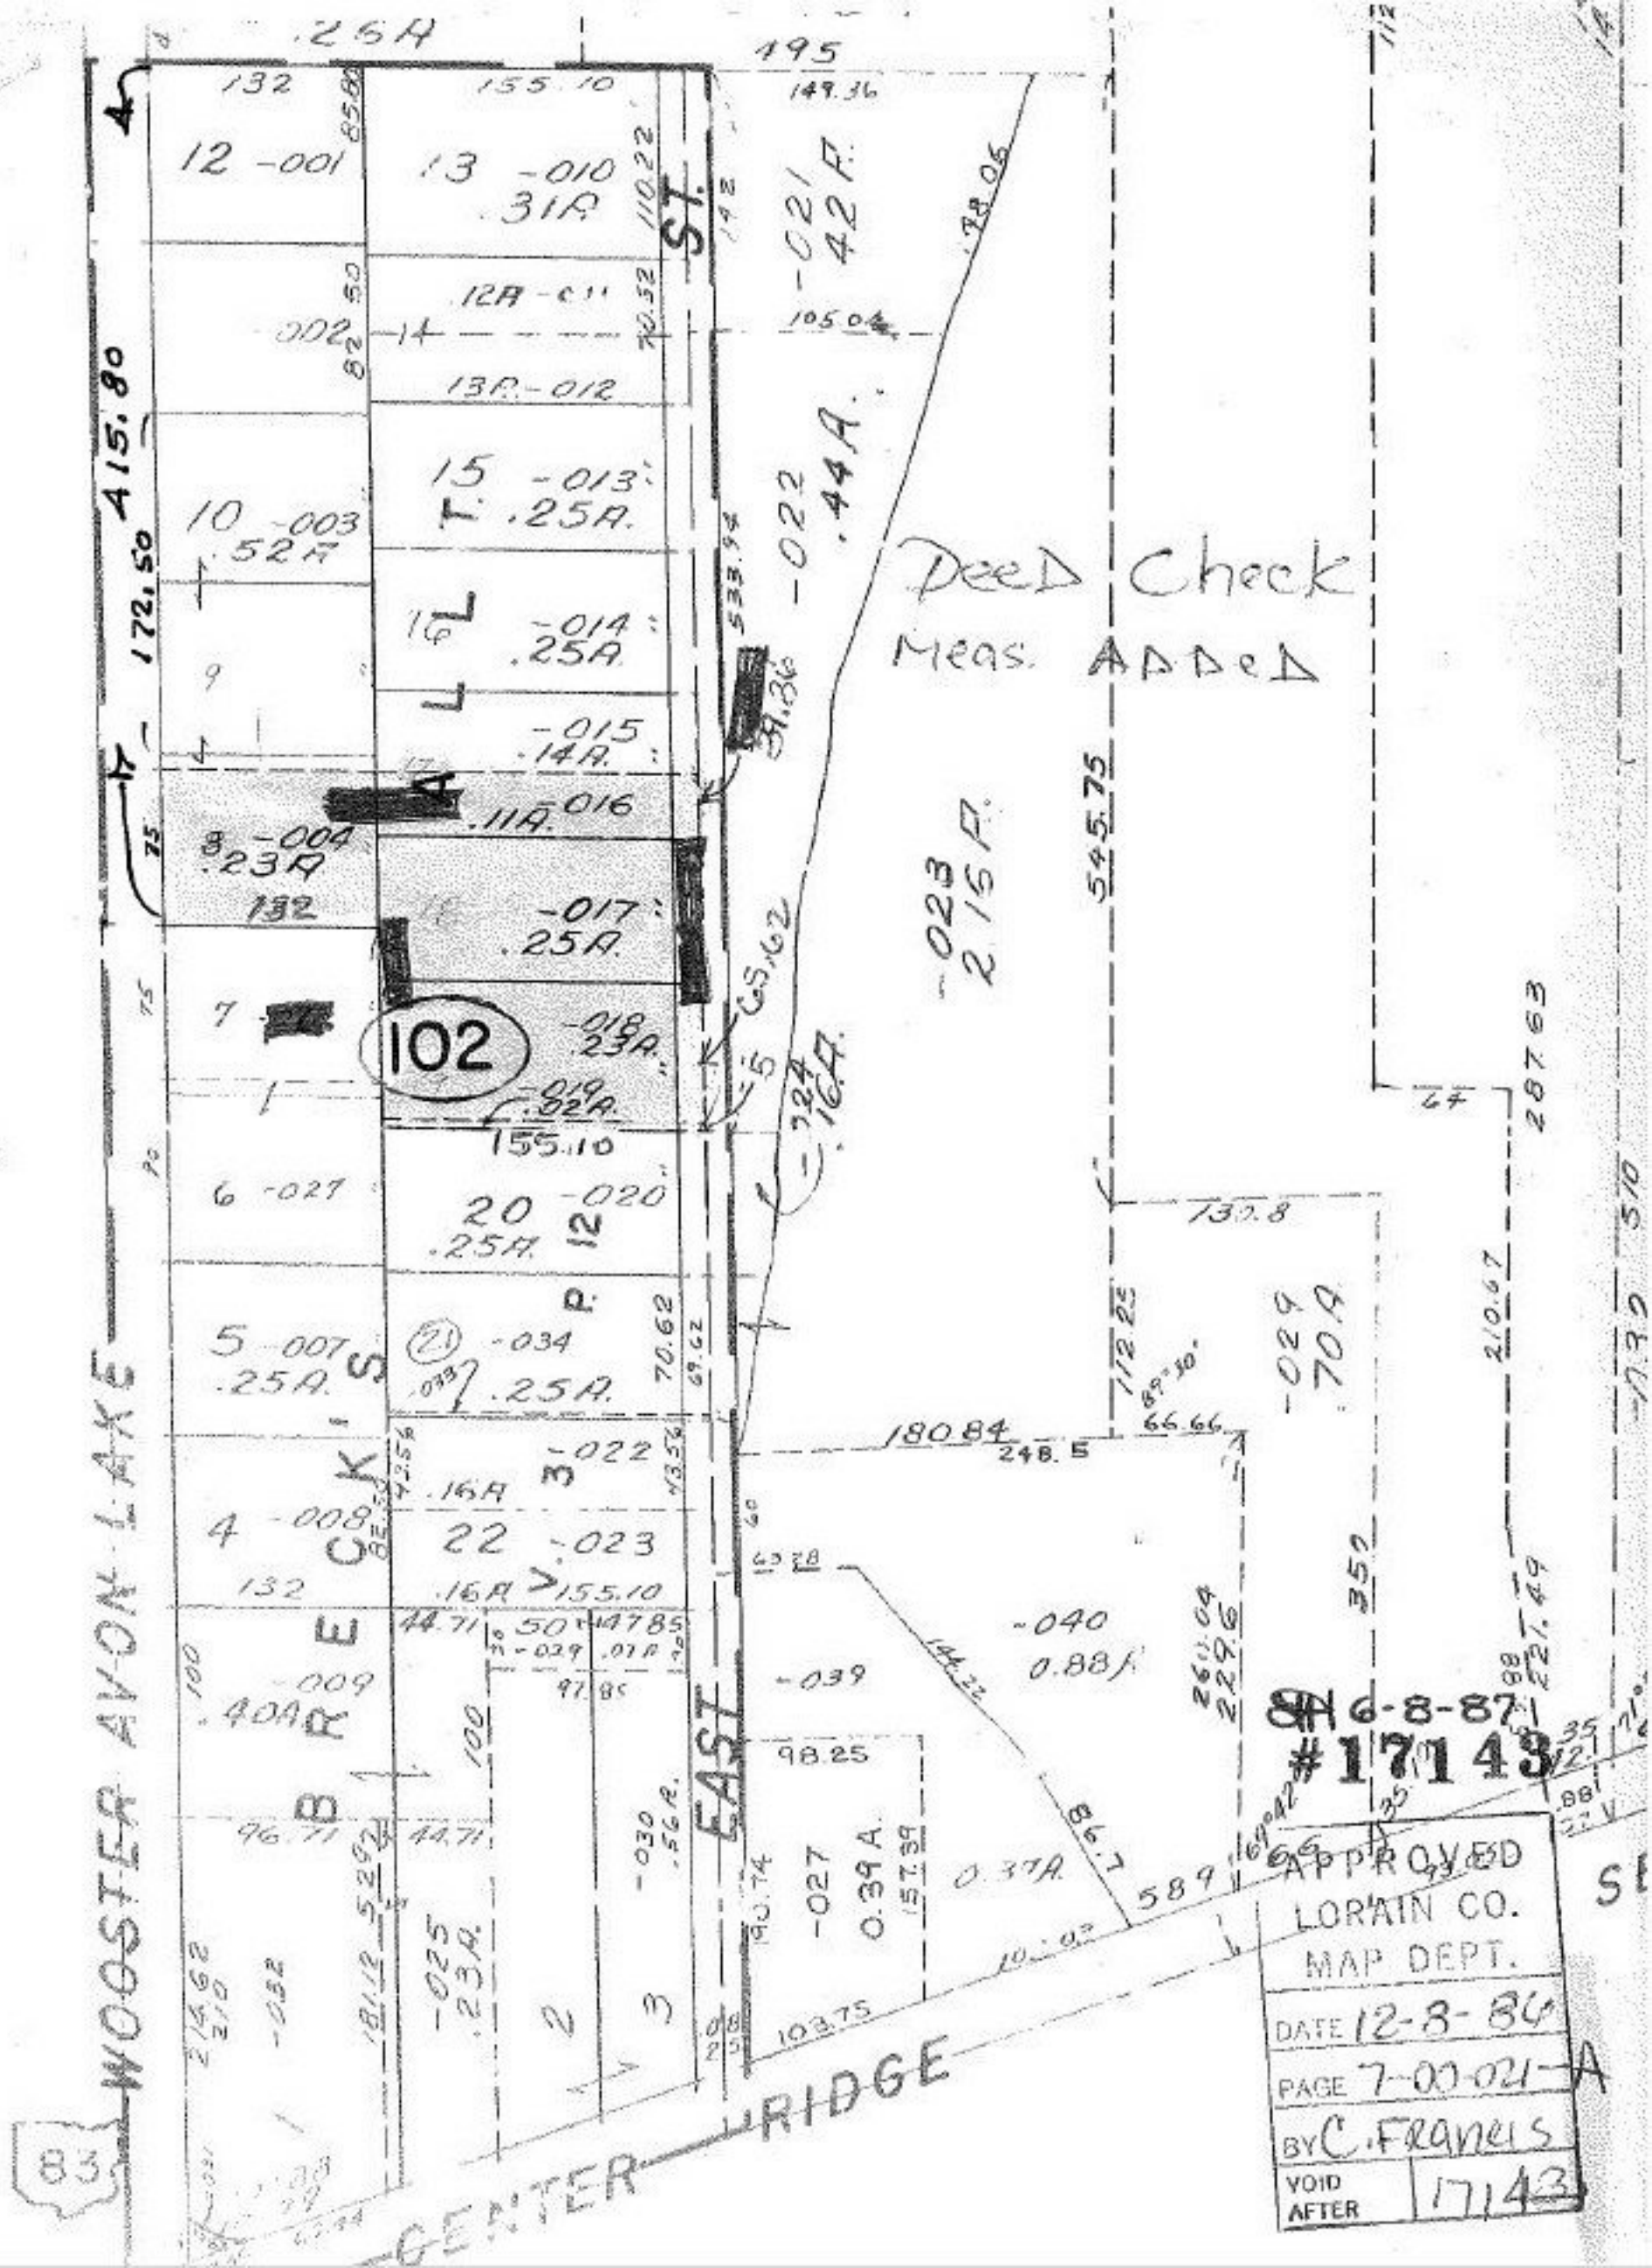

Deed Check
Meas. Added
WOOSTER AVON LAKE
BRECK'S
EAST
ALLT
ST.
GENTER RIDGE
102
12 -001
13 -010 .31A
15 -013 .25A
10 -003 .52A
16 -014 .25A
-015 .14A
-016 .11A
8 -004 .23A
-017 .25A
7
-018 .23A
-019 .02A
6 -027
20 -020 .25A
5 -007 .25A
21 -034 .25A
4 -008
22 -023 .16A
-009 .40A
-021 .42A
-022 .44A
-023 2.16A
-024 .16A
-029 .70A
-040 0.88A
-027 0.39A
-025 .23A
-030 .56A
-039
0.37A
545.75
180.84
248.5
6-8-87
#17143
APPROVED
LORAIN CO.
MAP DEPT.
DATE 12-8-86
PAGE 7-00-021-A
BY C. Francis
VOID AFTER 17143