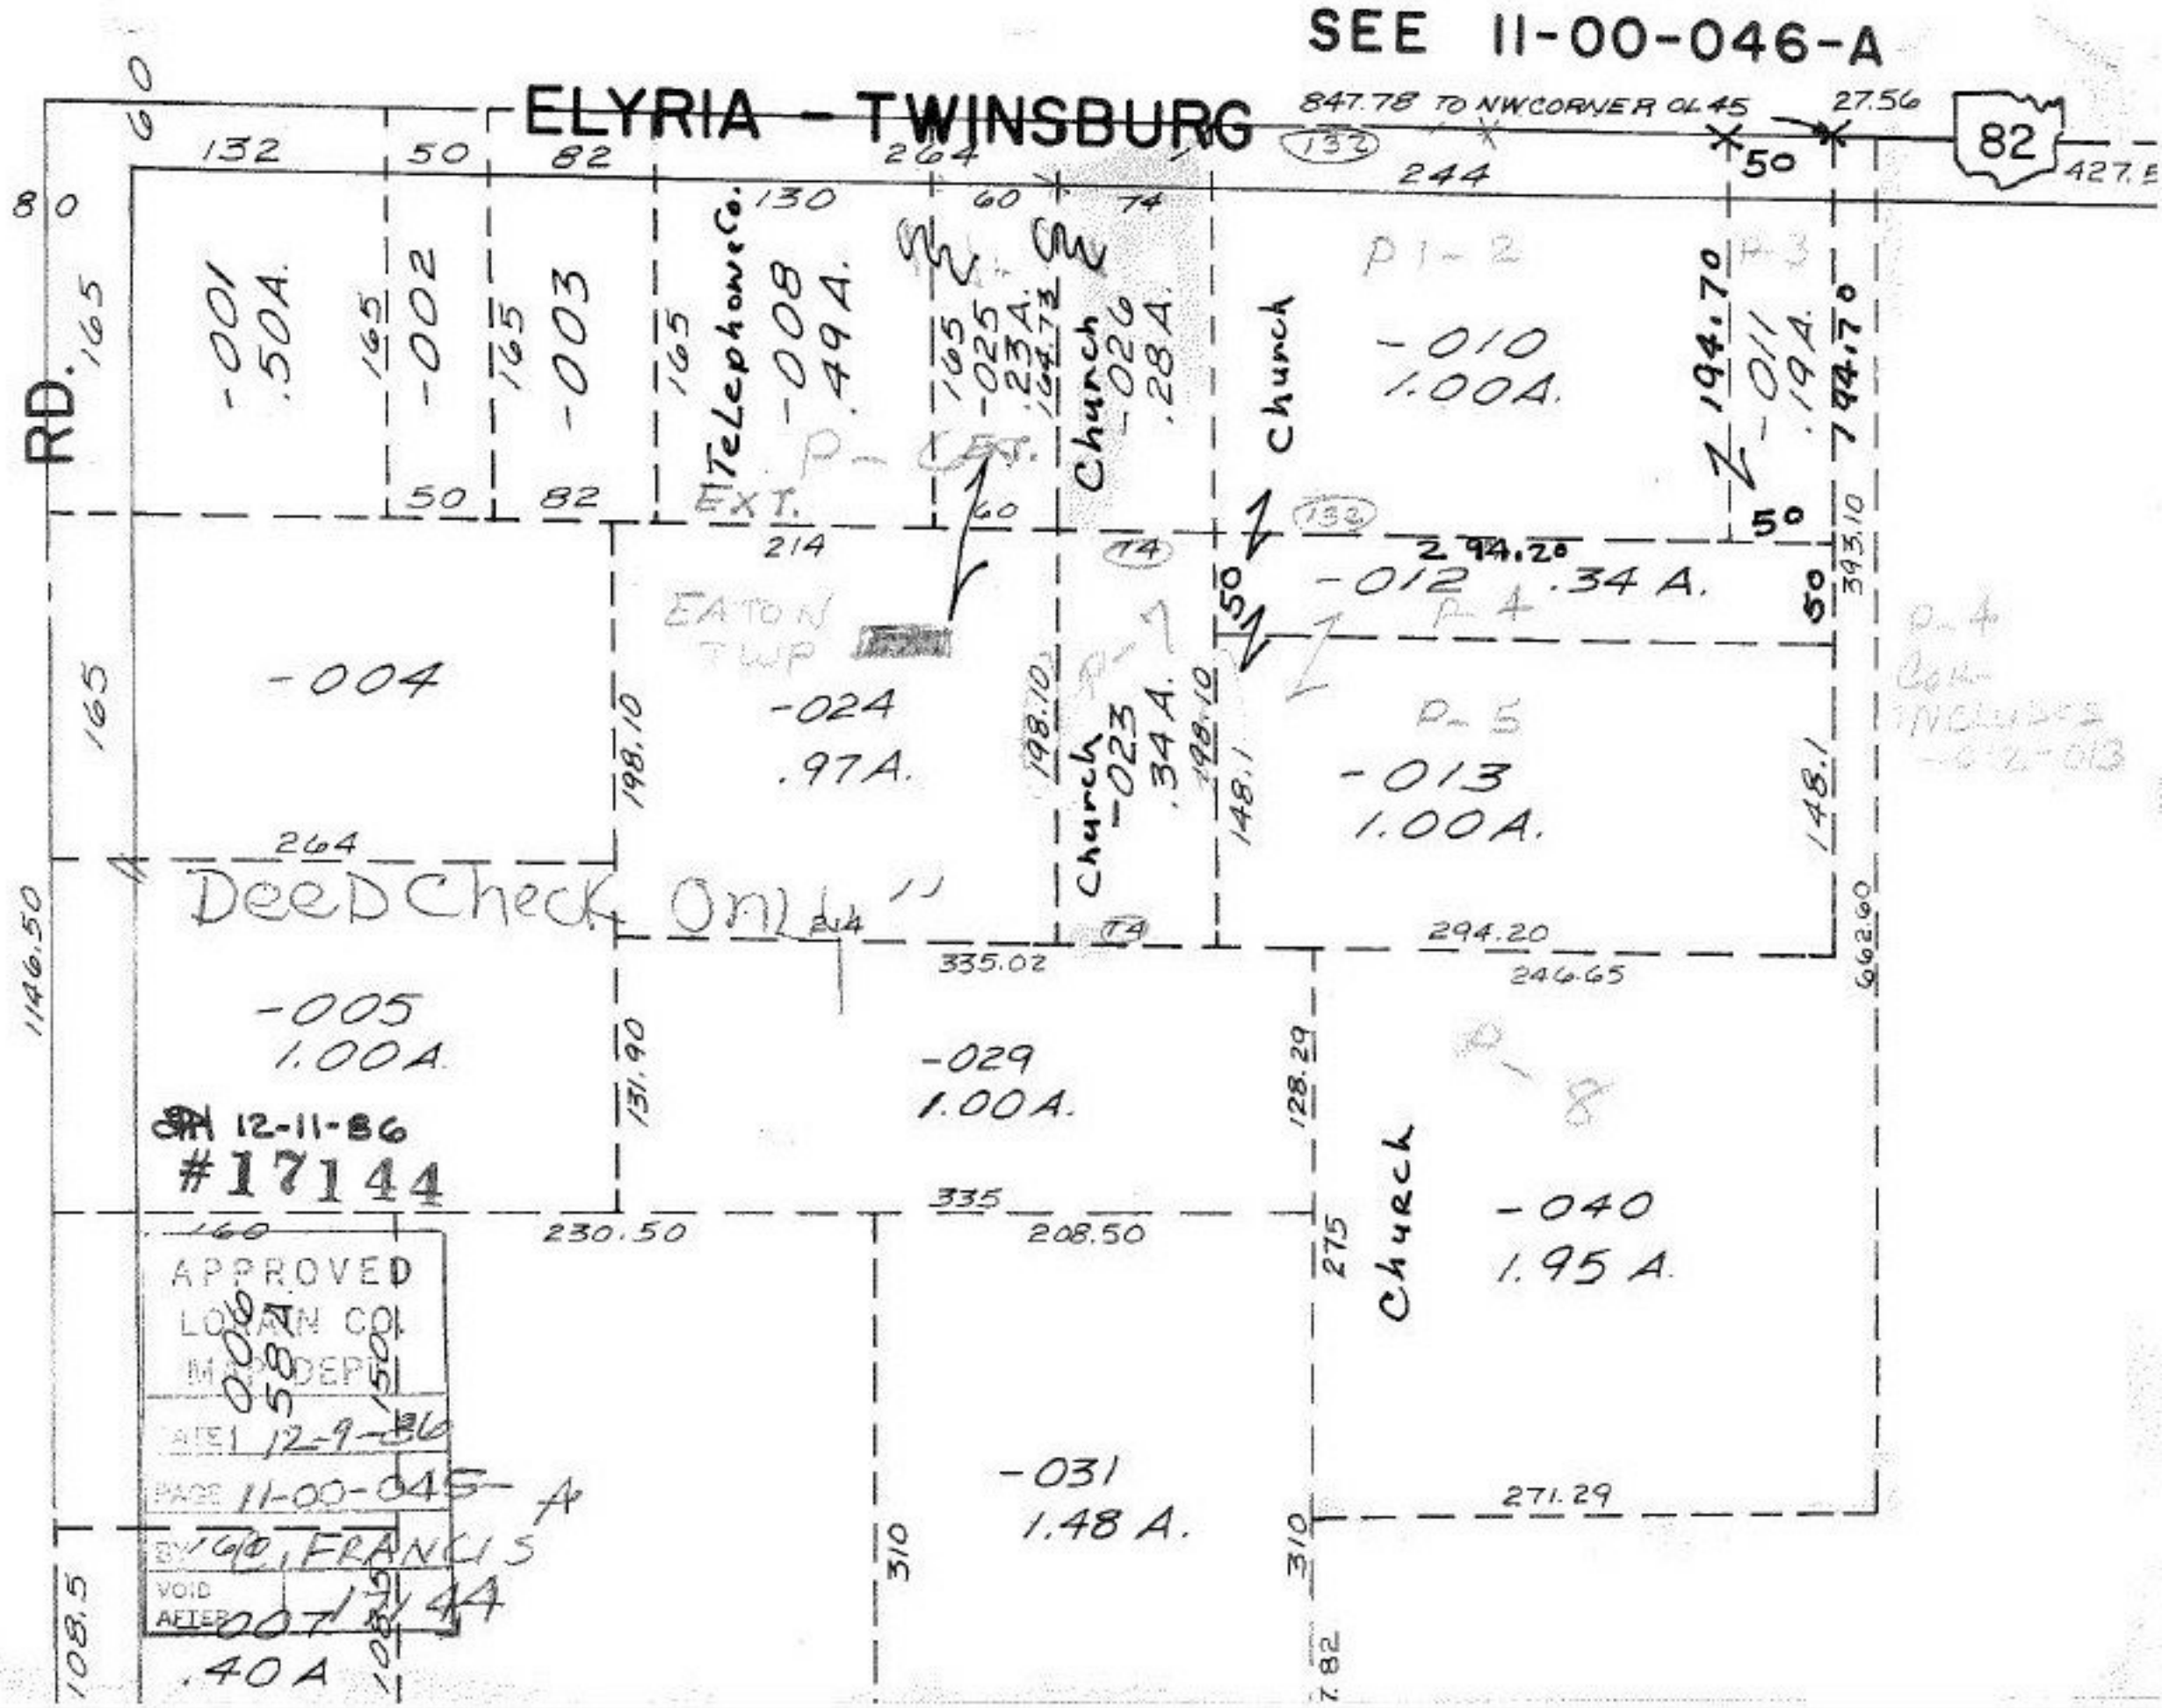
SEE 11-00-046-A
ELYRIA - TWINSBURG
847.78 TO NW CORNER OL 45
27.56
82
427.5
RD.
-001
.50A.
-002
-003
Telephone Co.
-008
.49 A.
-025
.23A.
Church
-026
.28 A.
Church
-010
1.00A.
-011
.19A.
-012
.34 A.
-004
EATON TWP
-024
.97A.
Church
-023
.34 A.
-013
1.00A.
Deed Check Only
-005
1.00A.
-029
1.00A.
Church
-040
1.95 A.
-031
1.48 A.
.40 A
12-11-86
#17144
APPROVED
LORAIN CO.
MAP DEPT.
DATE 12-9-86
PAGE 11-00-045-A
BY C. FRANCIS
VOID AFTER 17144