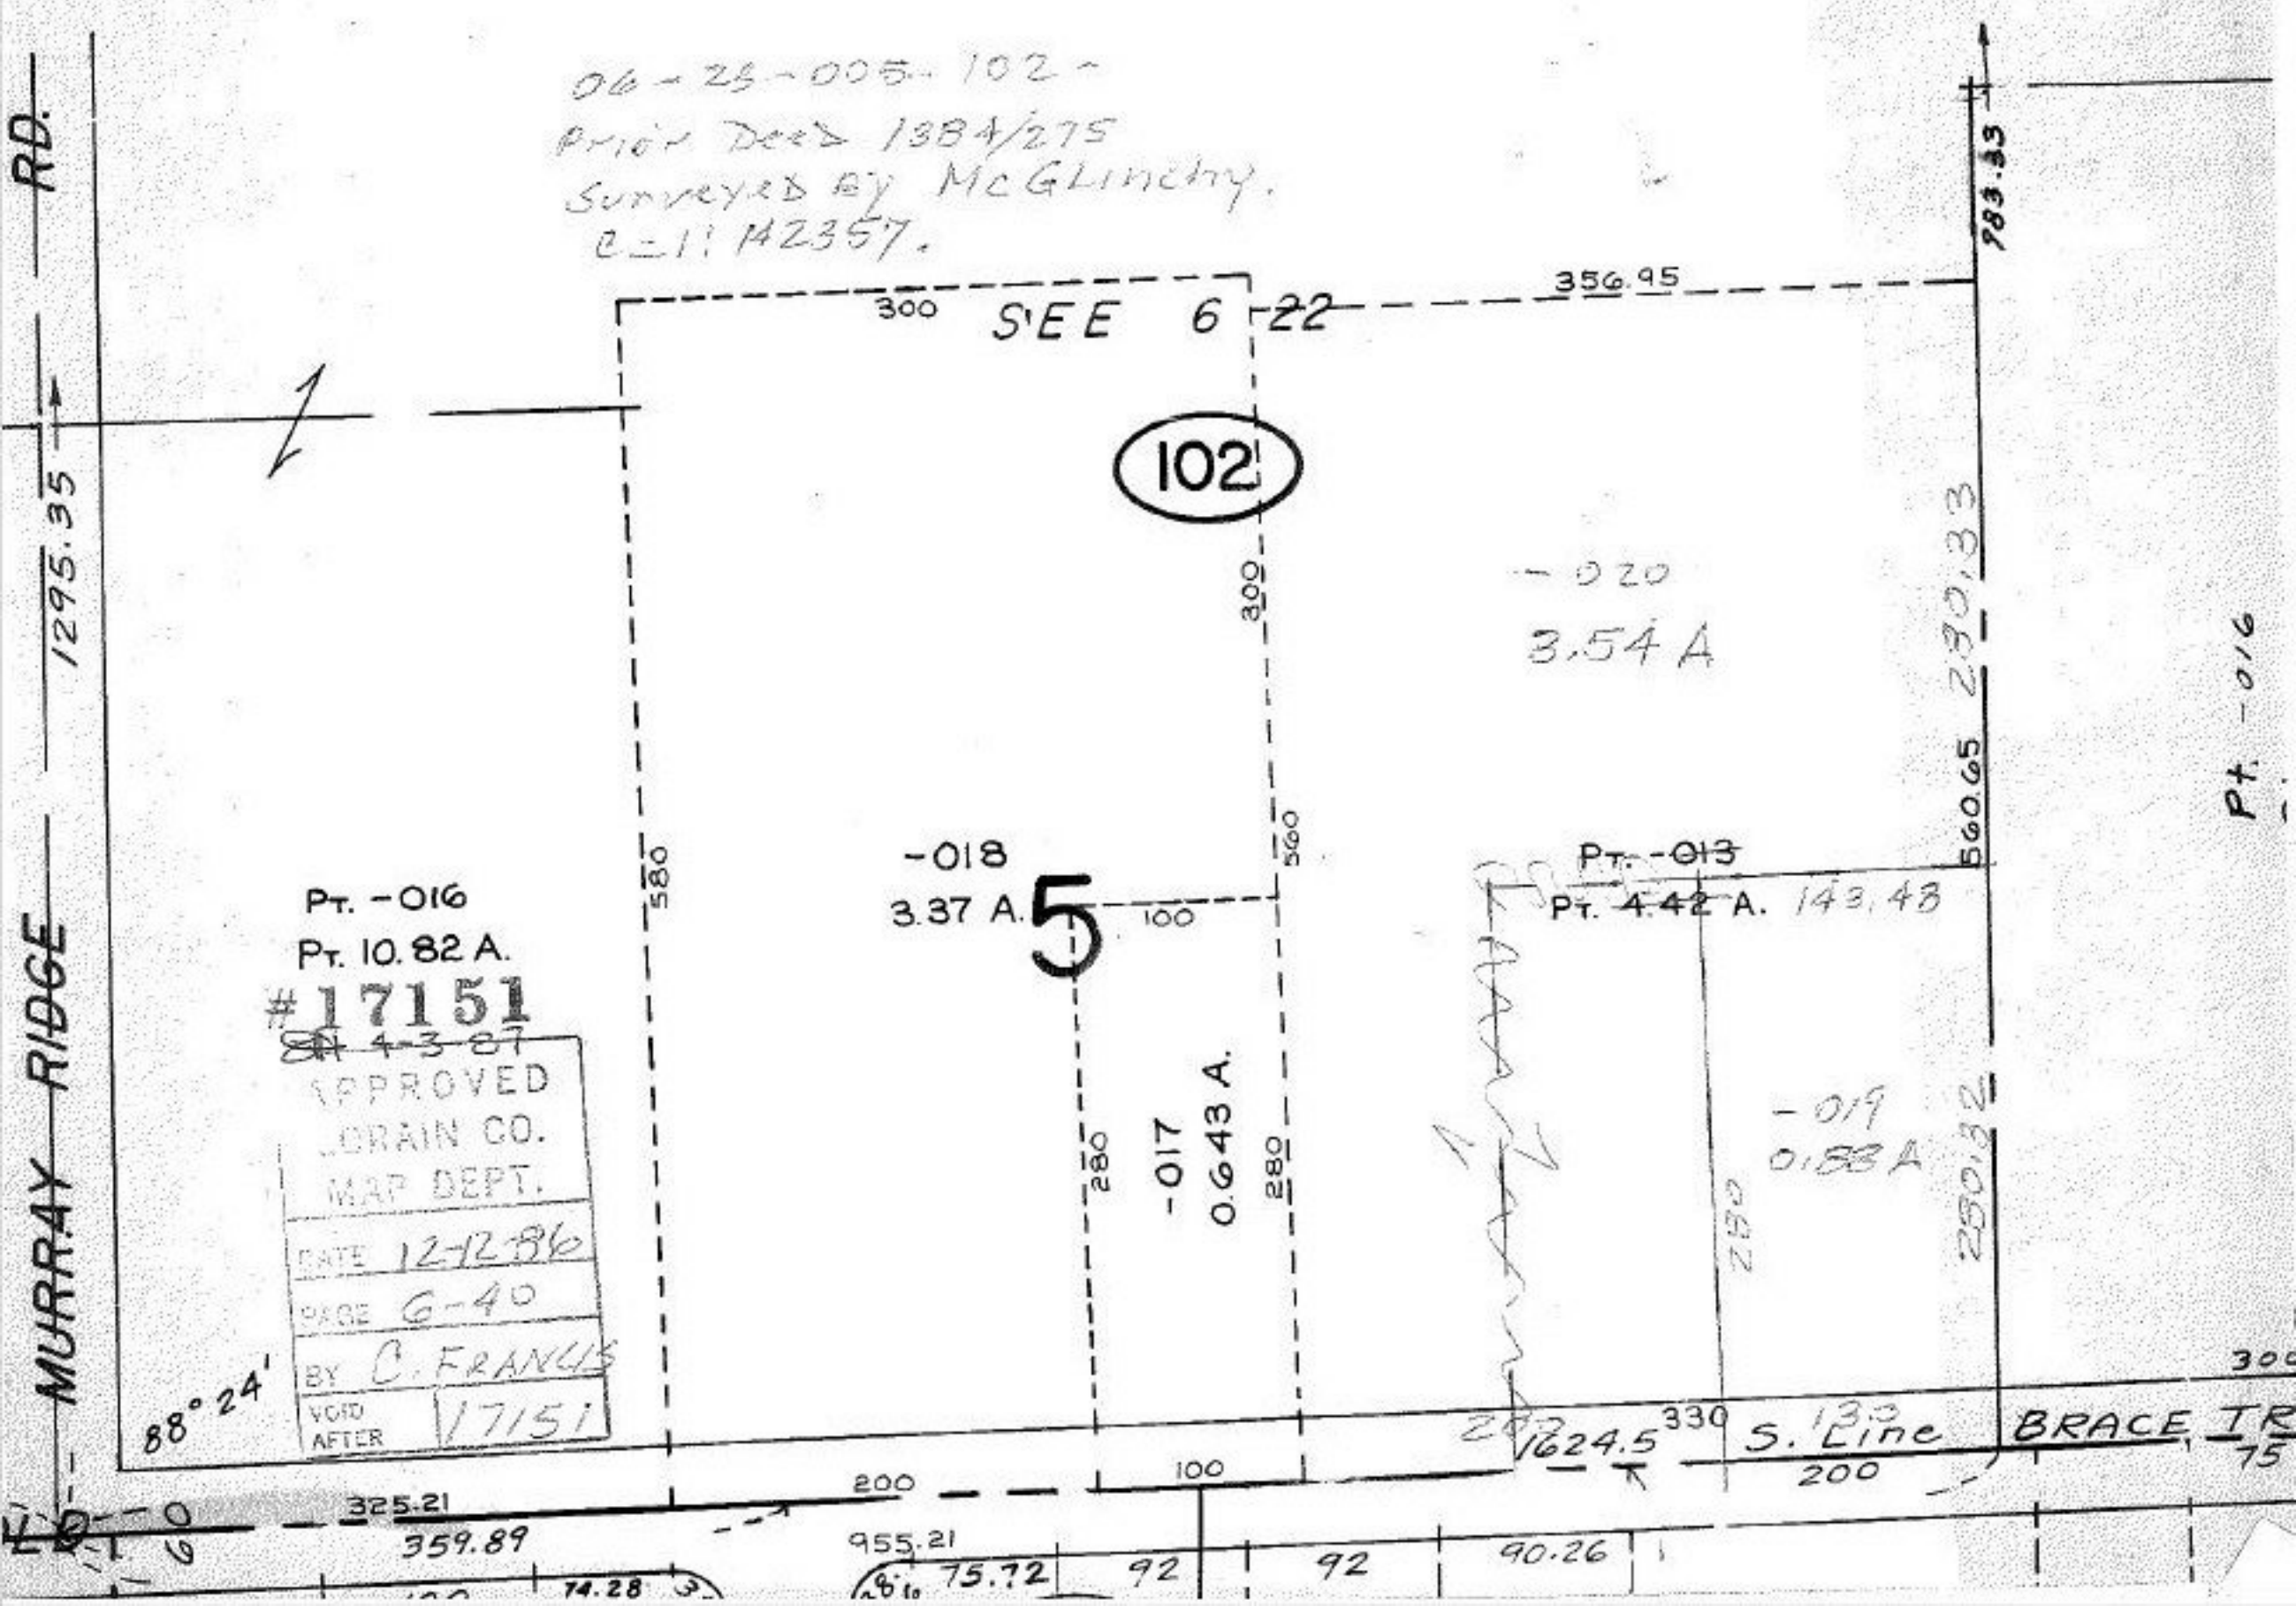
06-25-005-102-
Prior Deed 1384/275
Surveyed by McGlinchy.
C=1: 142357.
RD.
MURRAY RIDGE
1295.35
300
SEE 6-22
356.95
983.33
102
300
-020
3.54 A
280.33
560.65
Pt. -016
580
-018
3.37 A.
5
100
560
Pt. -013
Pt. 4.42 A. 143.48
Pt. -016
Pt. 10.82 A.
#17151
APPROVED
LORAIN CO.
MAP DEPT.
DATE 12-12-86
PAGE 6-40
BY C. FRANCIS
VOID AFTER 17151
280
-017
0.643 A.
280
-019
0.88 A
280
280.32
88° 24'
1624.5
330
S. Line
BRACE TR
200
100
325.21
359.89
955.21
75.72
92
92
90.26
74.28