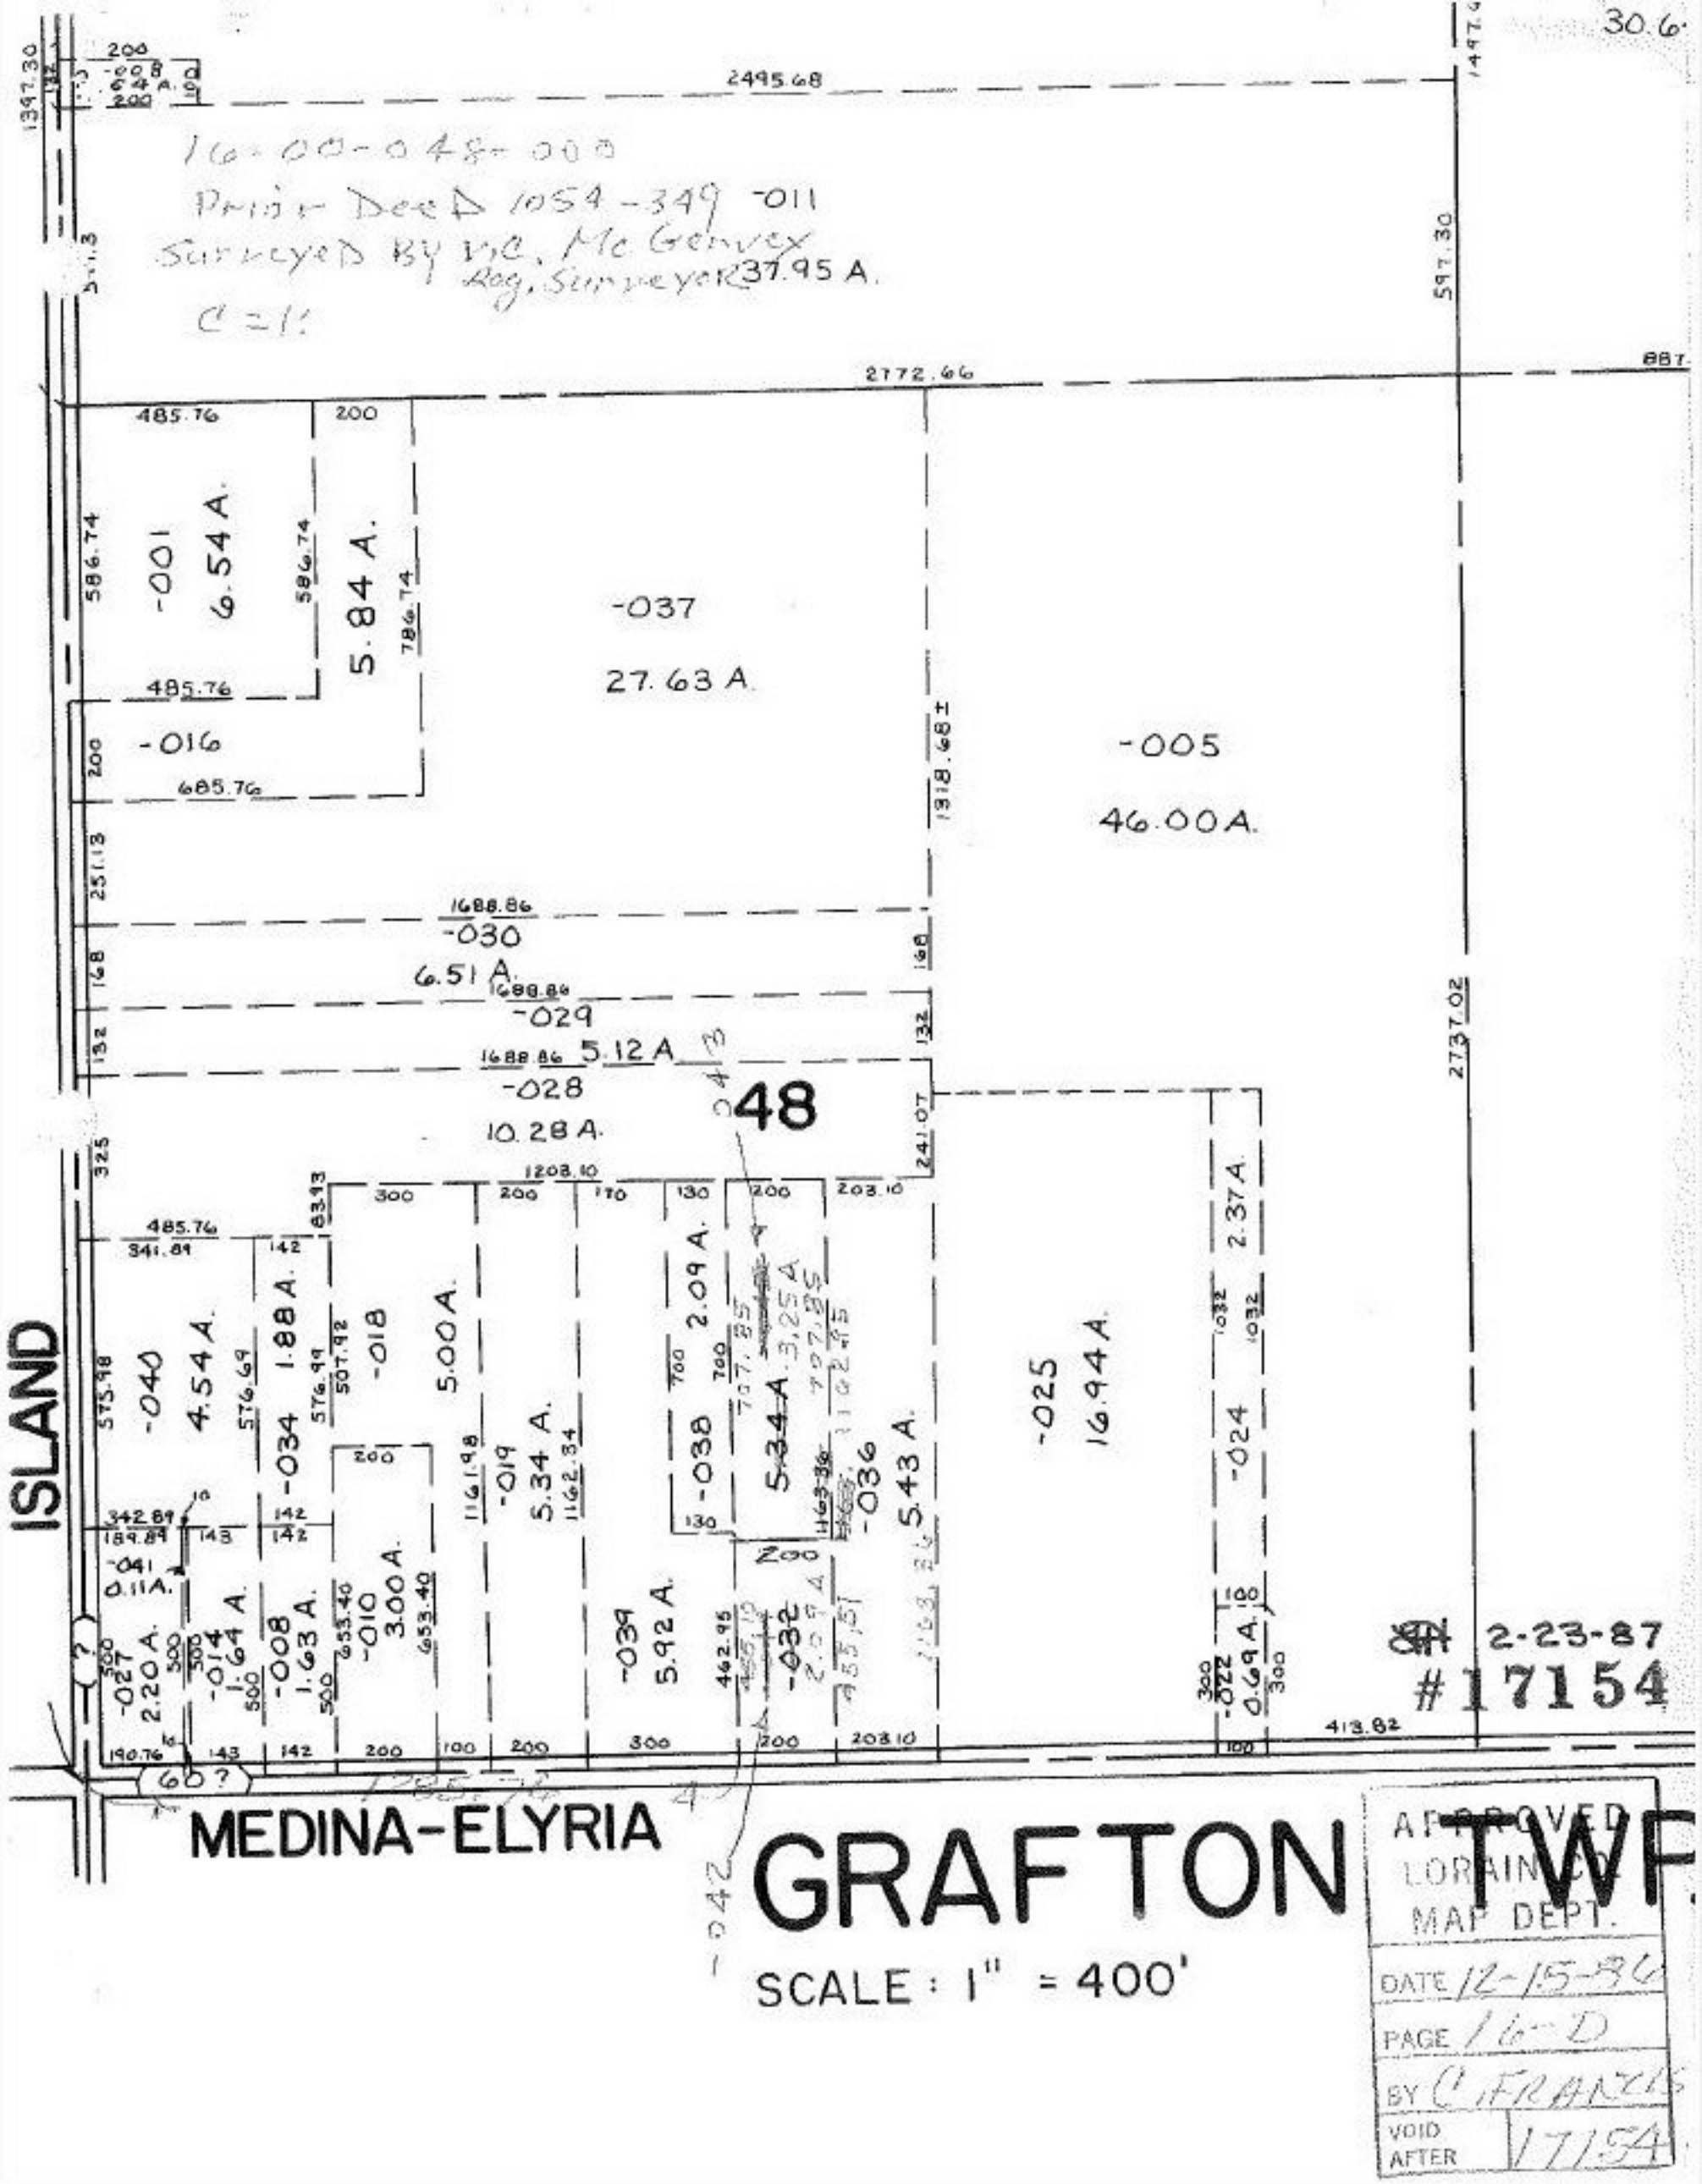
16-00-048-000
Prior Deed 1054-349 -011
Surveyed By V.C. McGervey
Reg. Surveyor
C=1
37.95 A.
2495.68
2772.66
-001
6.54 A.
5.84 A.
-037
27.63 A.
-016
-005
46.00 A.
-030
6.51 A.
-029
5.12 A.
-028
10.28 A.
48
-040
4.54 A.
-034
1.88 A.
-018
5.00 A.
-019
5.34 A.
-038
2.09 A.
-036
5.43 A.
-025
16.94 A.
-024
2.37 A.
-041
0.11 A.
-027
2.20 A.
-014
1.64 A.
-008
1.63 A.
-010
3.00 A.
-039
5.92 A.
-032
-022
0.69 A.
ISLAND
MEDINA-ELYRIA
60?
2-23-87
#17154
GRAFTON TWP.
SCALE: 1" = 400'
APPROVED
LORAIN CO.
MAP DEPT.
DATE 12-15-86
PAGE 16-D
BY C. FRANCIS
VOID AFTER 17154