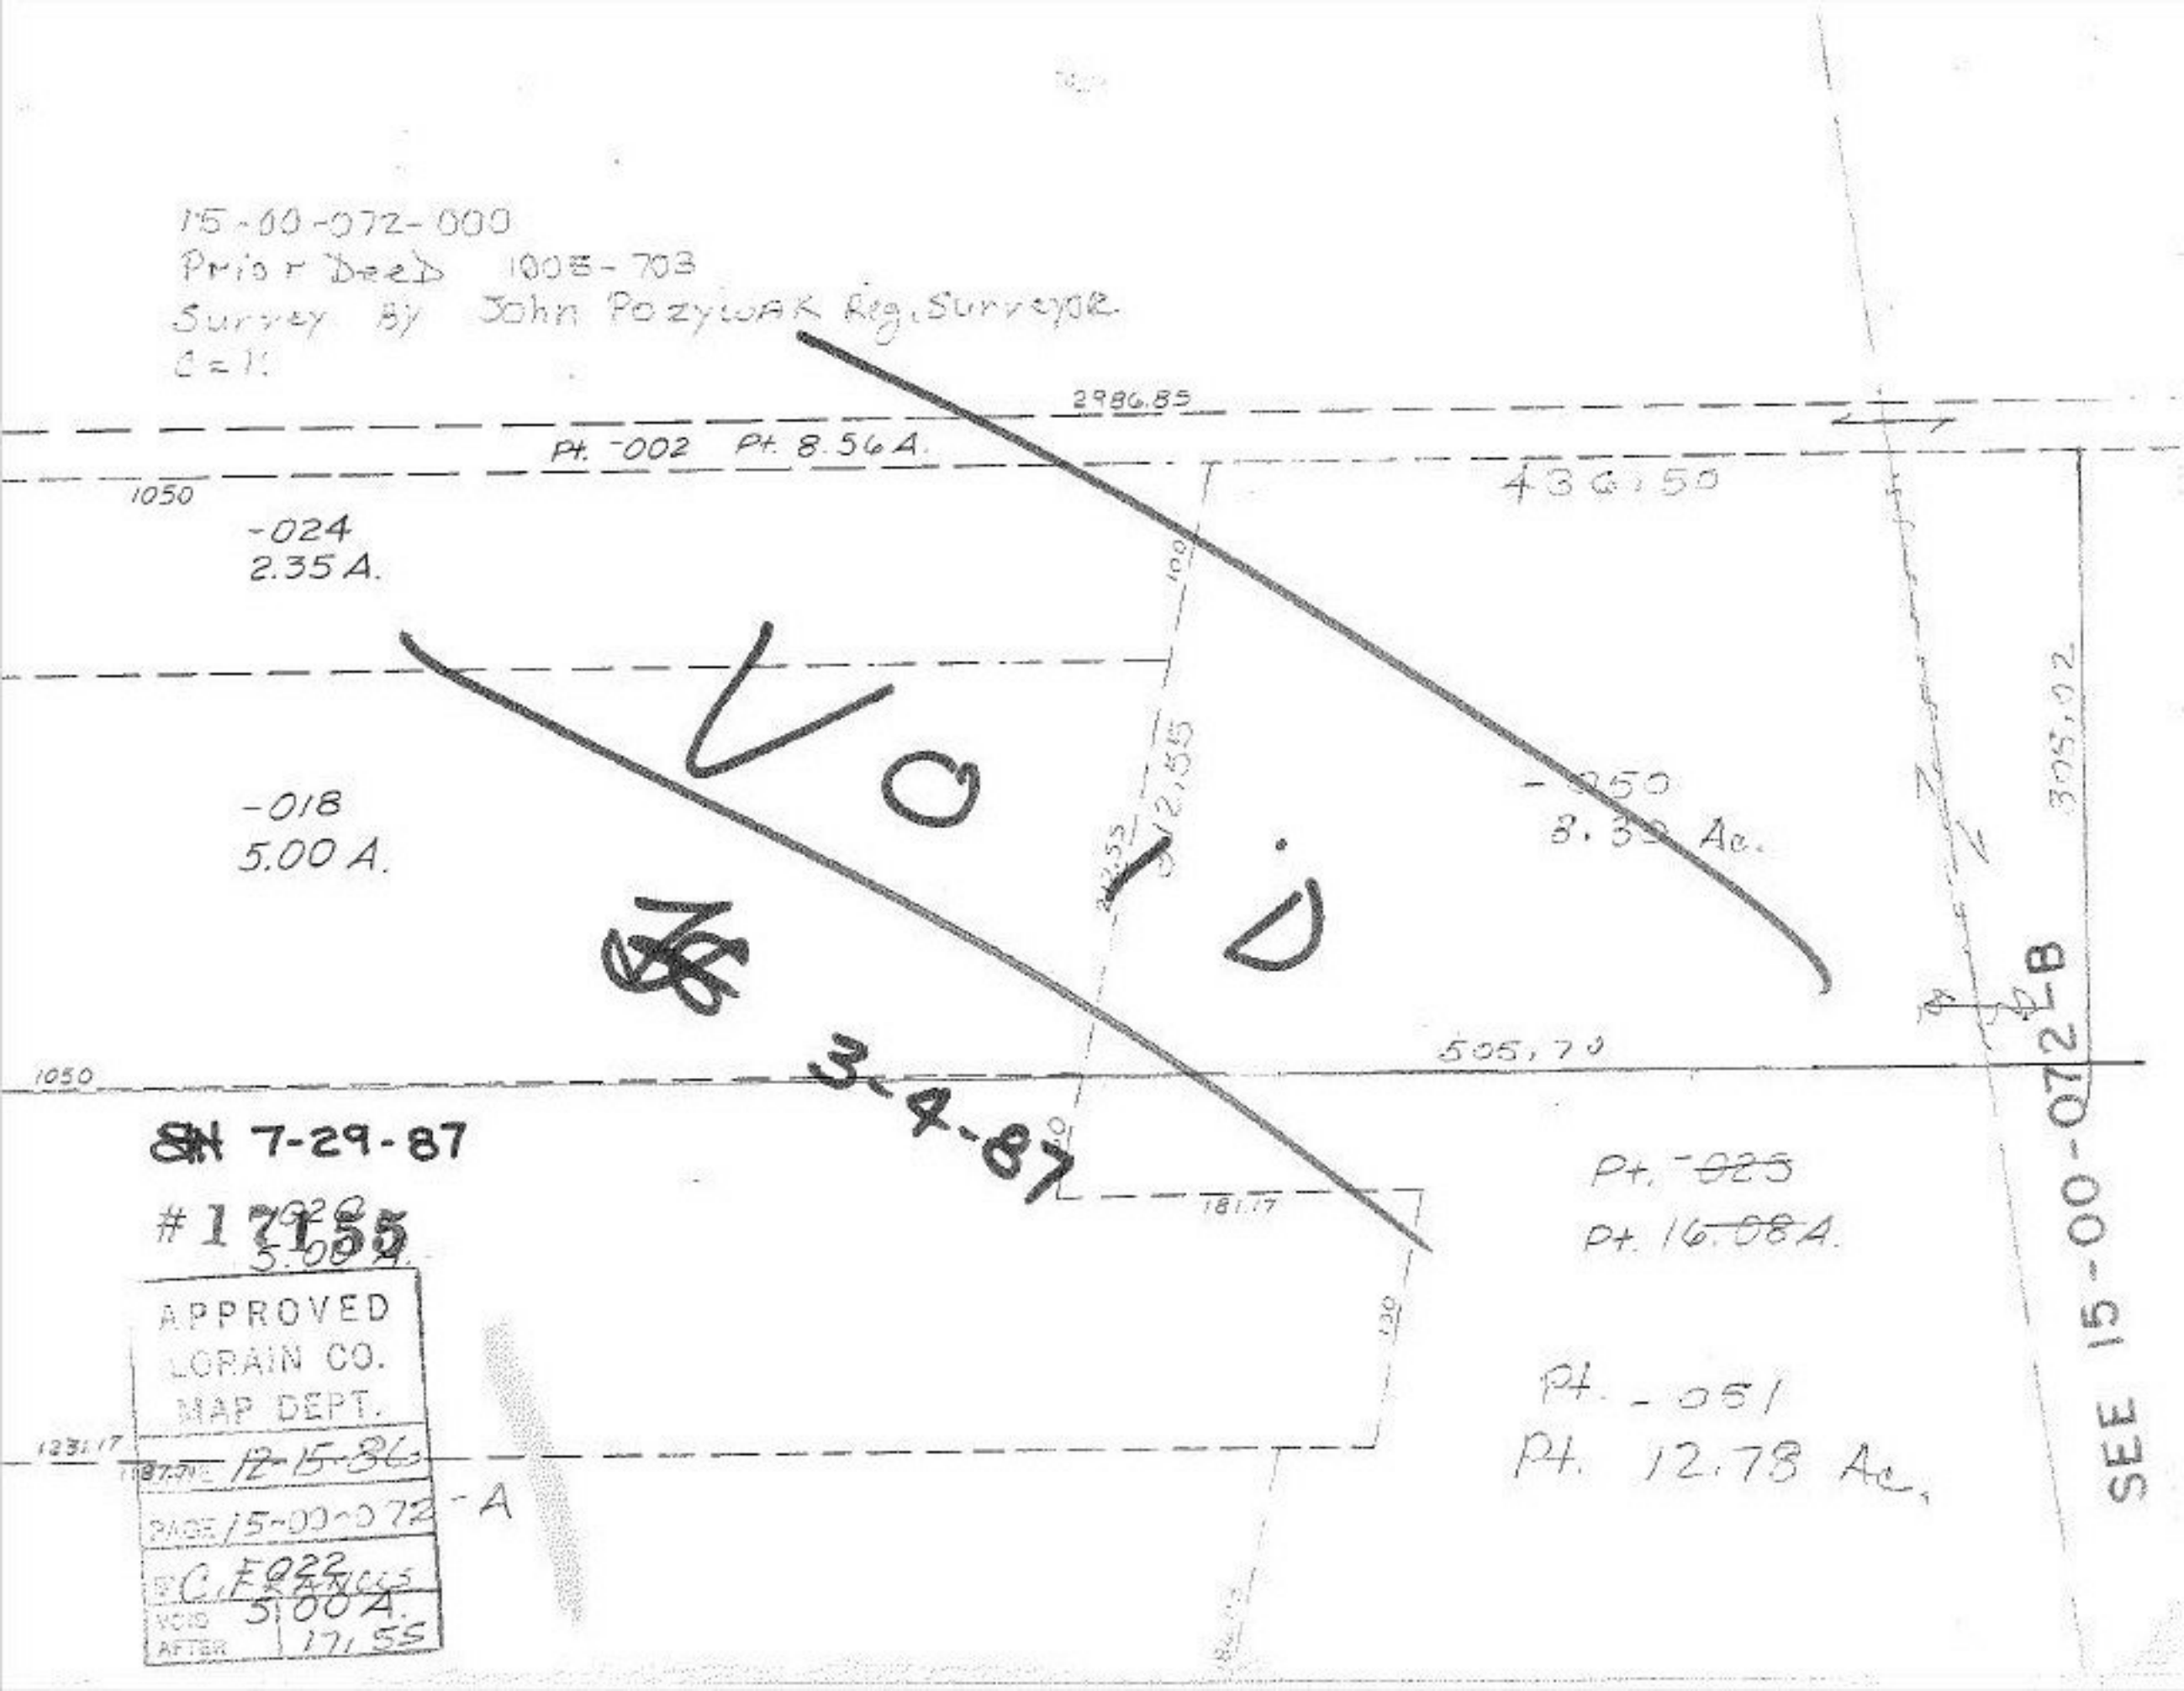
15-00-072-000
Prior Deed 1005-703
Survey By John Pozywak Reg. Surveyor
C=1
2986.85
Pt. -002 Pt. 8.56 A.
1050
436.50
-024
2.35 A.
100
305.02
-018
5.00 A.
12.55
-050
8.30 Ac.
VOID
3-4-87
505.70
1050
SH 7-29-87
#17155
5.00 A.
181.17
Pt. -025
Pt. 16.08 A.
APPROVED
LORAIN CO.
MAP DEPT.
12-15-86
PAGE 15-00-072-A
C. FRANCIS
VOID 5.00 A.
AFTER 17.55
Pt. -051
Pt. 12.78 Ac.
1231.17
SEE 15-00-072-B