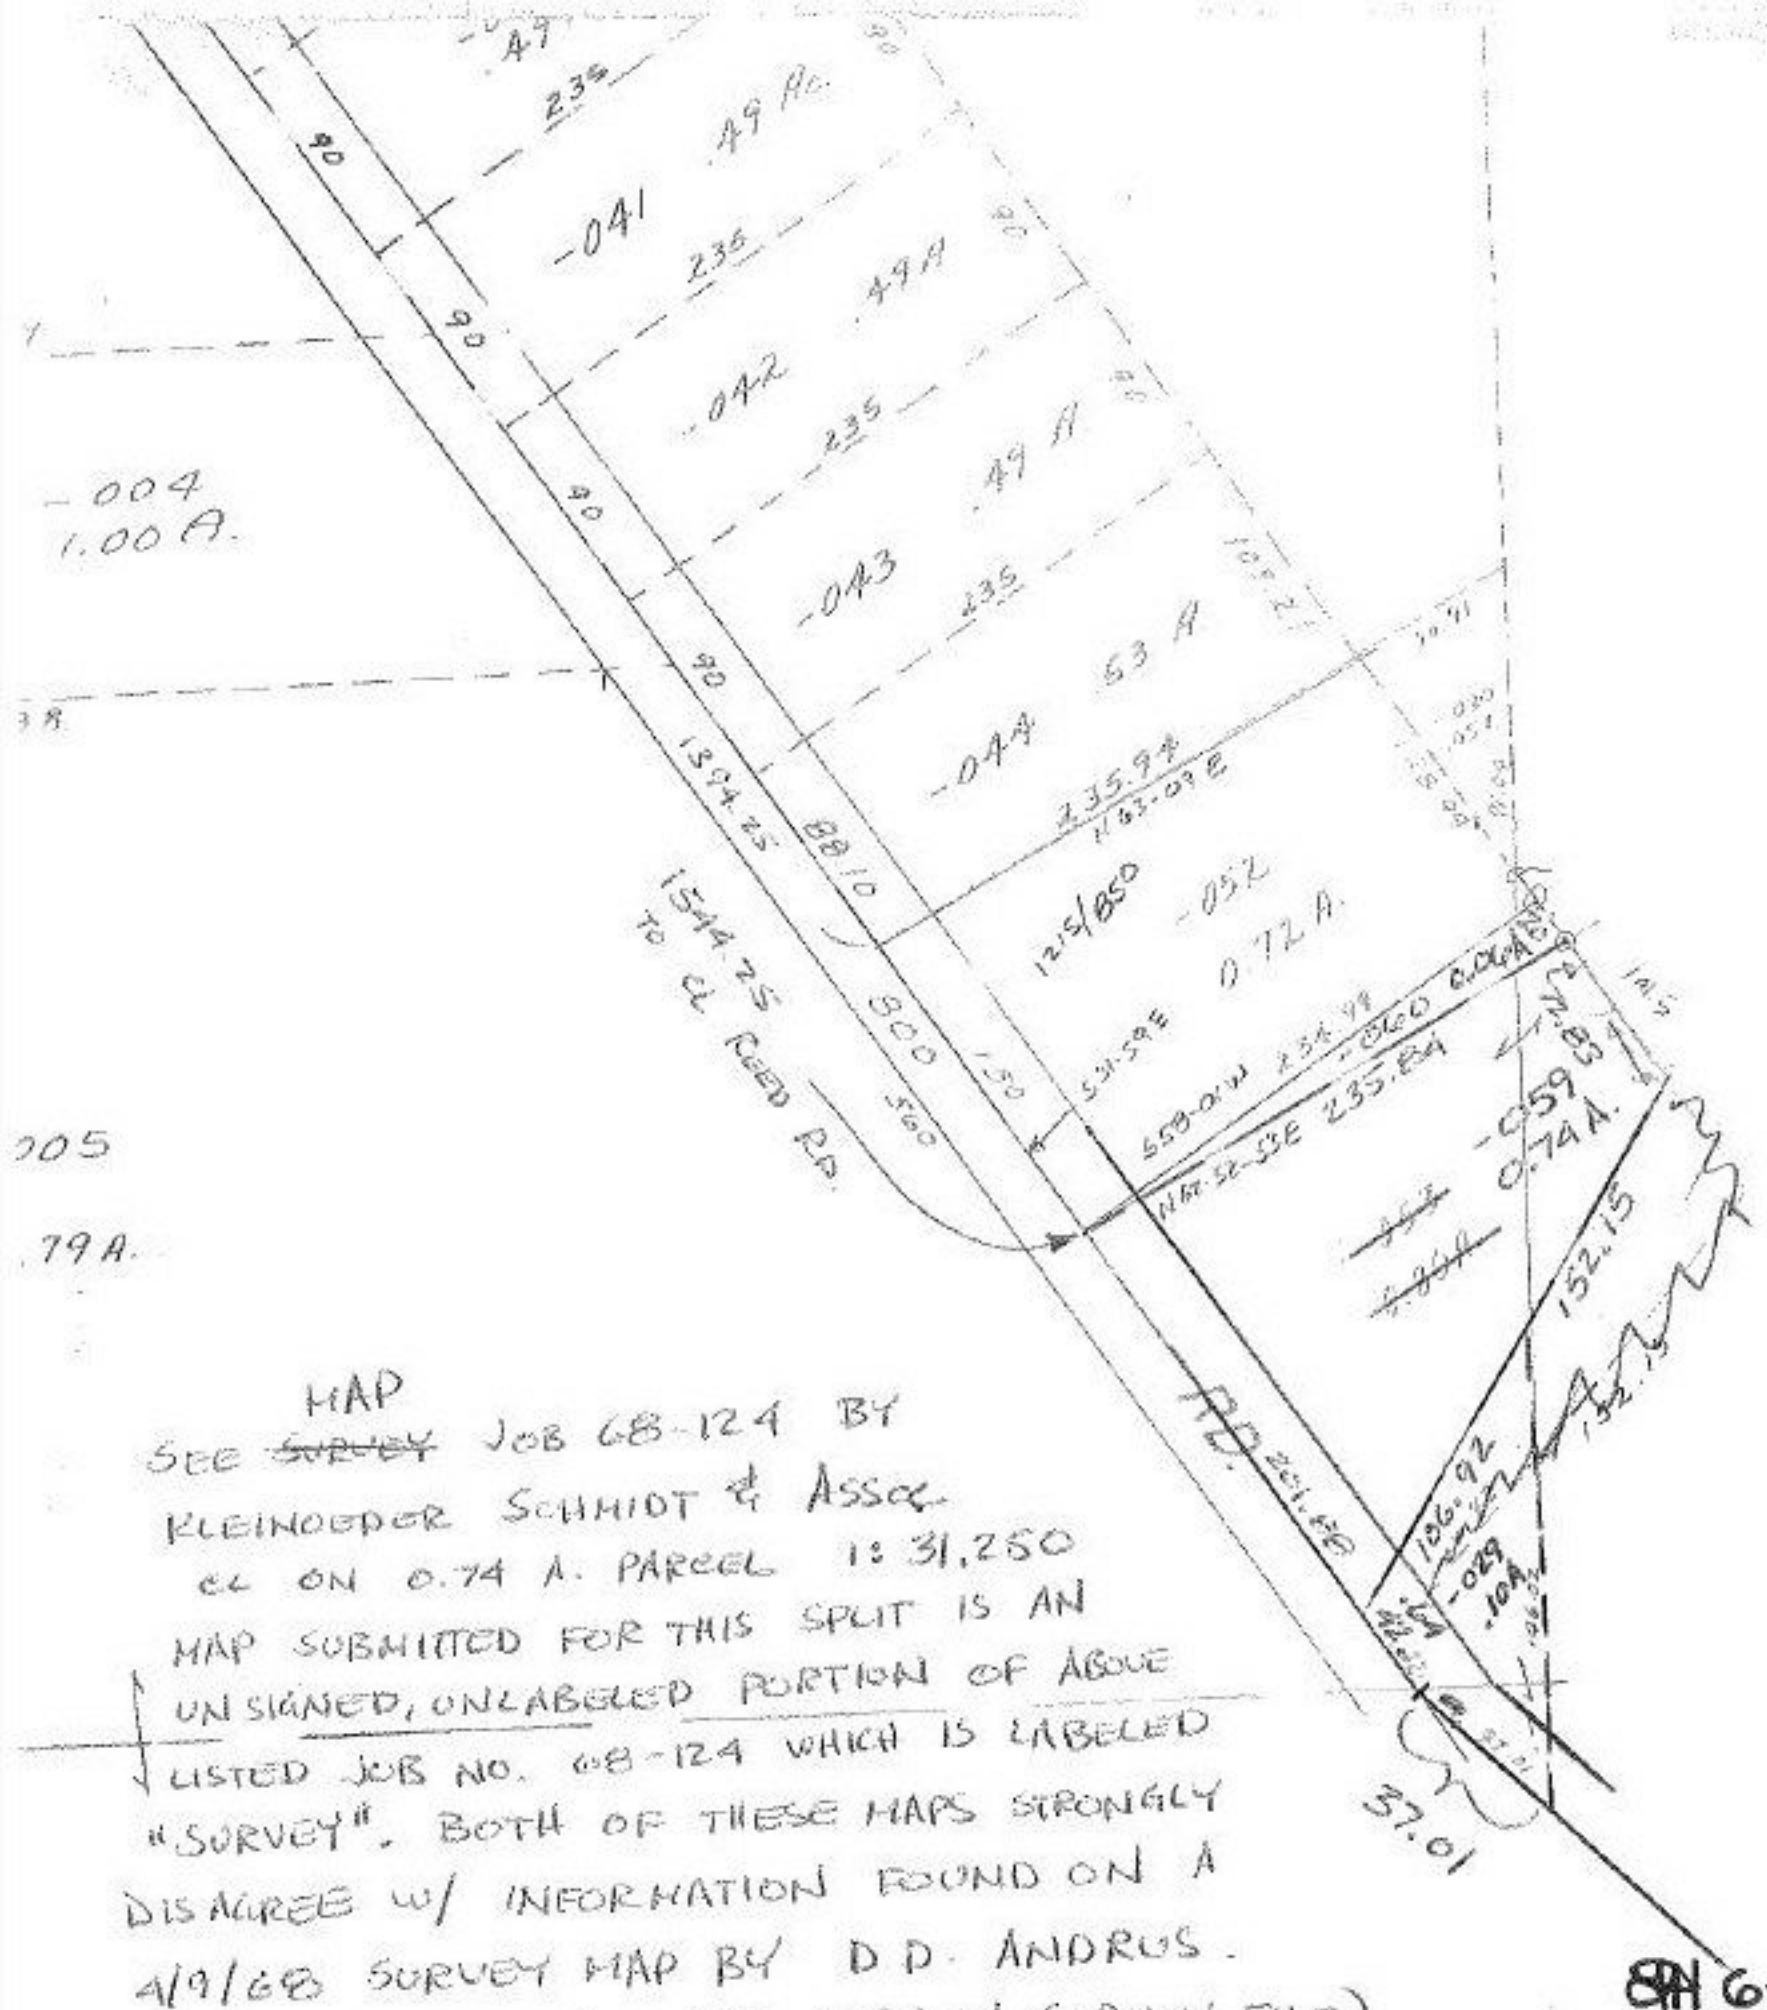

MAP
SEE ~~SURVEY~~ JOB 68-124 BY
KLEINDEDER SCHMIDT & ASSOC.
CL ON 0.74 A. PARCEL 1:31,250
MAP SUBMITTED FOR THIS SPLIT IS AN
UNSIGNED, UNLABELED PORTION OF ABOVE
LISTED JOB NO. 68-124 WHICH IS LABELED
"SURVEY". BOTH OF THESE MAPS STRONGLY
DISAGREE W/ INFORMATION FOUND ON A
4/9/68 SURVEY MAP BY D D ANDRUS.
(JOB NO. 68124 - SEE COPY IN SURVEY FILE)

DEEDS FOR ALL PARCELS ON THIS MAP &
SURROUNDING PARCELS SHOULD BE READ
TO PROPERLY SHOW THIS AREA. NOTE-
MOST DIMENSIONS DO NOT SCALE AT
THIS TIME.

BM 6-8-87
#17156

APPROVED
TRAIN CO.
MAP DEPT.
DATE 12-17-86
PAGE 7-00-012-A
BY T. McNair
VOID
AFTER