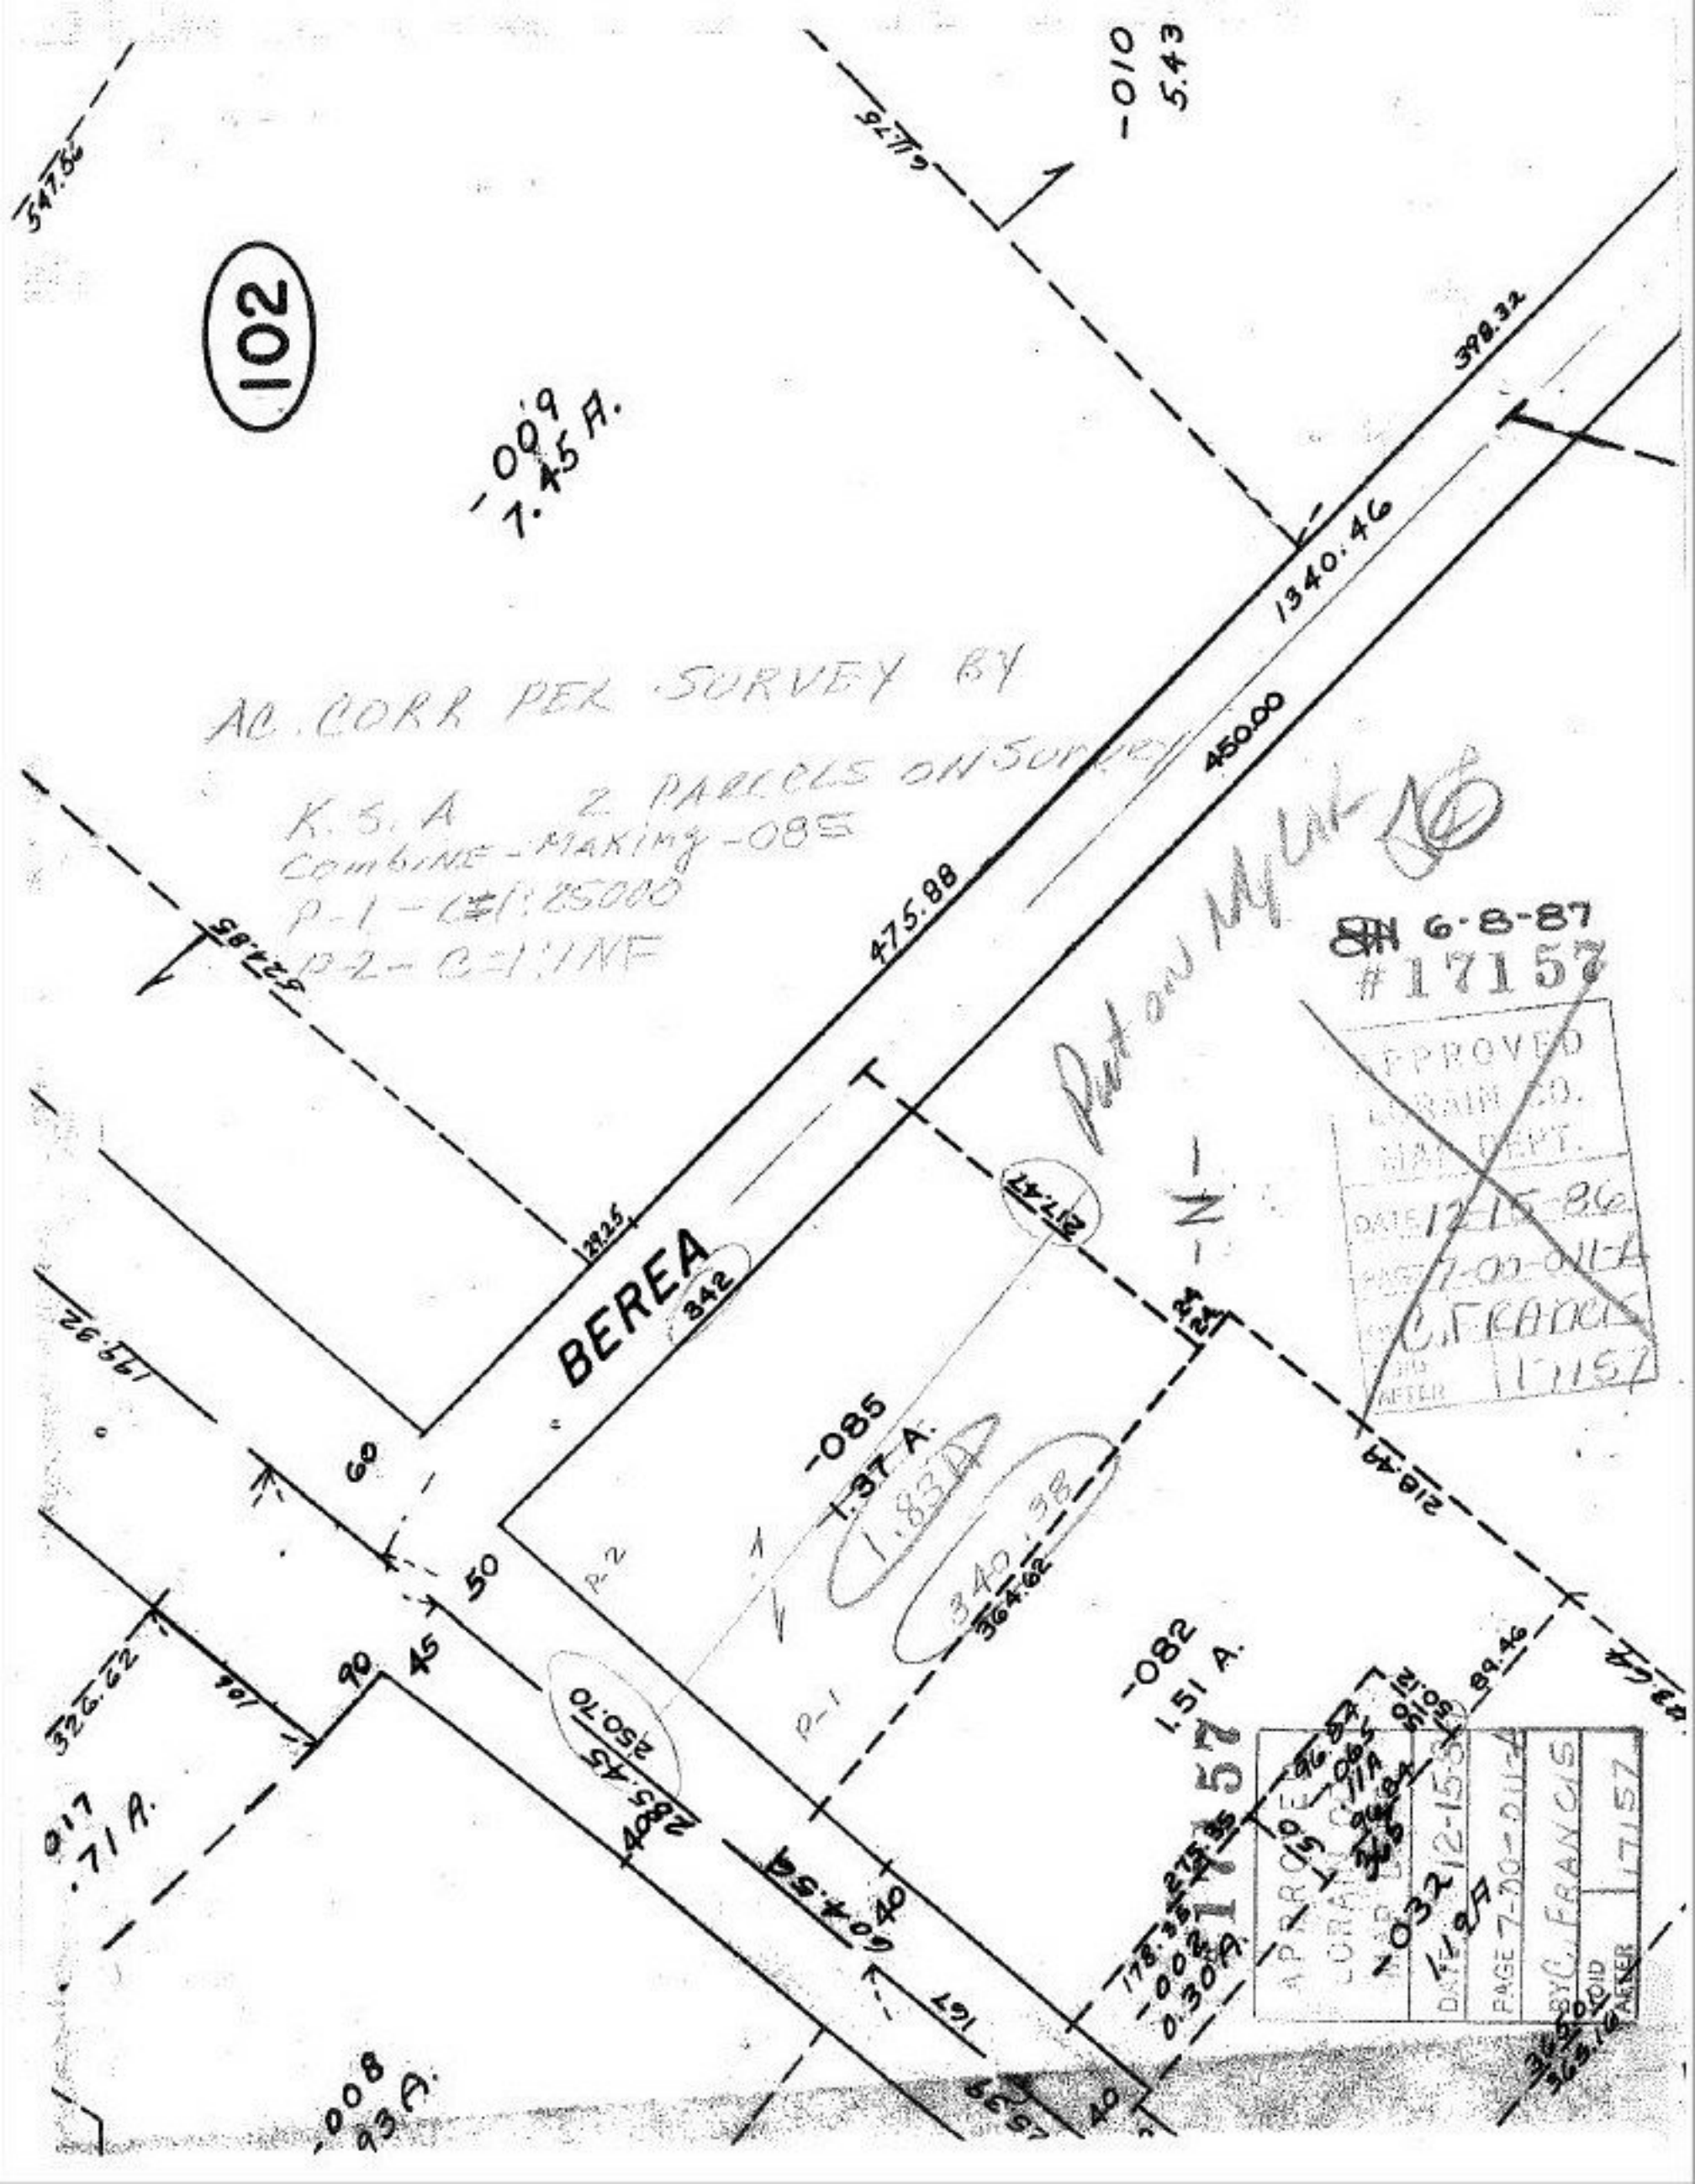

102
-009
7.45 A.
-010
5.43
547.86
611.75
398.32
1340.46
450.00
475.88
AC. CORR PER SURVEY BY
K.S.A 2 PARCELS ON SURVEY
Combine - Making -085
P-1 - C=1:25000
P-2 - C=1:INF
Put on Mylar
6-8-87
#17157
APPROVED
LORAIN CO.
MAP DEPT.
DATE 12-15-86
PAGE 7-00-011-A
BY C. FRANCIS
VOID AFTER 17157
BEREA
342
-085
1.37 A.
1.83 A
340.38
364.62
-082
1.51 A.
-032
1.19 A
-002
0.30 A.
17157
APPROVED
LORAIN CO.
MAP DEPT.
DATE 12-15-86
PAGE 7-00-011-A
BY C. FRANCIS
VOID AFTER 17157
-008
.93 A.
-017
.71 A.
326.62
199.92
524.85
29.25
217.47
218.49
89.46
60
50
45
90
P-1
P-2
250.70
285.45
604.54
167