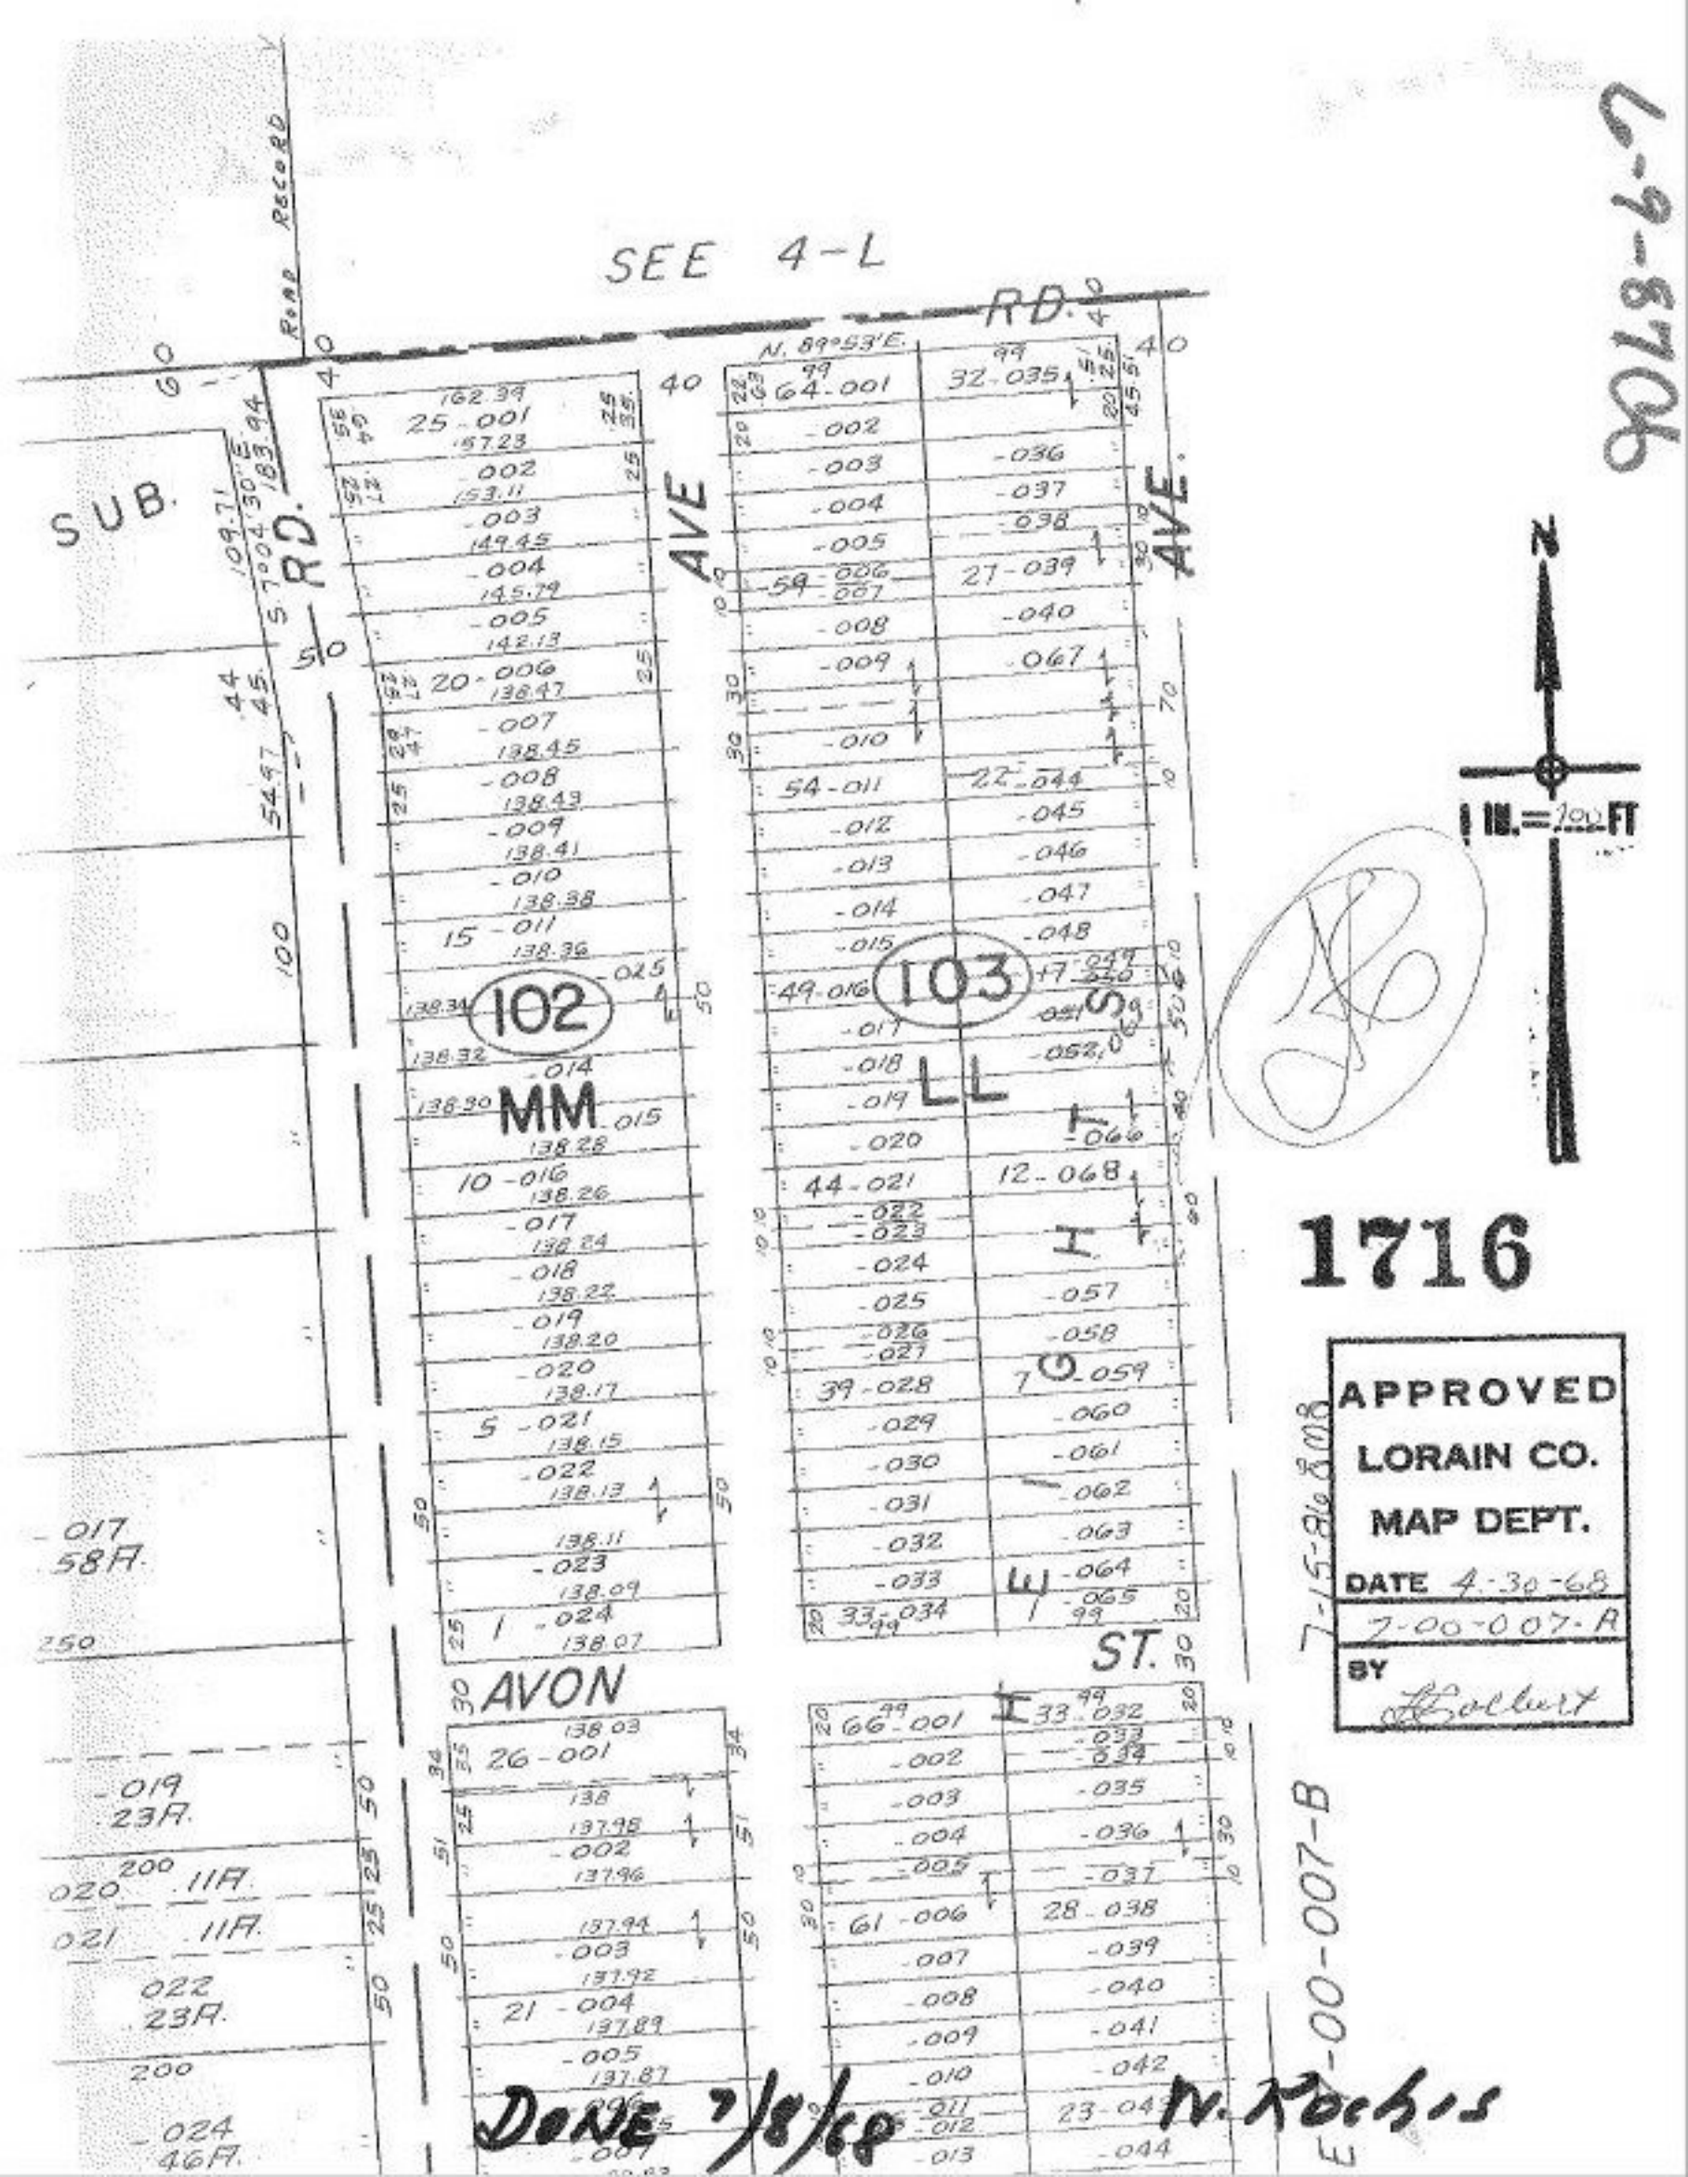
SEE 4-L
ROAD RECORD
RD.
SUB.
RD.
AVE
AVE.
102
MM
103
LL
AVON
ST.
N. 89°53'E.
1 IN.=100 FT
N
1716
APPROVED
LORAIN CO.
MAP DEPT.
DATE 4-30-68
7-00-007-A
BY
7-15-86 BMB
7-00-007-B
DONE 7/8/68
N. Rochis

6-9-8706