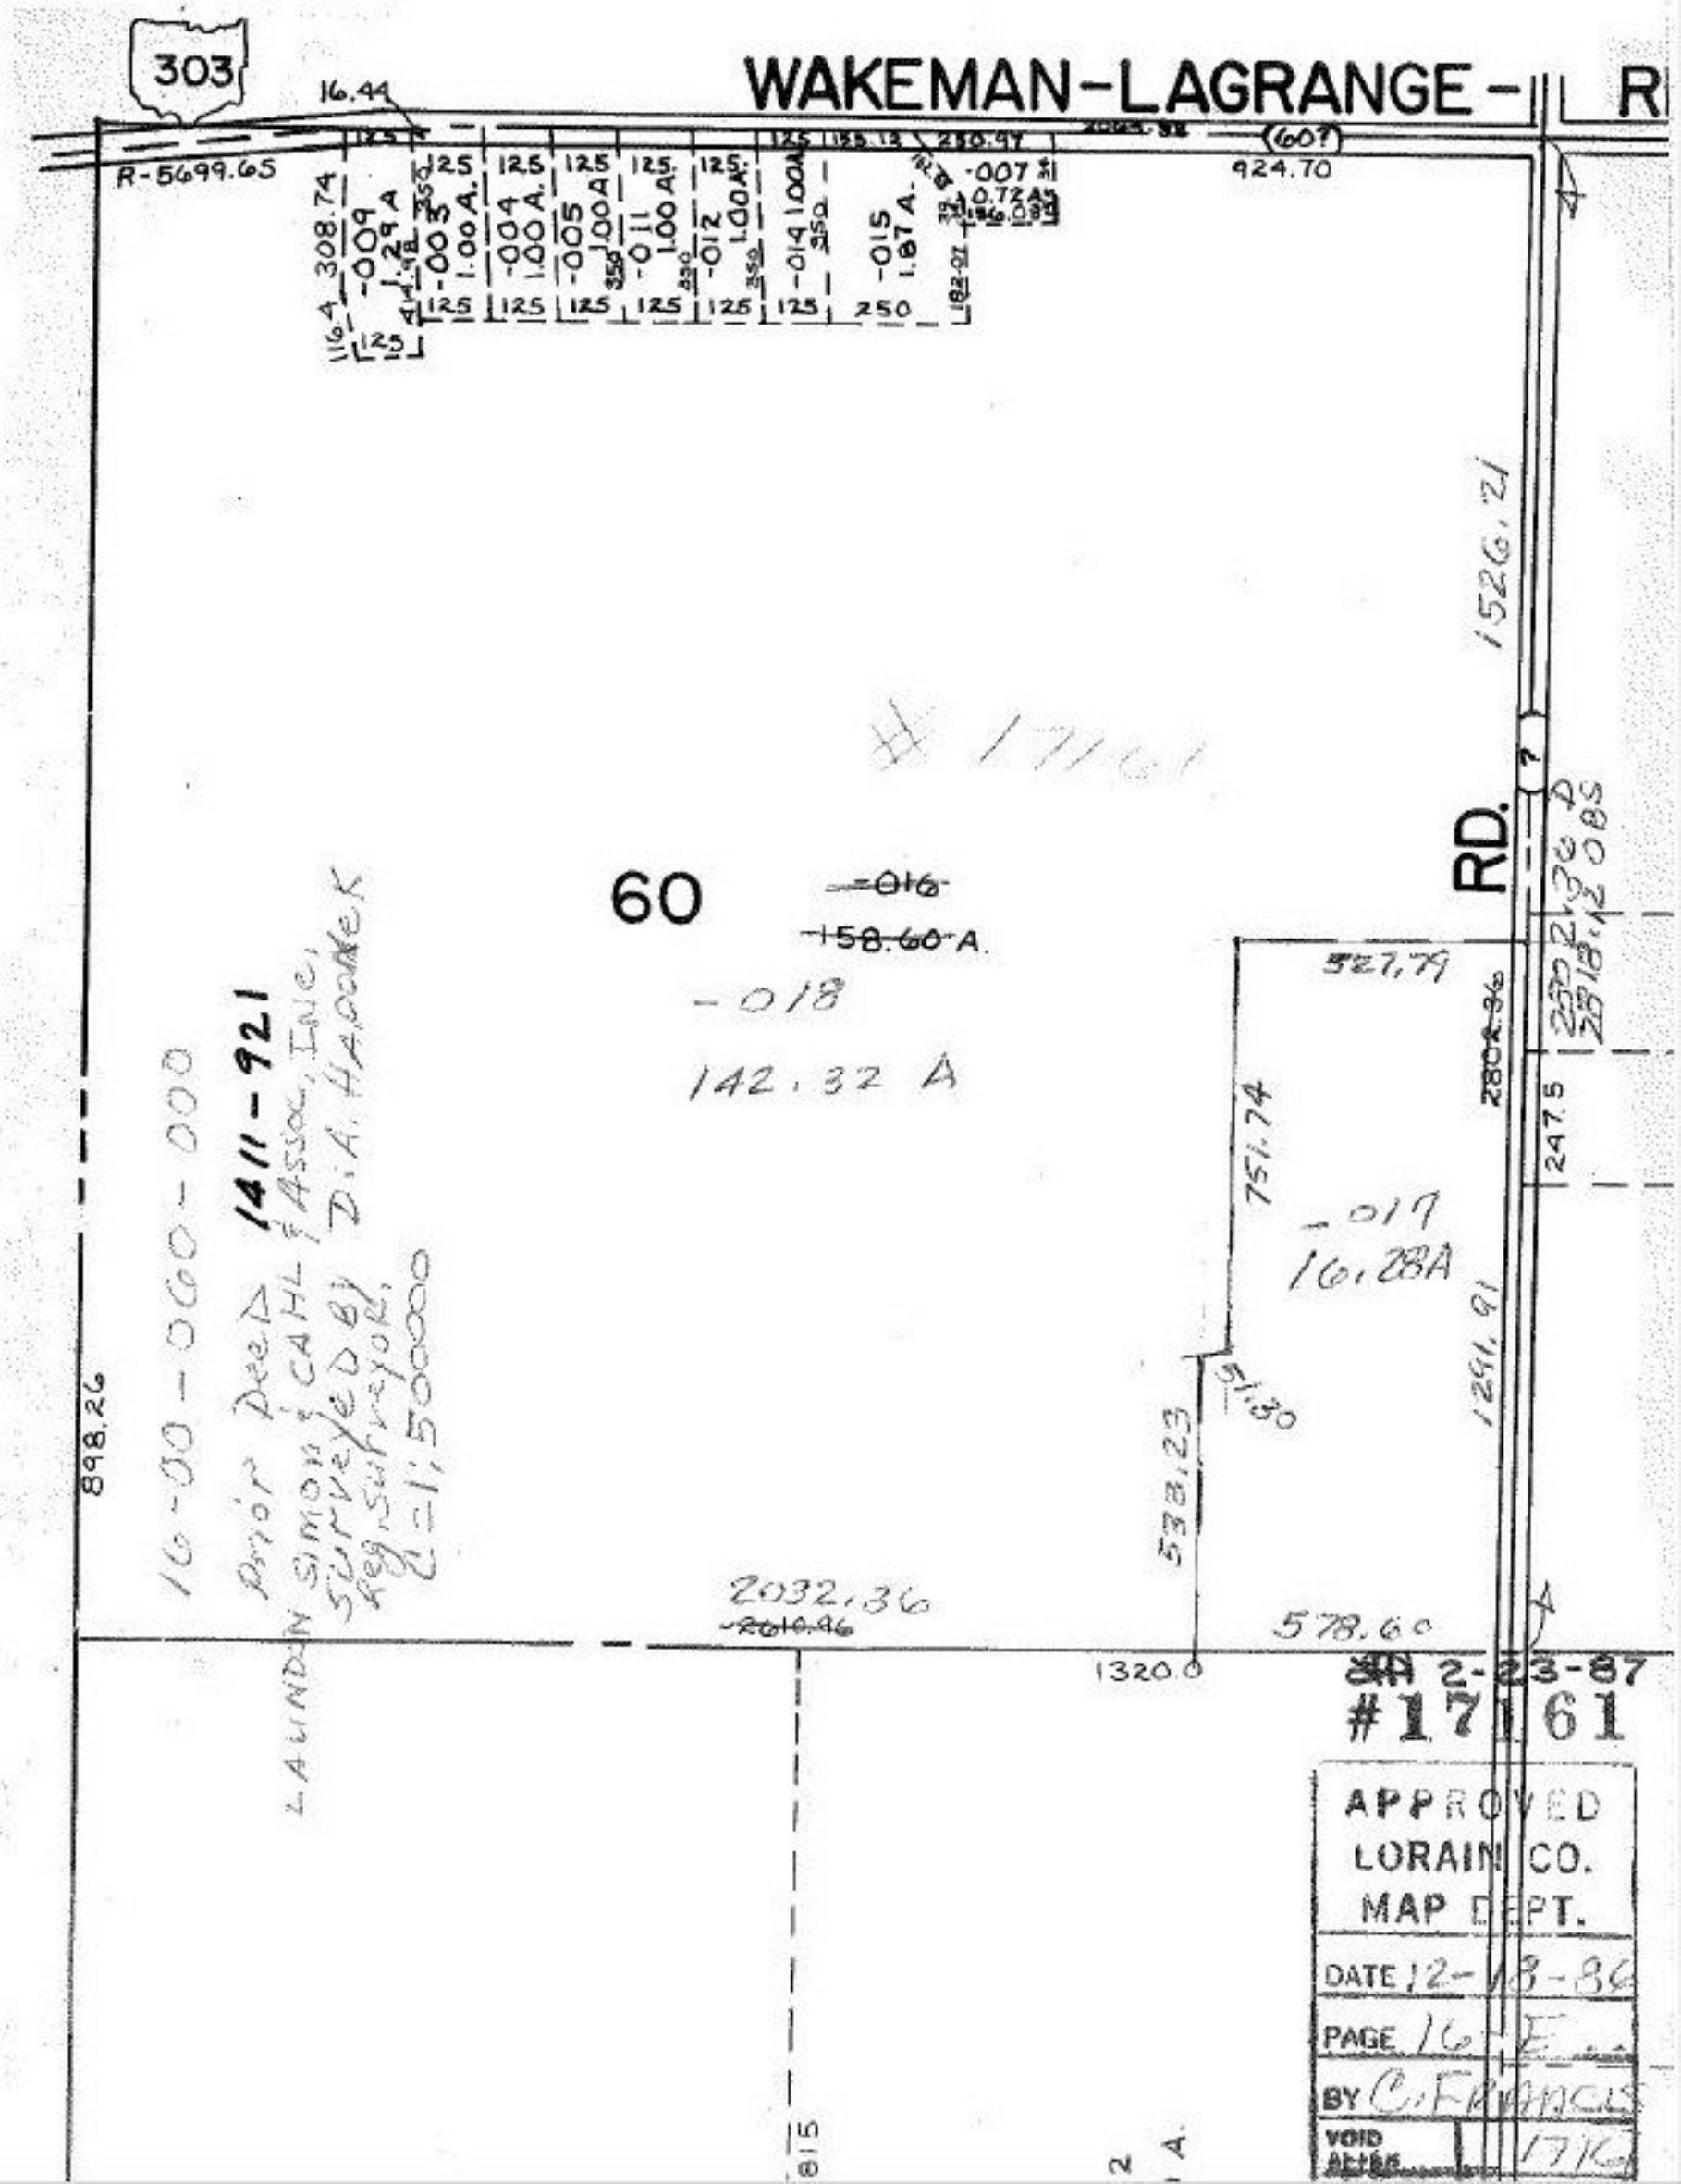

303
16.44
WAKEMAN-LAGRANGE-
R
R-5699.65
924.70
60
-016
158.60 A.
-018
142.32 A
-017
16.28A
RD.
1526.21
527.79
751.74
1291.91
538.23
2032.36
578.60
1320.0
898.26
16-00-060-000
Prior Deed 1411-921
LAUNDON SIMON & CAHL & ASSOC, INC.
Surveyed By D.A. HAGOOKEK
Reg. Surveyor.
C=1:500000
2-23-87
#17161
APPROVED
LORAIN CO.
MAP DEPT.
DATE 12-18-86
PAGE 16-E
BY C. FRANCIS
VOID