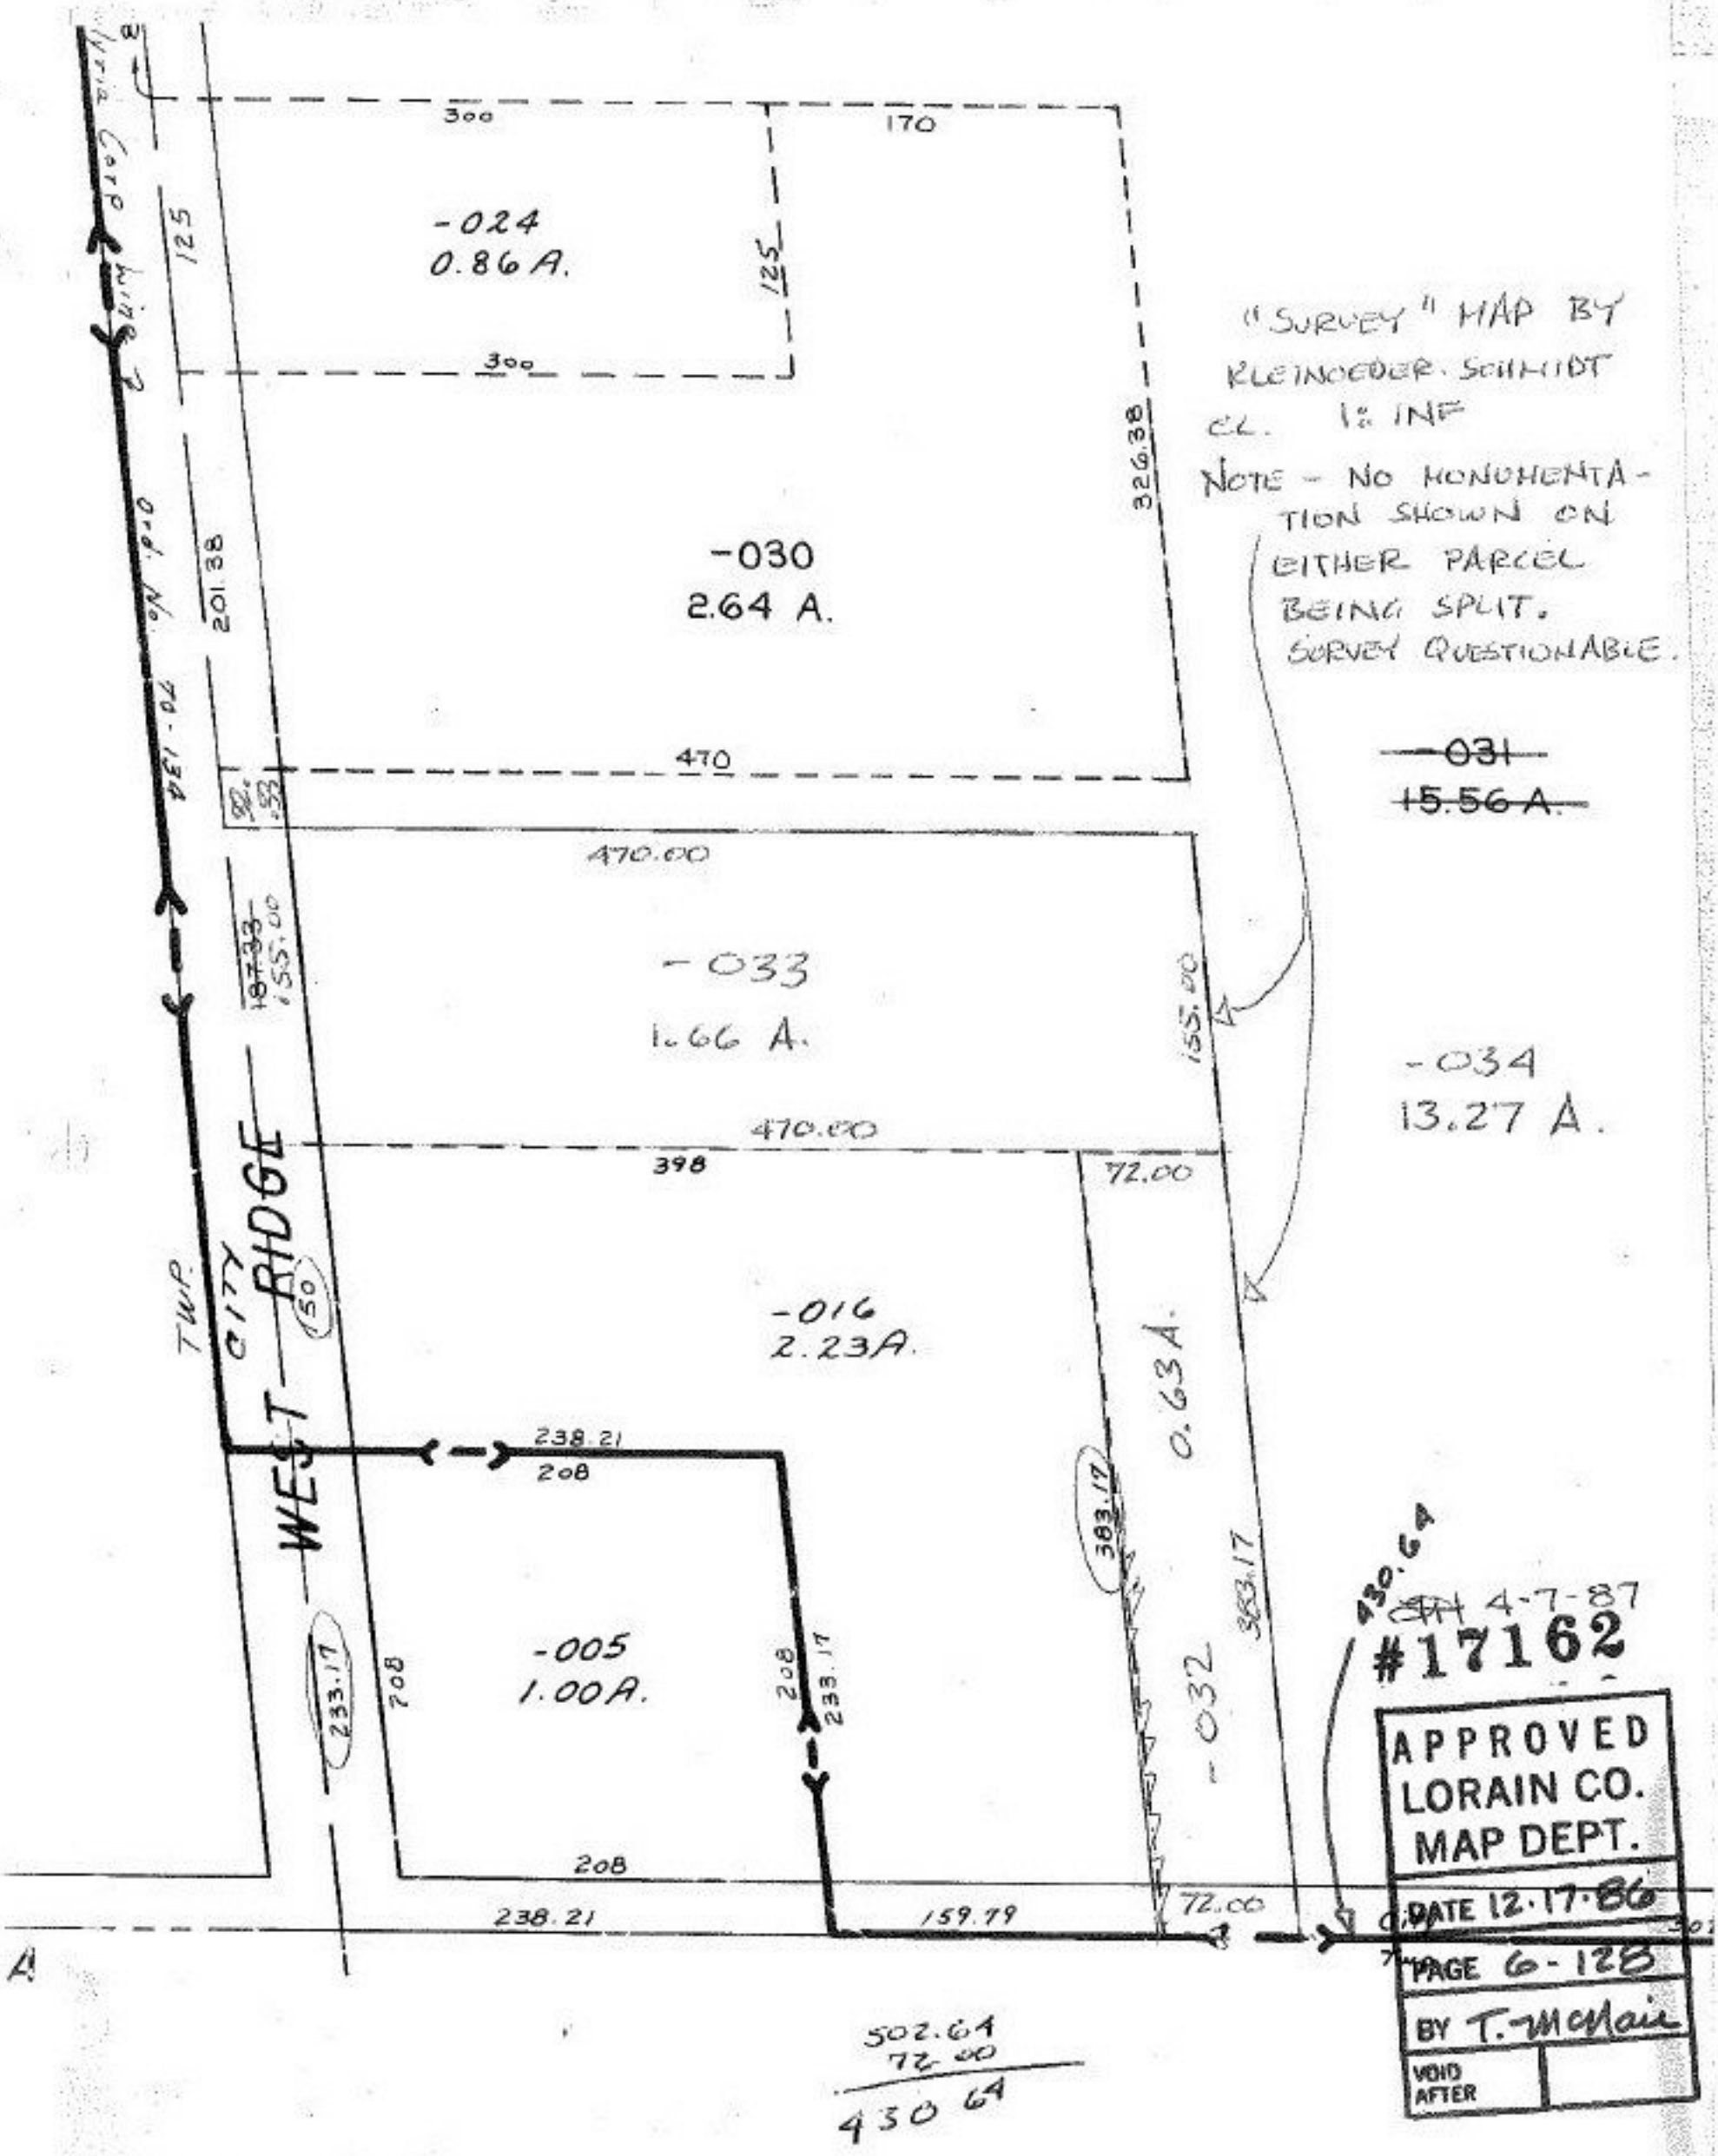

"SURVEY" MAP BY
KLEINOEDER-SCHMIDT
CL. 1: INF
NOTE - NO MONUMENTATION SHOWN ON EITHER PARCEL BEING SPLIT. SURVEY QUESTIONABLE.
~~-031~~
~~15.56 A.~~
-024
0.86 A.
-030
2.64 A.
-033
1.66 A.
-034
13.27 A.
-016
2.23A.
-005
1.00A.
-032
0.63A.
WEST RIDGE
TWP.
CITY
300
170
125
300
326.38
201.38
470
470.00
155.00
398
72.00
238.21
208
233.17
383.17
159.79
430.64
4-7-87
#17162
APPROVED
LORAIN CO.
MAP DEPT.
DATE 12.17.86
PAGE 6-128
BY T. McNair
VOID AFTER
502.64
72.00
430.64