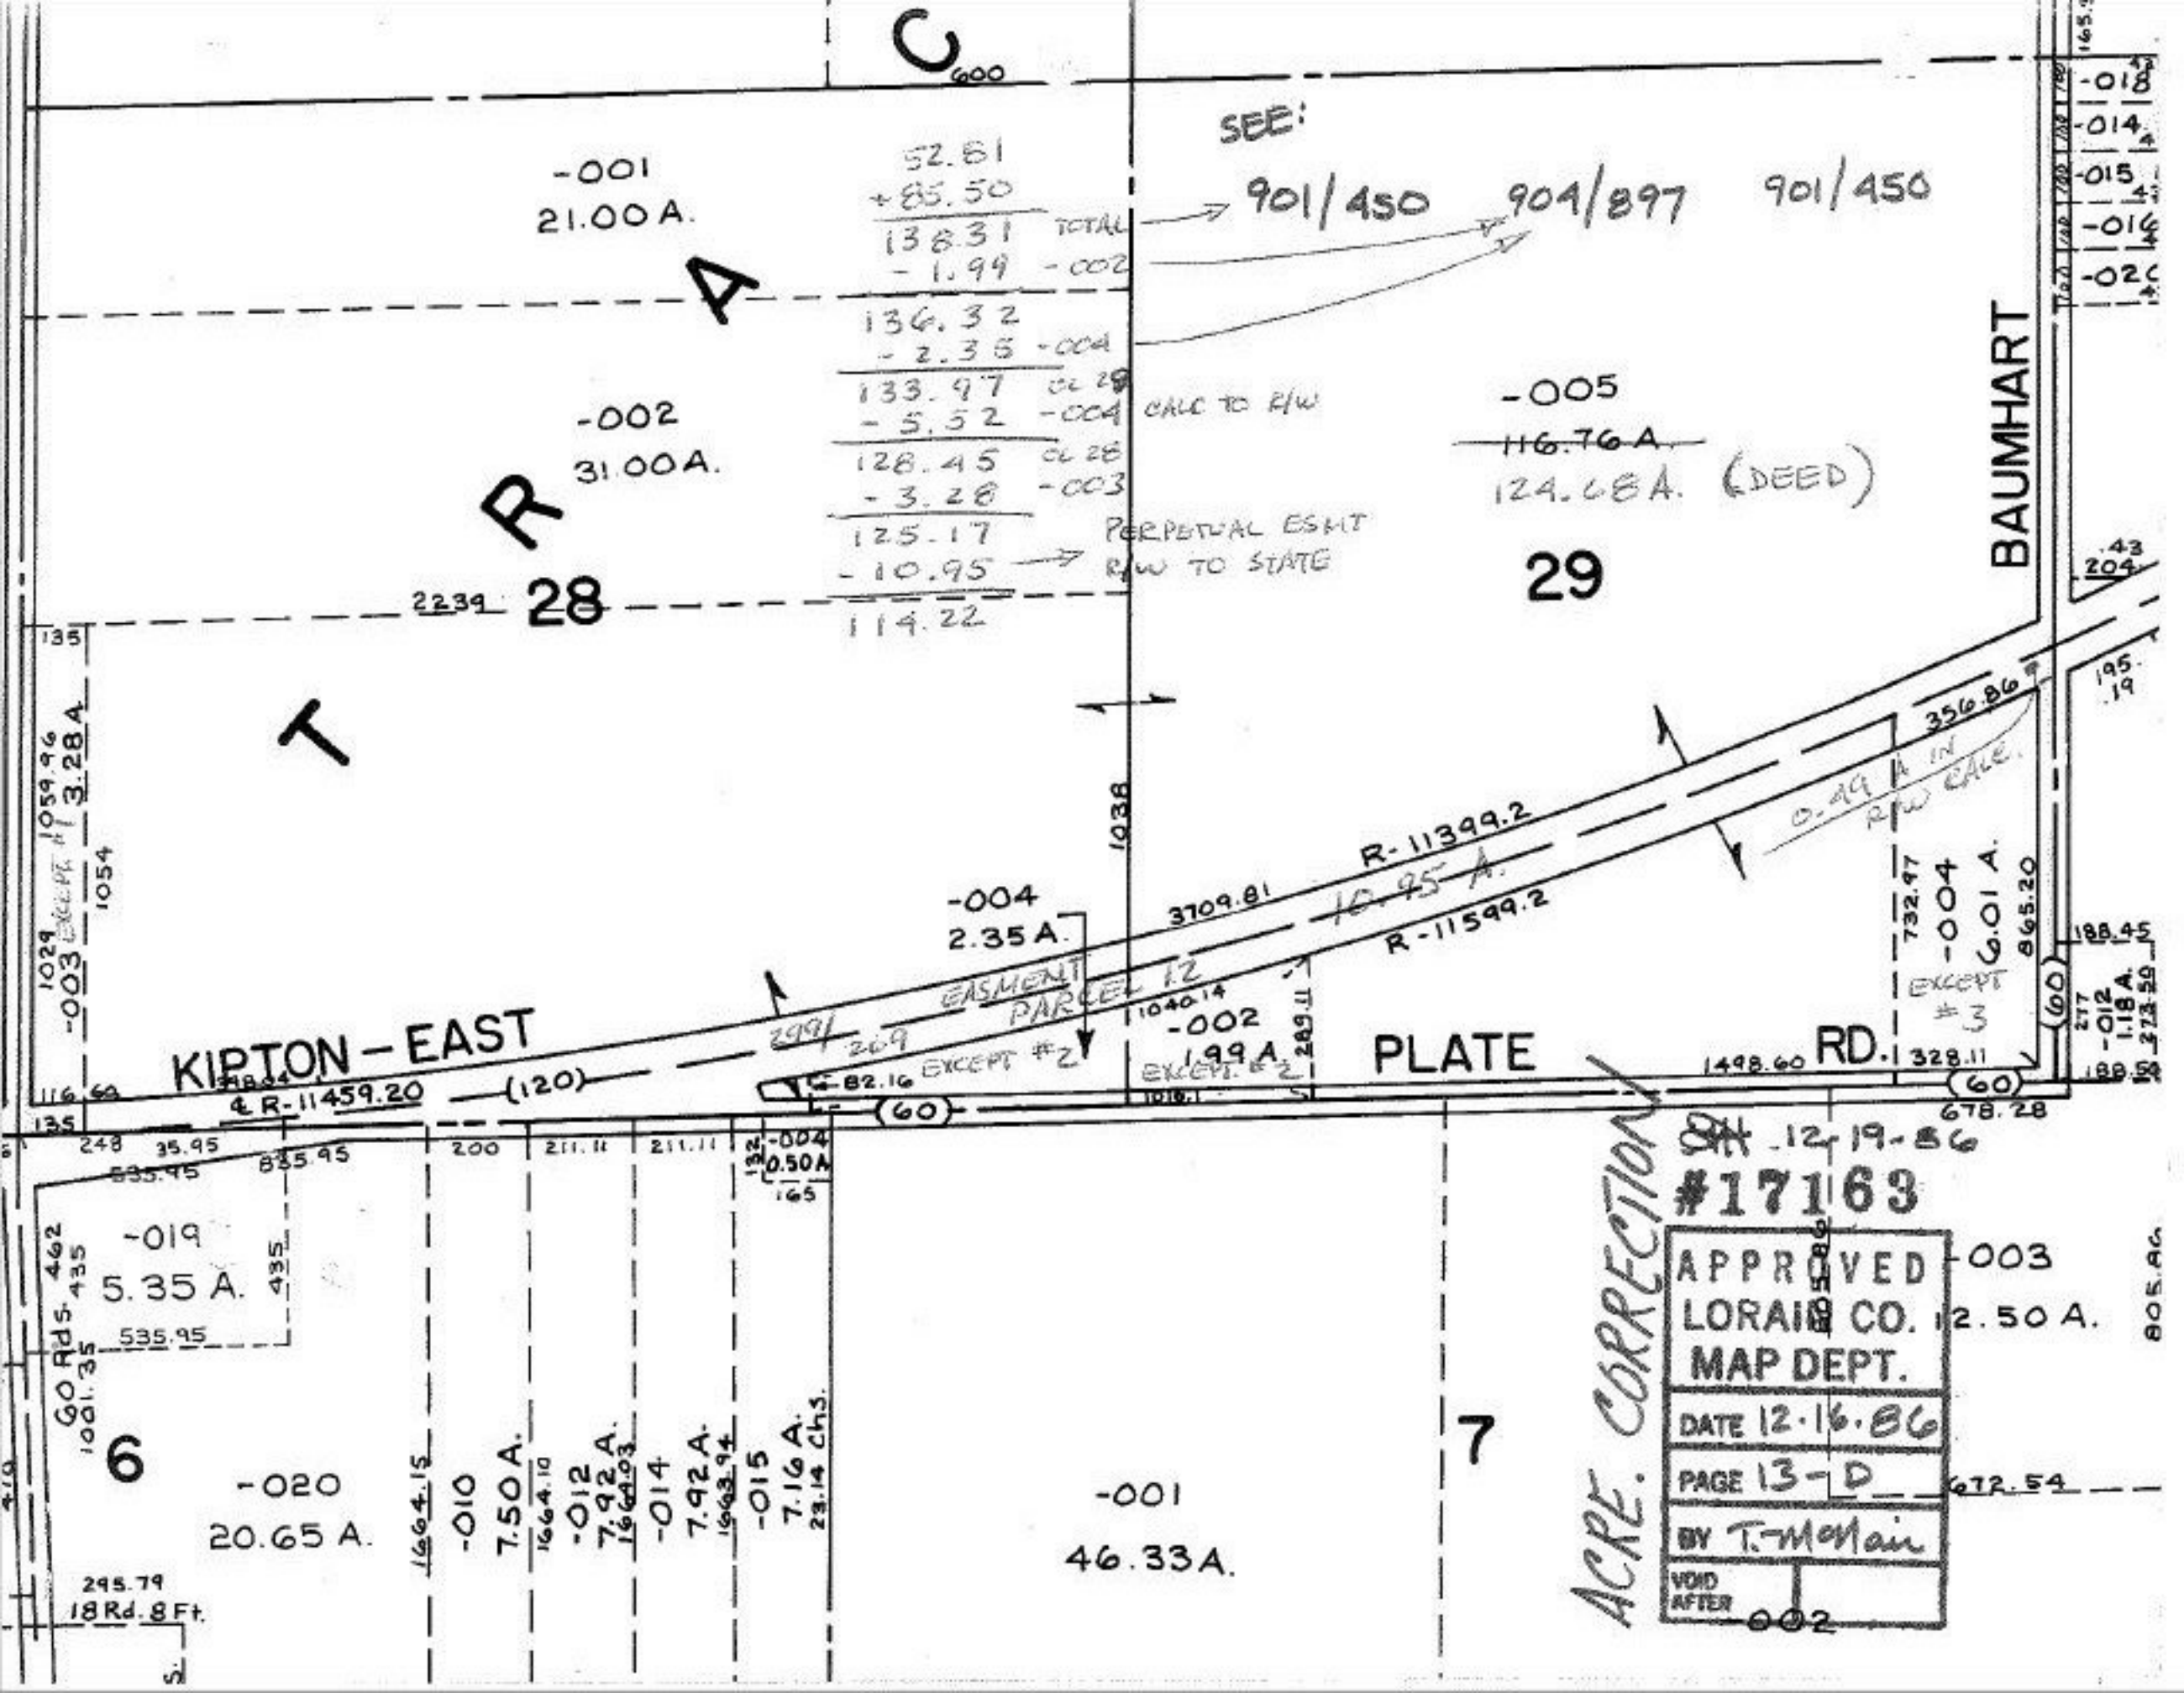

C
600
SEE:
901/450
904/897
901/450
-001
21.00 A.
52.81
+85.50
138.31 TOTAL
-1.99 -002
136.32
-2.35 -004
133.97 OL 28
-5.52 -004 CALC TO R/W
128.45 OL 28
-3.28 -003
125.17
-10.95 PERPETUAL ESMT R/W TO STATE
114.22
-002
31.00 A.
-005
~~116.76 A.~~
124.68 A. (DEED)
29
BAUMHART
28
2239
T
R
A
135
1059.96
3.28 A
-003 EXCEPT #1
1054
1029
1038
-004
2.35 A.
3709.81
R-11399.2
10.95 A.
R-11599.2
356.86
0.49 A IN R/W CALC.
EASMENT PARCEL 12
299/269
EXCEPT #2
1040.14
-002
1.99 A.
EXCEPT #2
289.11
KIPTON-EAST
PLATE
RD.
℄ R-11459.20
(120)
(60)
1498.60
732.97
-004
6.01 A.
865.20
EXCEPT #3
328.11
188.45
-012
1.18 A.
188.50
678.28
-018
-014
-015
-016
-020
204
195.19
116.60
135
248
35.95
535.95
835.95
200
211.11
211.11
-004
0.50 A
165
-019
5.35 A.
462
435
535.95
60 Rds.
1001.35
6
-020
20.65 A.
1664.15
-010
7.50 A.
1664.10
-012
7.92 A.
1664.03
-014
7.92 A.
1663.94
-015
7.16 A.
23.14 Chs.
295.79
18 Rd. 8 Ft.
-001
46.33 A.
7
-003
12.50 A.
805.86
672.54
-002
ACRE. CORRECTION
12-19-86
#17163
APPROVED
LORAIN CO.
MAP DEPT.
DATE 12.16.86
PAGE 13-D
BY T. McNair
VOID AFTER