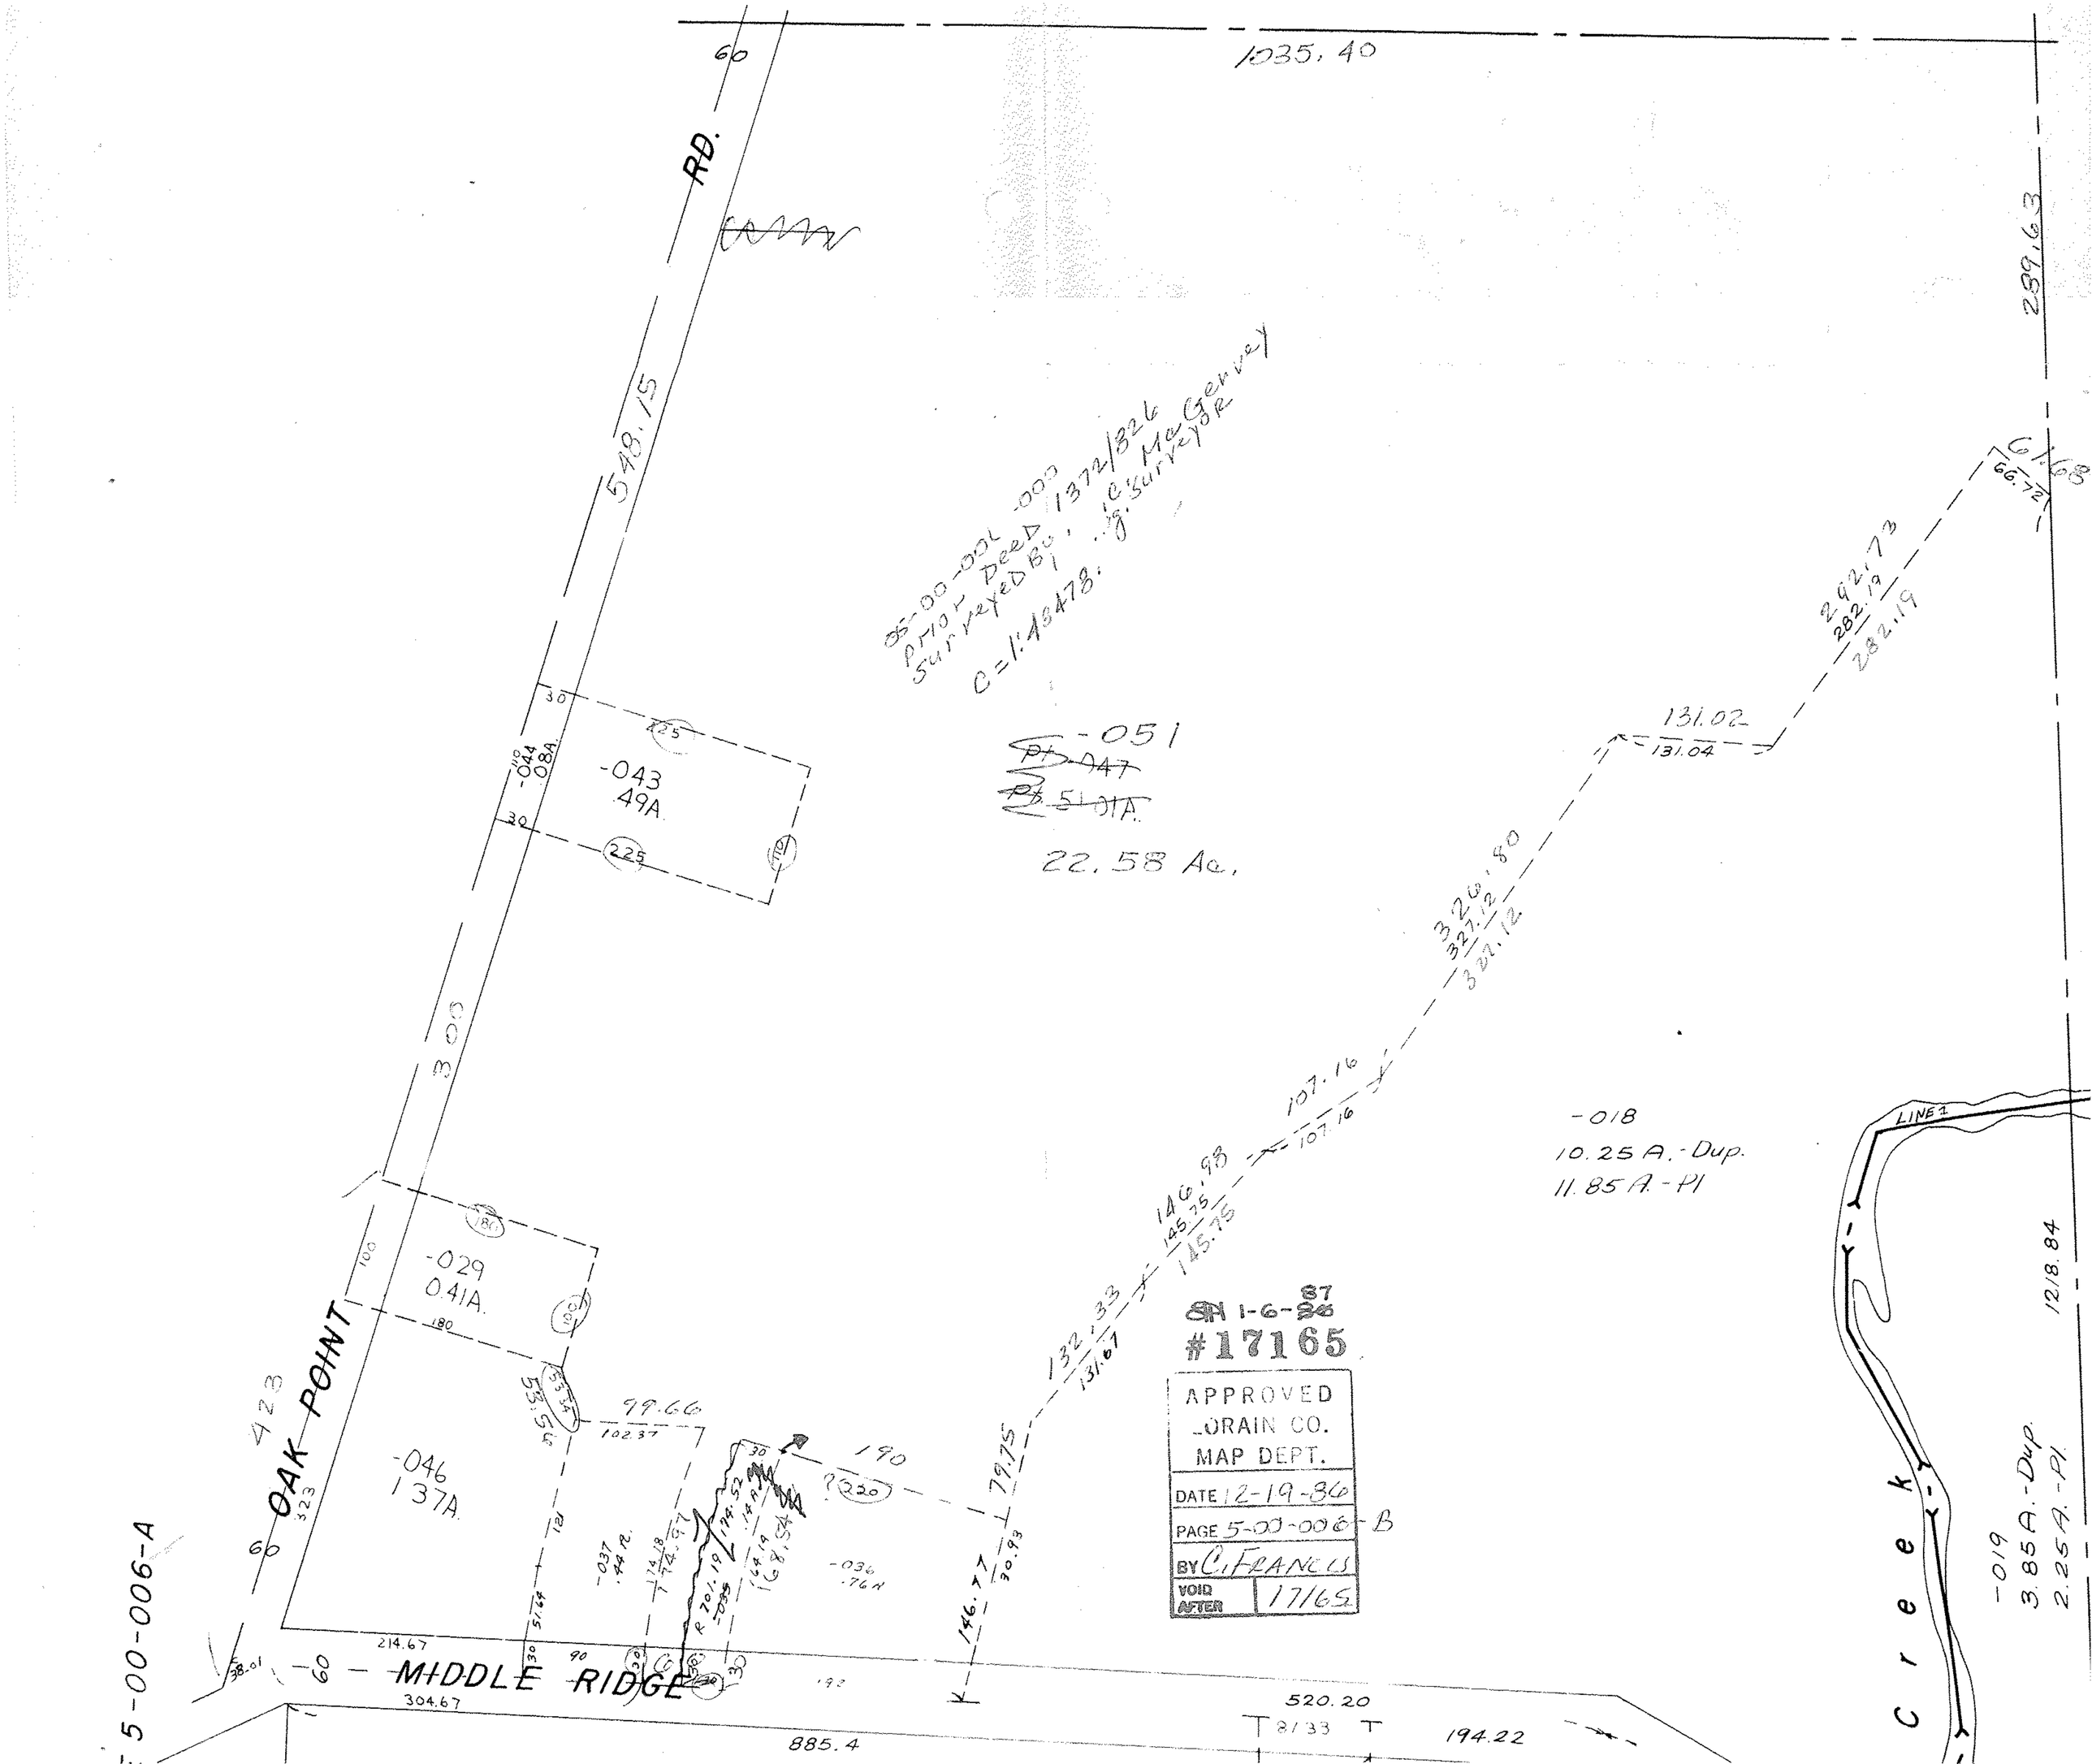

1035.40
RD.
548.15
289.63
05-00-001-000
Prior Deed 1372/826
Surveyed By: C. McGervey
Surveyor
C=1:43478.
-051
22.58 Ac.
-043
.49A
-044
.08A
-029
0.41A
-046
1.37A
-018
10.25 A.-Dup.
11.85 A.-Pl
-019
3.85 A.-Dup.
2.25 A.-Pl
LINE 1
Creek
OAK POINT
MIDDLE RIDGE
5-00-006-A
520.20
885.4
194.22
1218.84
#17165
APPROVED
LORAIN CO.
MAP DEPT.
DATE 12-19-86
PAGE 5-00-006-B
BY C. FRANCIS
VOID AFTER 17165