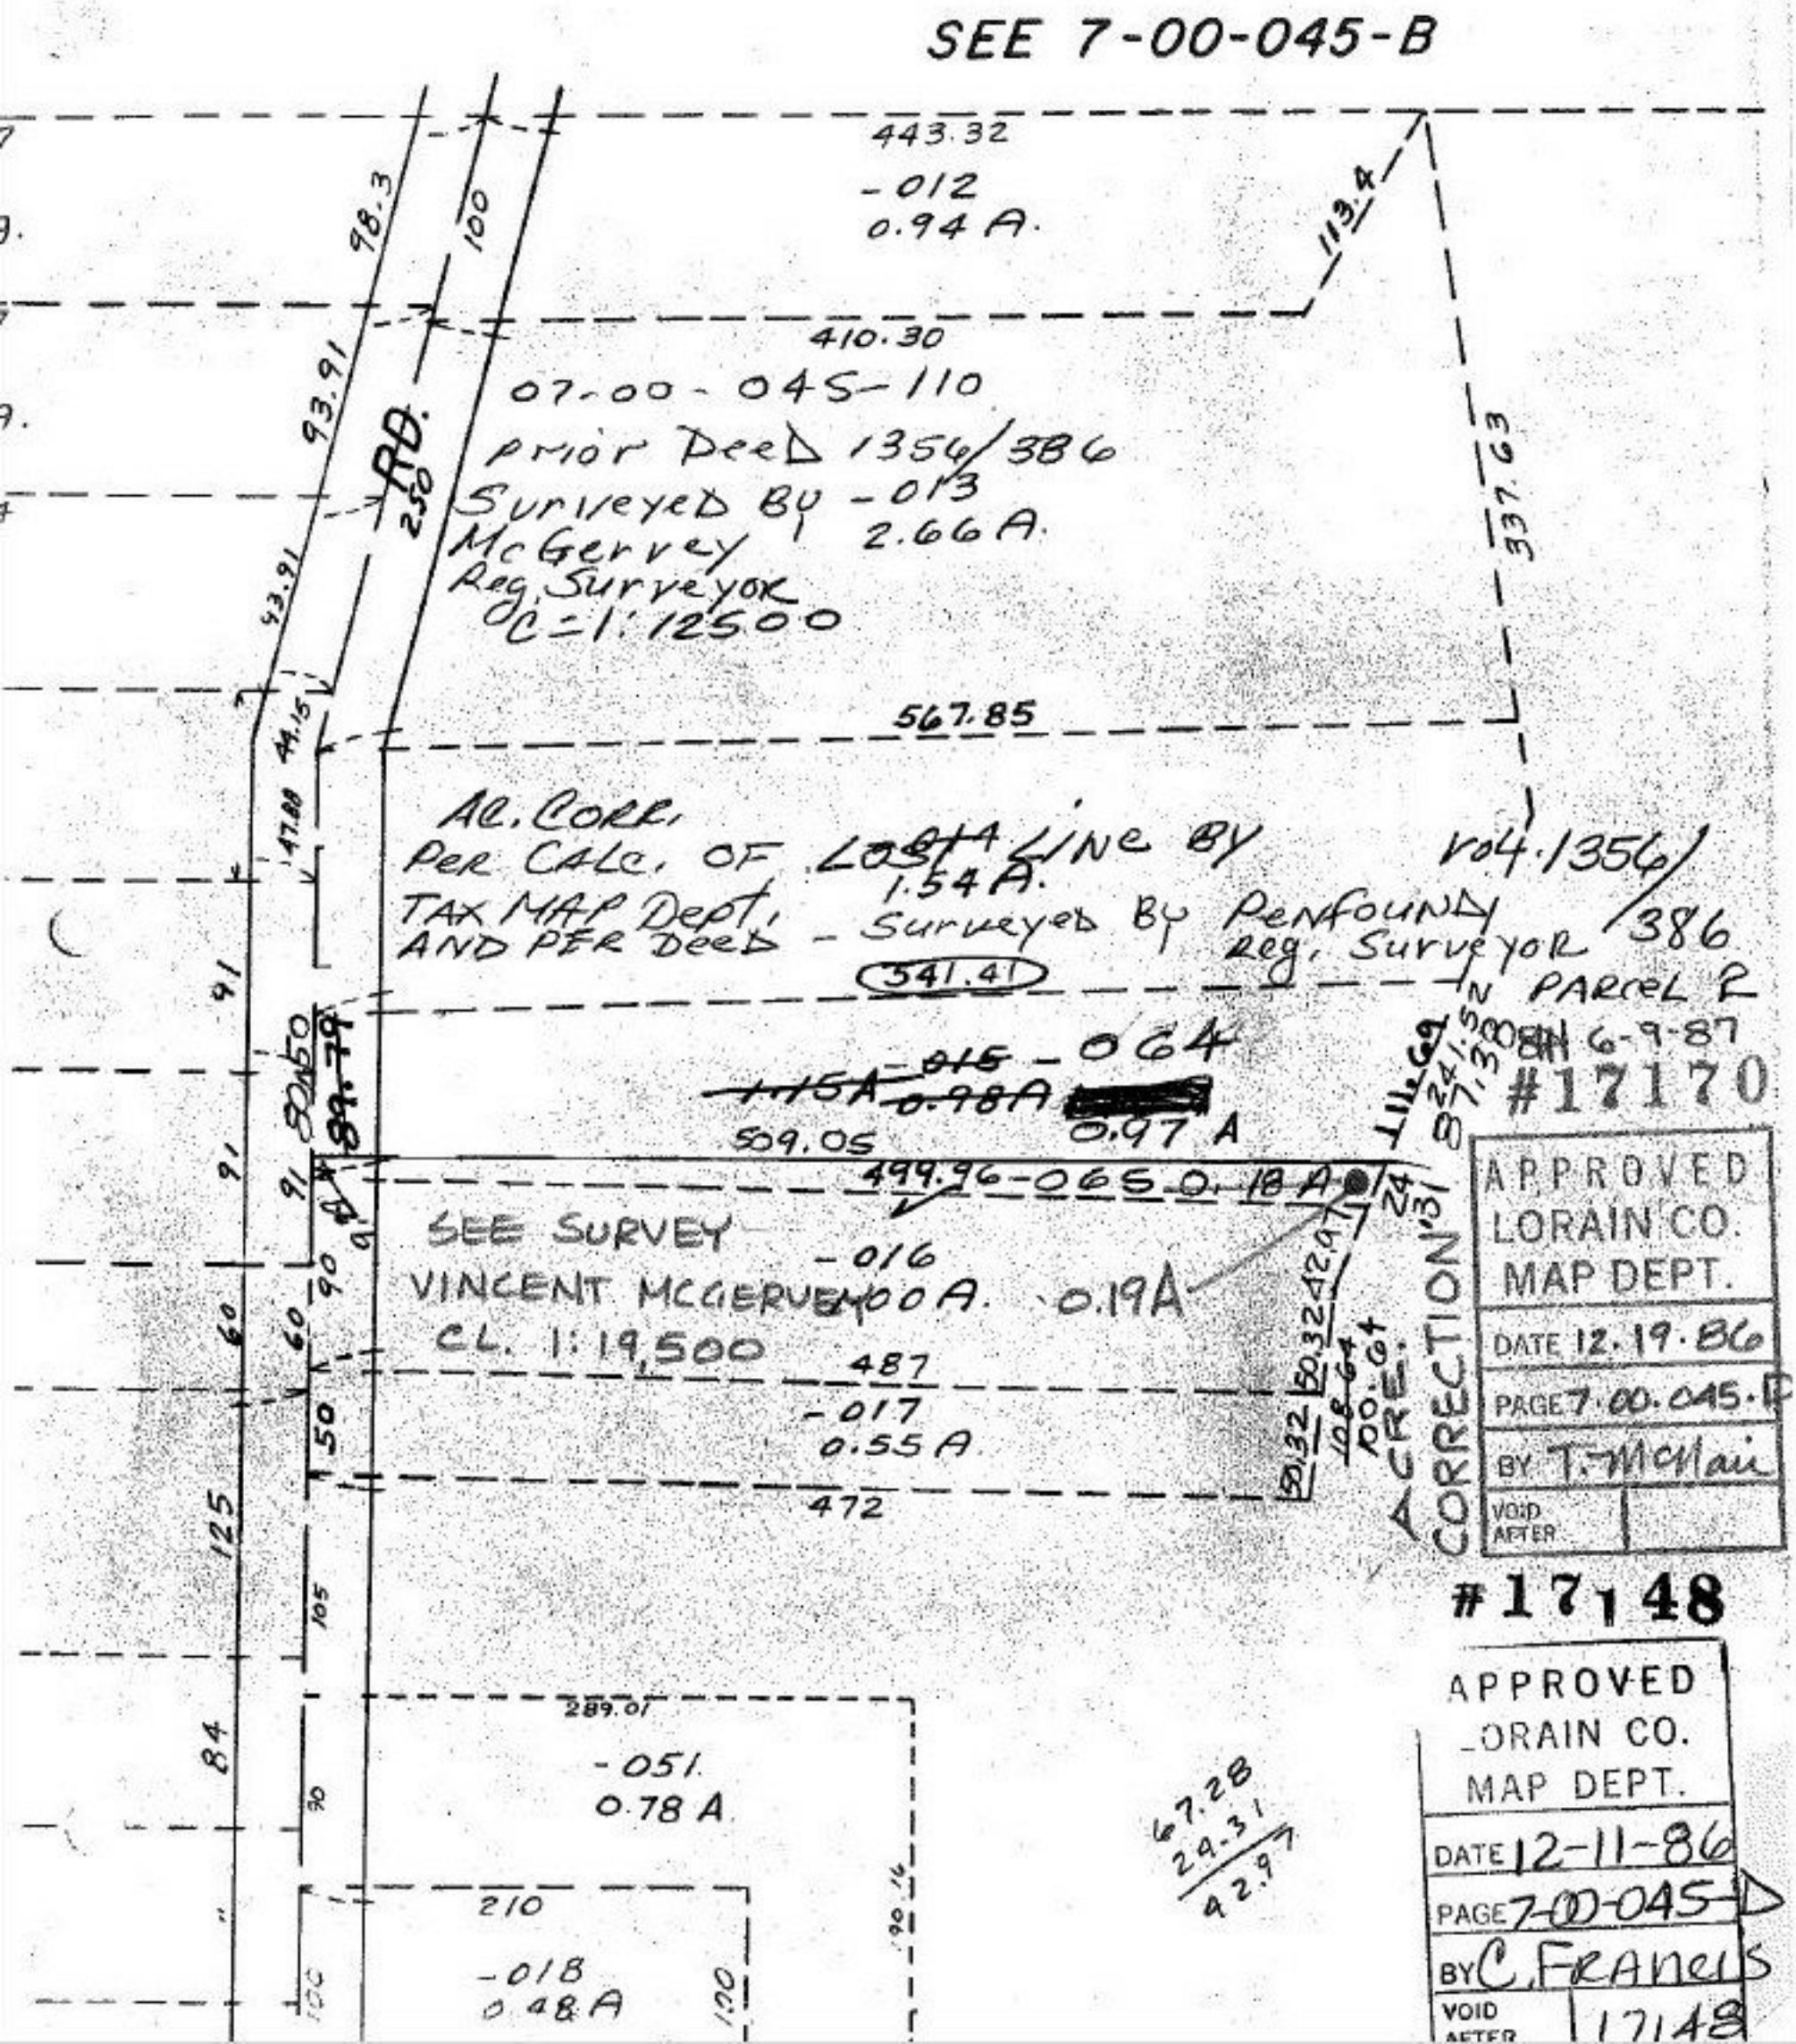
SEE 7-00-045-B
443.32
-012
0.94 A.
98.3
100
113.4
410.30
07-00-045-110
prior Deed 1356/386
Surveyed By -013
McGervey 2.66 A.
Reg. Surveyor
C=1:12500
93.91
RD.
250
337.63
567.85
AC. CORR.
PER CALC. OF LOST LINE BY
TAX MAP Dept.
AND PER Deed - Surveyed By Penfound
Reg. Surveyor
1.54 A.
Vol. 1356/386
541.41
PARCEL 2
6-9-87
#17170
-015 -064
1.15A 0.98A
0.97 A
509.05
499.96 -065 0.18 A
SEE SURVEY
VINCENT MCGERVEY
CL. 1:19,500
-016
0.19A
487
-017
0.55 A
472
ACRE CORRECTION
APPROVED
LORAIN CO.
MAP DEPT.
DATE 12.19.86
PAGE 7.00.045-B
BY T. McNair
VOID AFTER
#17148
289.01
-051
0.78 A
210
-018
0.48 A
67.28
24.31
42.97
APPROVED
LORAIN CO.
MAP DEPT.
DATE 12-11-86
PAGE 7-00-045-D
BY C. Francis
VOID AFTER 17148