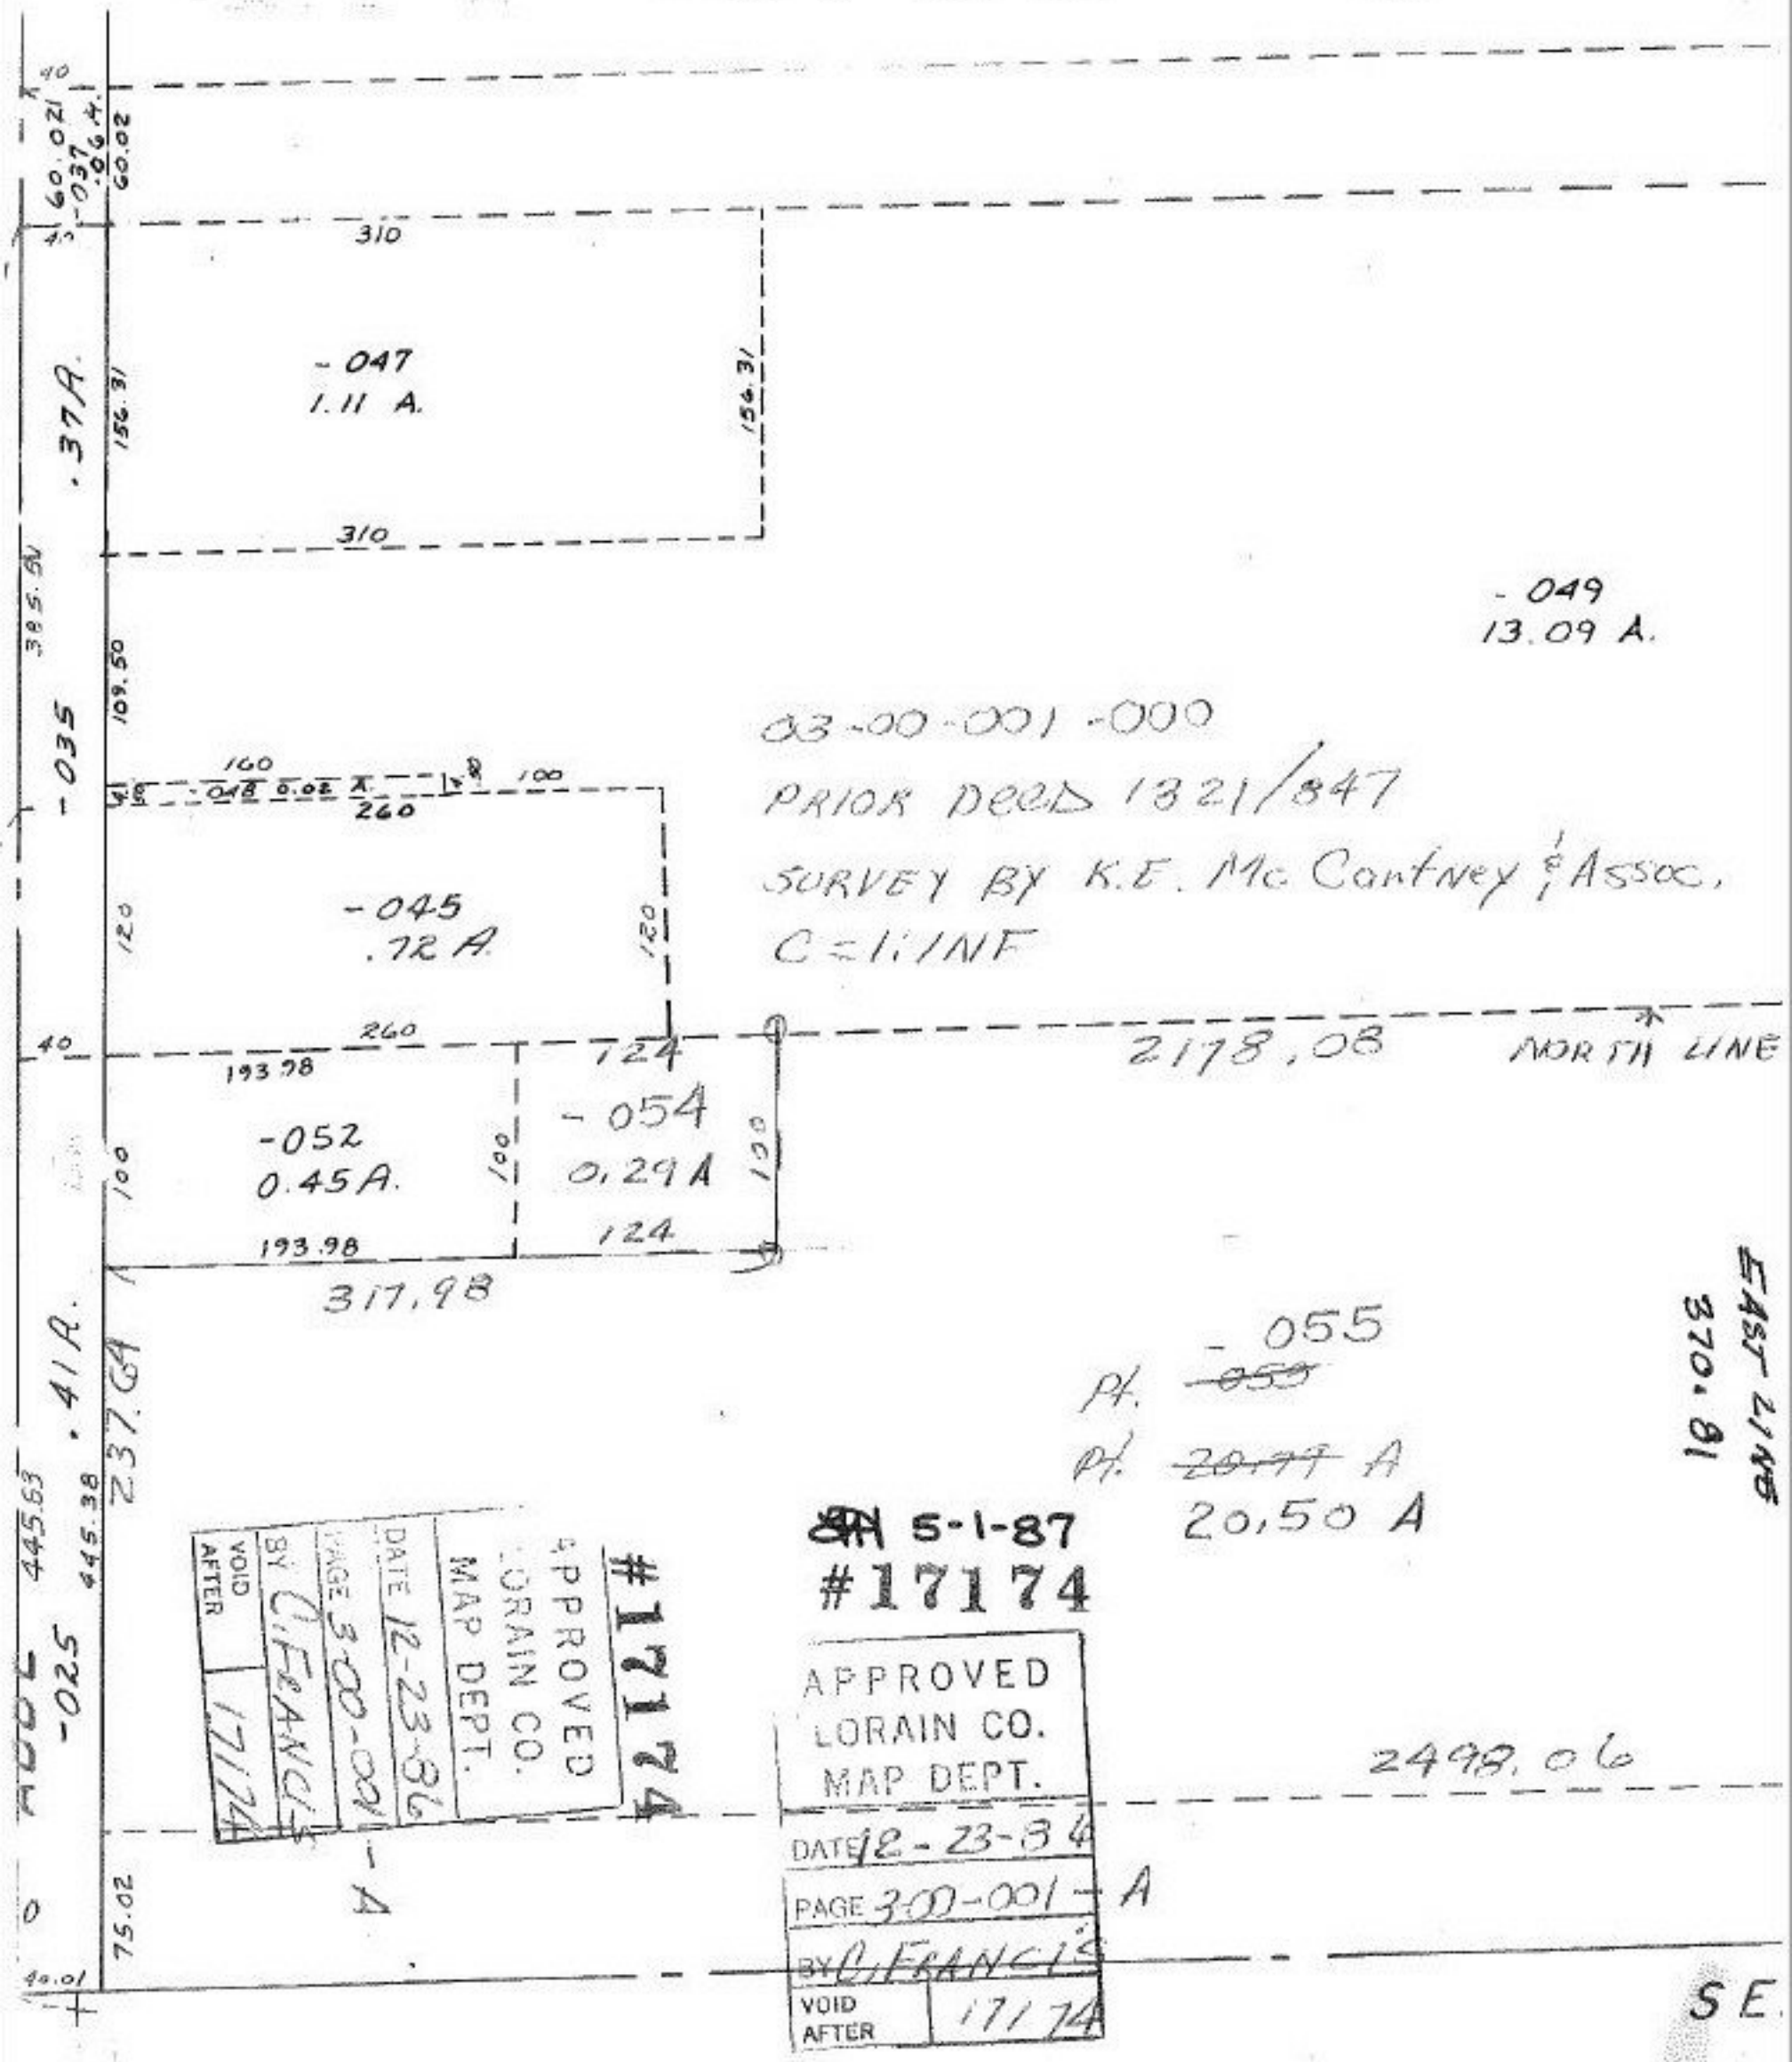

-047
1.11 A.
310
156.31
.37A.
-049
13.09 A.
03-00-001-000
PRIOR DEED 1321/847
SURVEY BY K.E. McCartney & Assoc.
C=1:INF
-035
160
100
260
-045
.72 A.
120
2178.08
NORTH LINE
-052
0.45A.
-054
0.29 A
124
193.98
317.98
.41A.
237.64
-055
Pt. ~~-053~~
Pt. ~~20.77~~ A
20.50 A
EAST LINE
370.81
5-1-87
#17174
APPROVED
LORAIN CO.
MAP DEPT.
DATE 12-23-86
PAGE 3-00-001-A
BY C. FRANCIS
VOID AFTER 17174
2498.06
-025
445.63
445.38
75.02
40.01
SE.